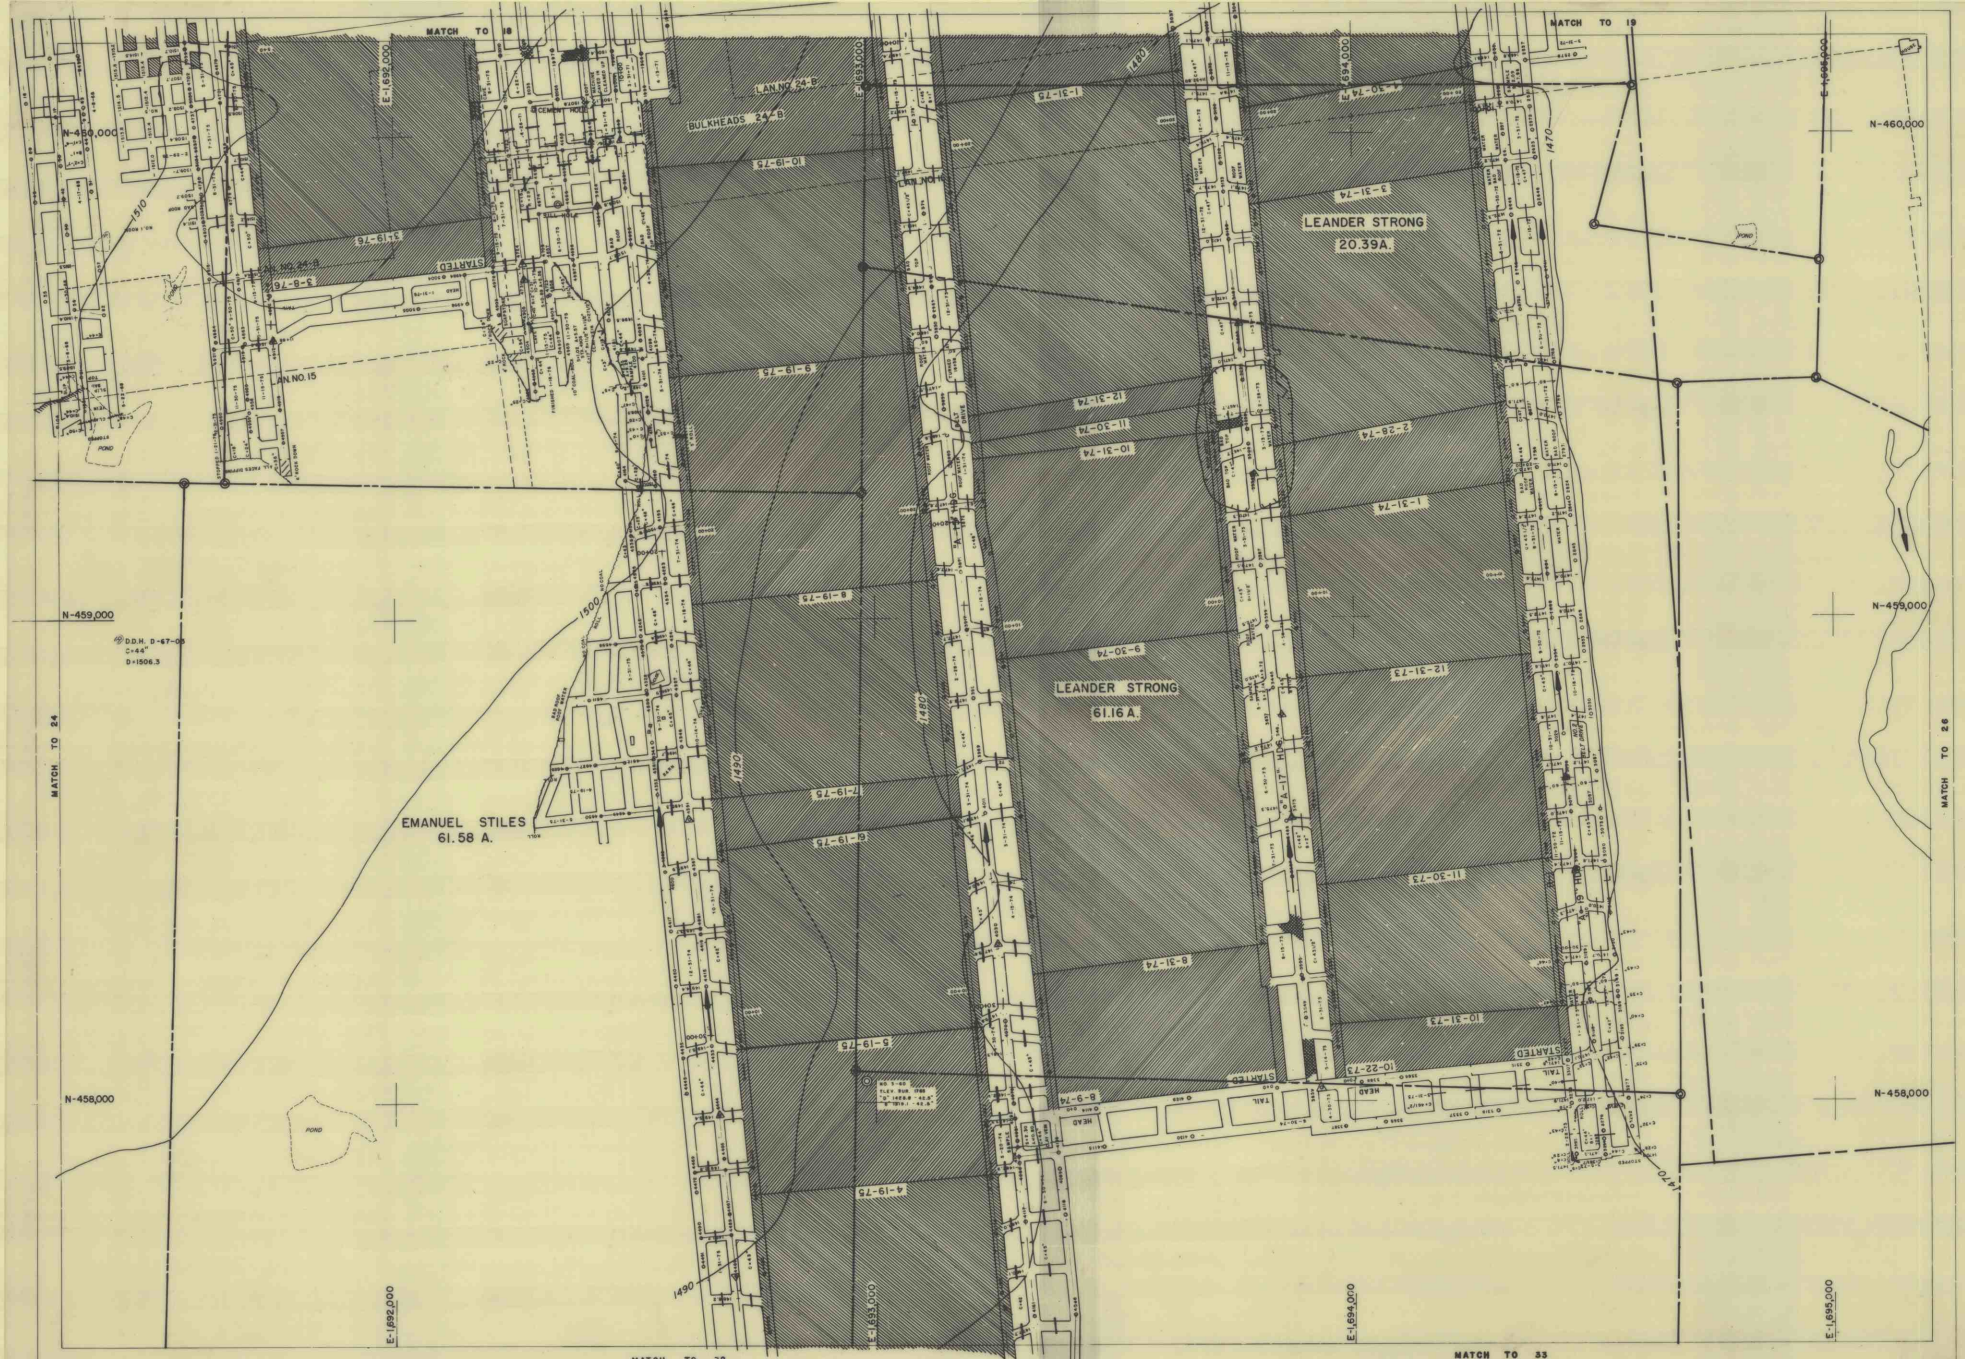
MATCH TO 18
MATCH TO 19
MATCH TO 24
MATCH TO 26
MATCH TO 32
MATCH TO 33
N-460,000
N-459,000
N-458,000
E-1,692,000
E-1,693,000
E-1,694,000
E-1,695,000
BULKHEADS 24-B
LAN. NO. 24-B
LAN. NO. 15
STARTED
LEANDER STRONG
20.39A.
LEANDER STRONG
61.16 A.
EMANUEL STILES
61.58 A.
D.D.H. D-67-05
C=44"
D=1506.3
1510
1500
1490
1480
1470
1-31-75
10-19-75
3-31-74
3-15-75
3-8-76
9-19-75
12-31-74
11-30-74
10-31-74
2-28-74
1-31-74
8-19-75
9-30-74
12-31-73
7-19-75
6-19-75
11-30-73
8-31-74
10-31-73
5-19-75
10-22-73
8-9-74
4-19-75
24"D" SEAM
25