


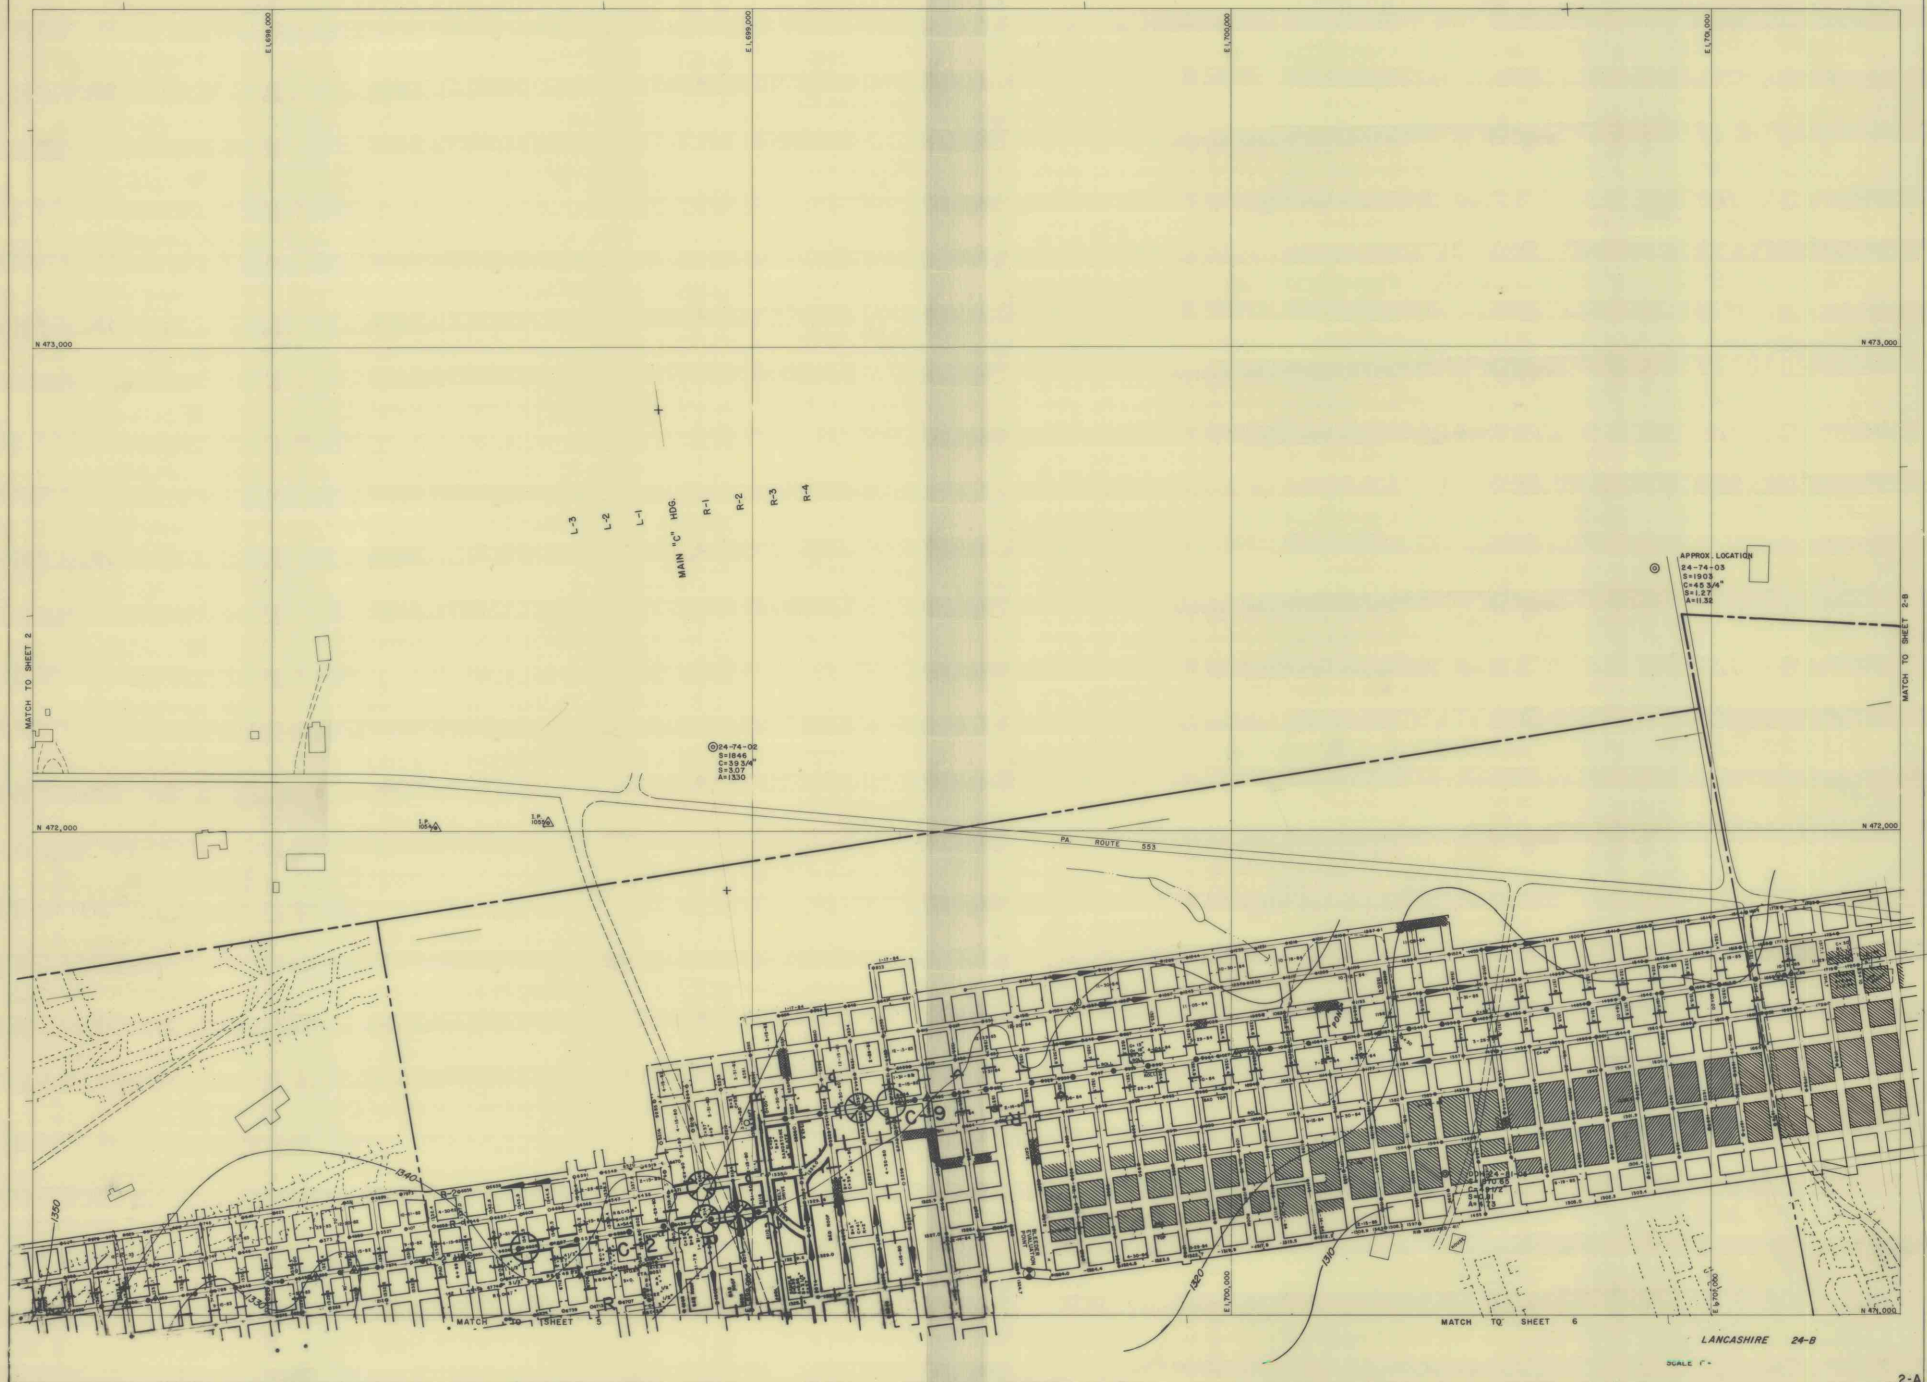

APPROX. LOCATION
24-74-03
C=45.3/A
S=1.27
A=11.32

© 24-74-02

LANCASHIRE 24-B

SCALE 1"