


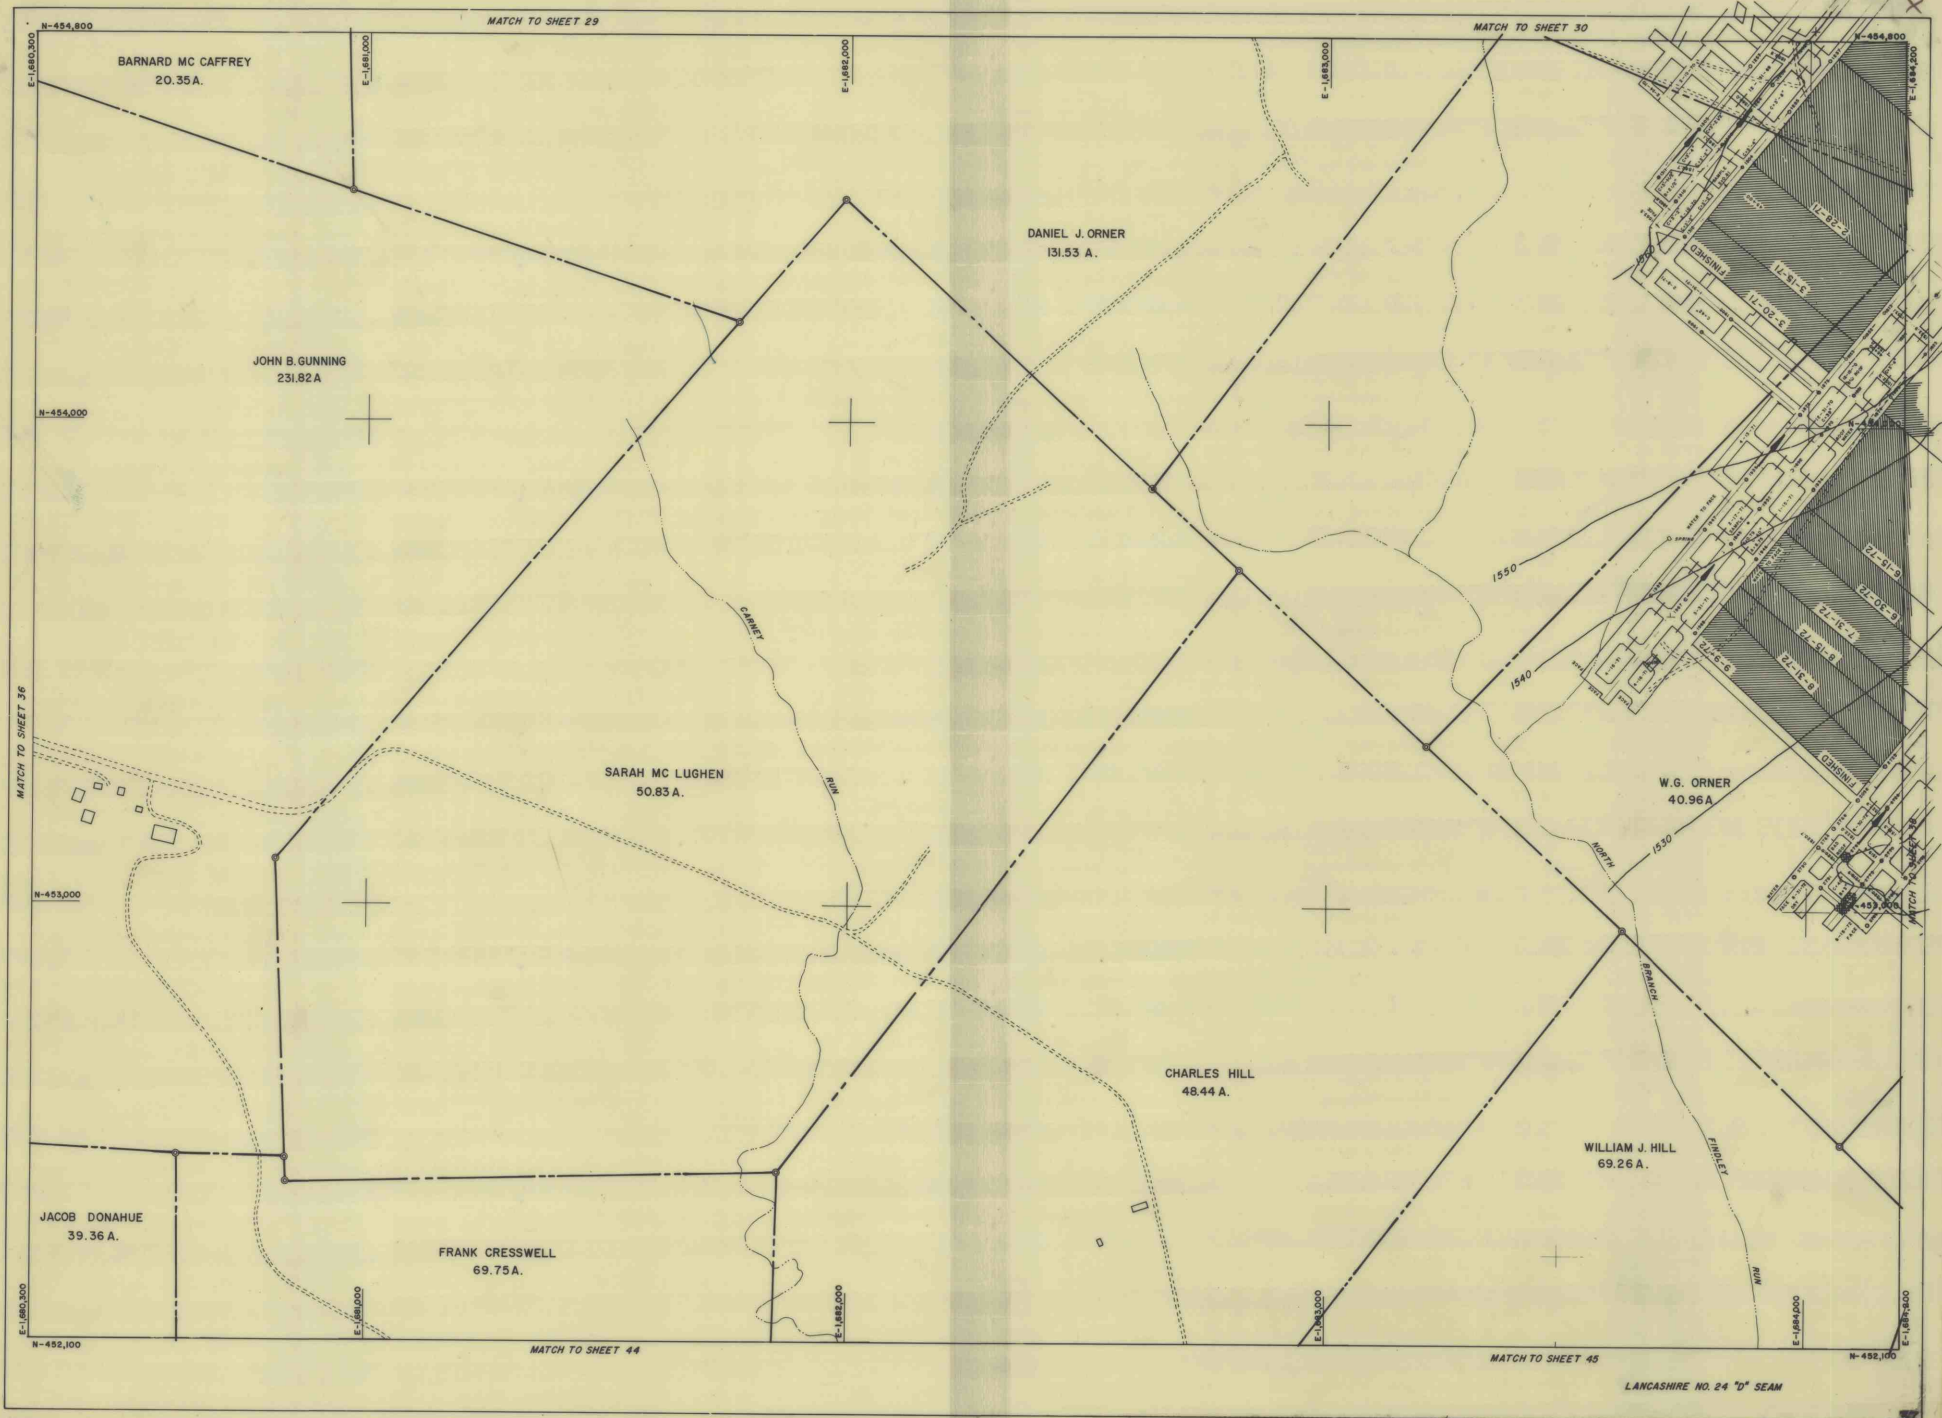

N-454,800
BARNARD MC CAFFREY
20.35 A.
MATCH TO SHEET 29
DANIEL J. ORNER
131.53 A.
MATCH TO SHEET 30
JOHN B. GUNNING
231.82 A.
N-454,000
SARAH MC LUGHEN
50.83 A.
N-453,000
JACOB DONAHUE
39.36 A.
MATCH TO SHEET 44
FRANK CRESSWELL
69.75 A.
CHARLES HILL
48.44 A.
W.G. ORNER
40.96 A.
WILLIAM J. HILL
69.26 A.
N-452,100
MATCH TO SHEET 45
LANCASHIRE NO. 24 "D" SEAM