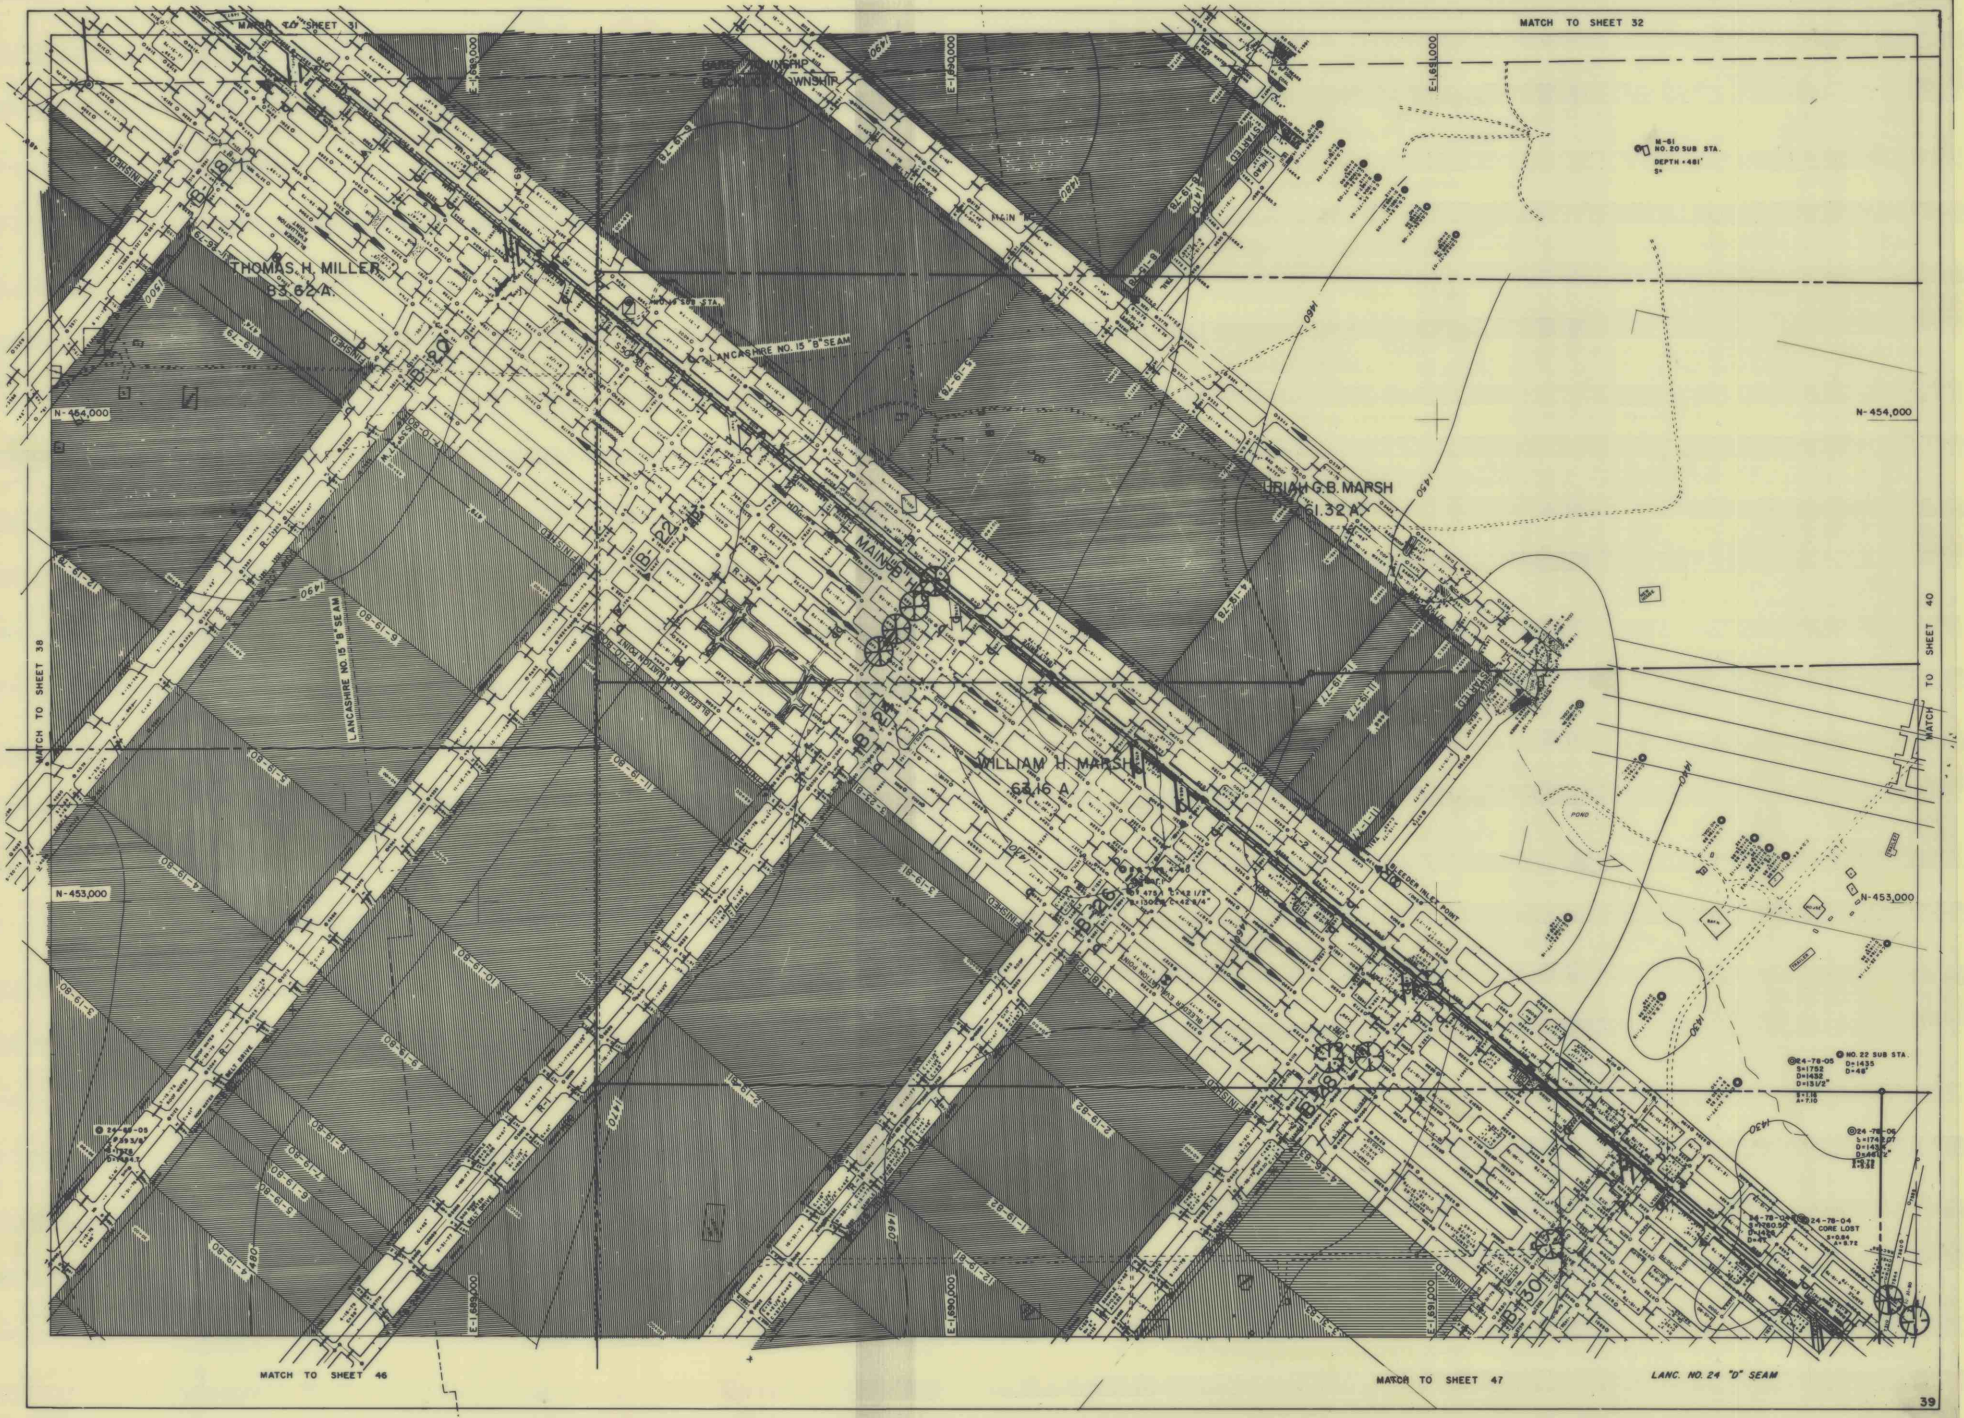
MATCH TO SHEET 31
MATCH TO SHEET 32
MATCH TO SHEET 38
MATCH TO SHEET 40
MATCH TO SHEET 46
MATCH TO SHEET 47
THOMAS H. MILLER
83.62 A.
URIAH G.B. MARSH
61.32 A.
WILLIAM H. MARSH
63.16 A.
LANCASHIRE NO. 15 "B" SEAM
LANC. NO. 24 "D" SEAM
MAIN ST.
N-464,000
N-454,000
N-453,000
E-1,690,000
E-1,695,000
M-61
NO. 20 SUB STA.
DEPTH +481'
NO. 22 SUB STA.
CORE LOST
POND
39