


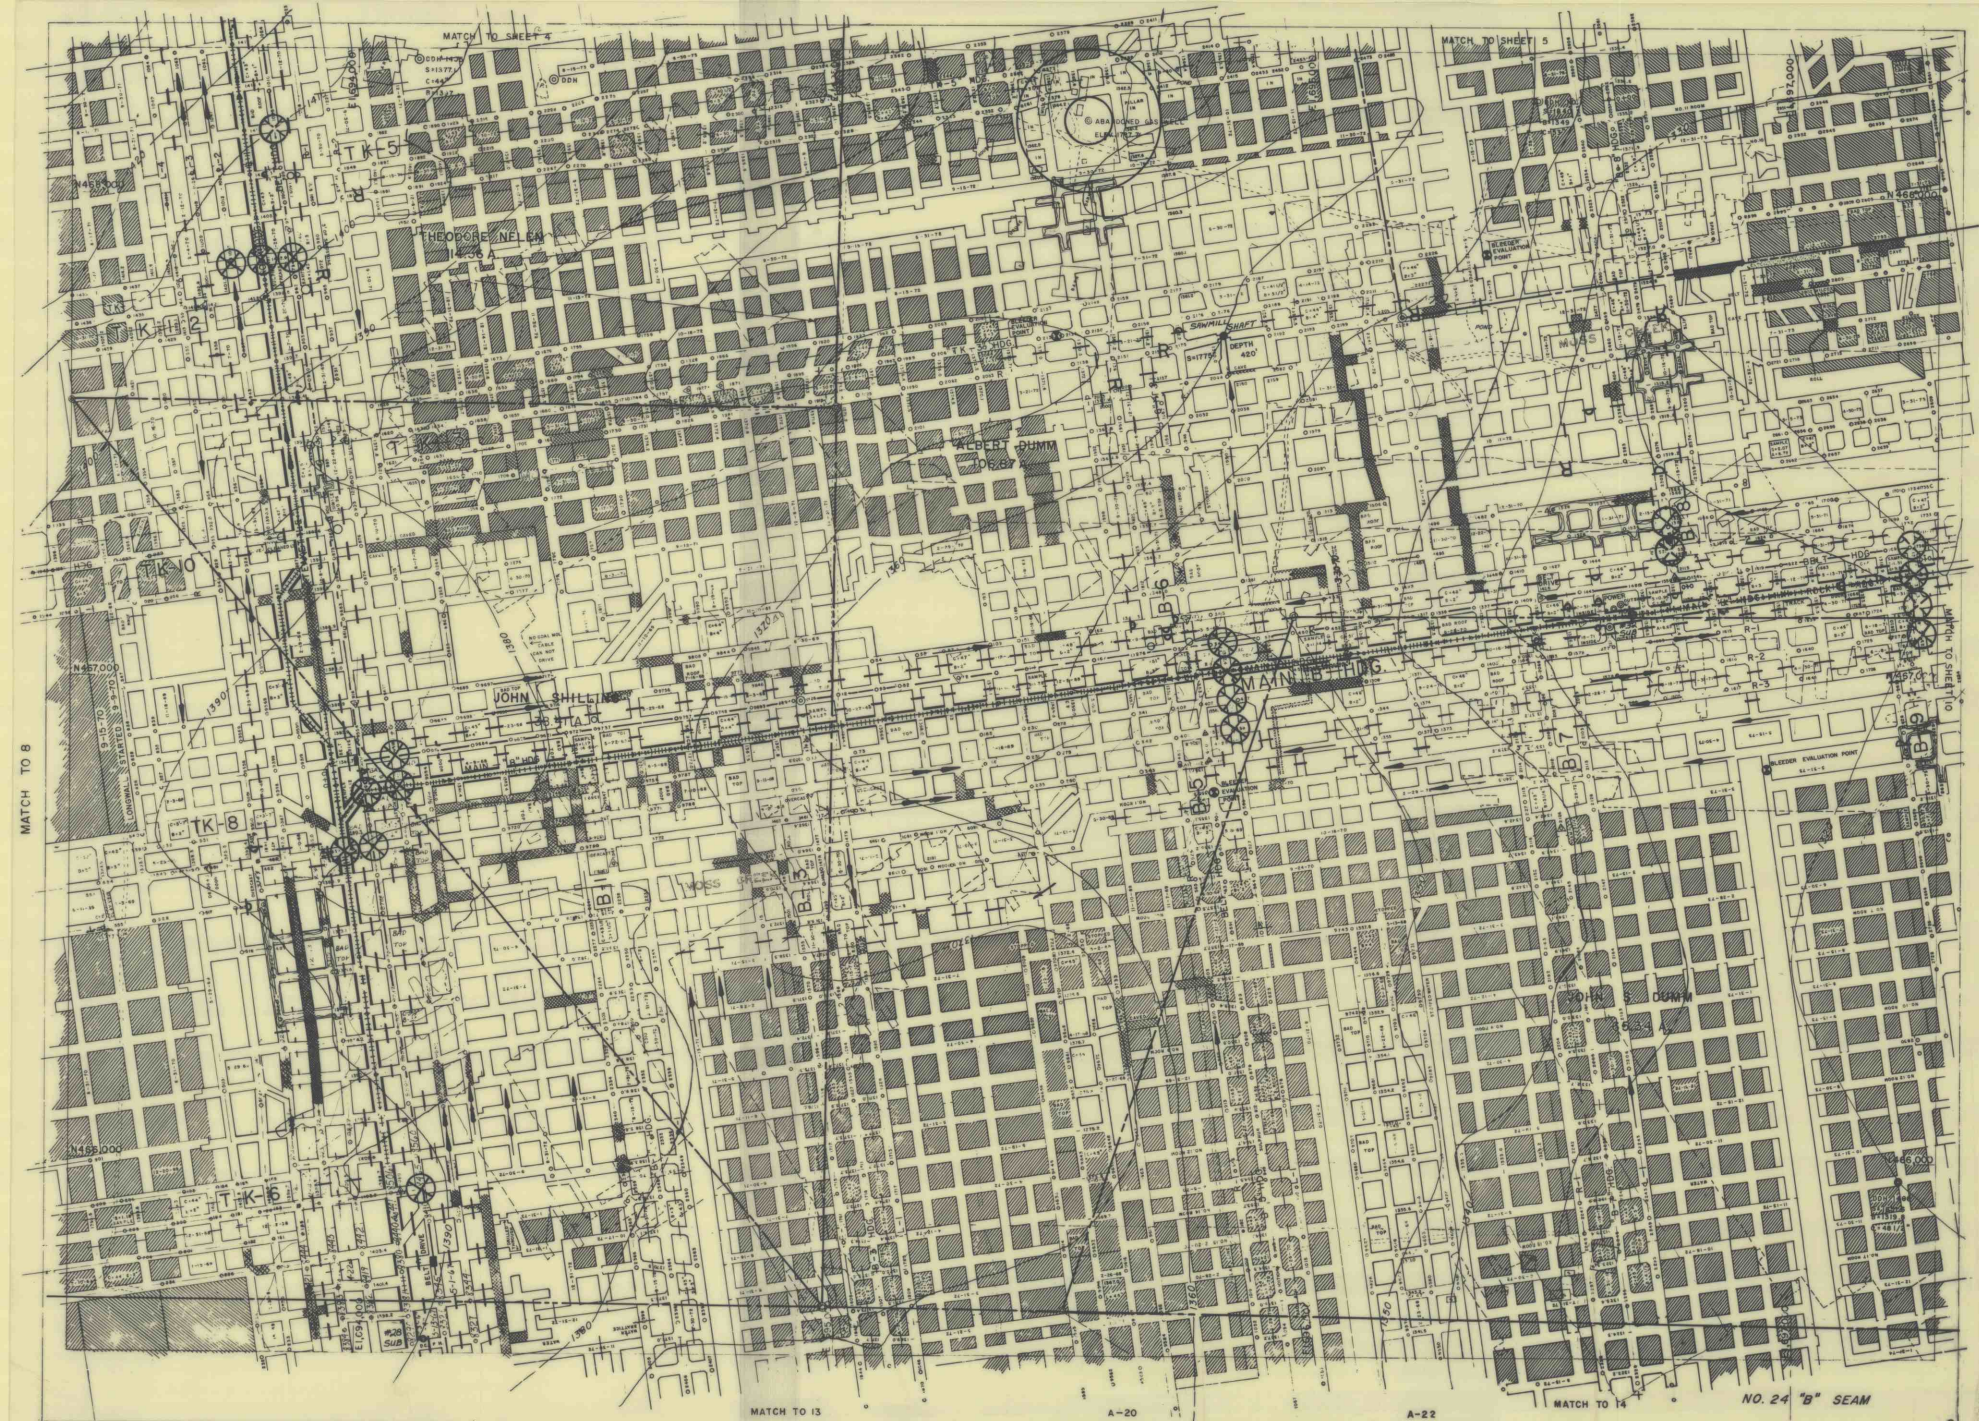

MATCH TO 8

MATCH TO SHEET 4

MATCH TO SHEET 5

MATCH TO 13

A-20

A-22

MATCH TO 14

NO. 24 "B" SEAM