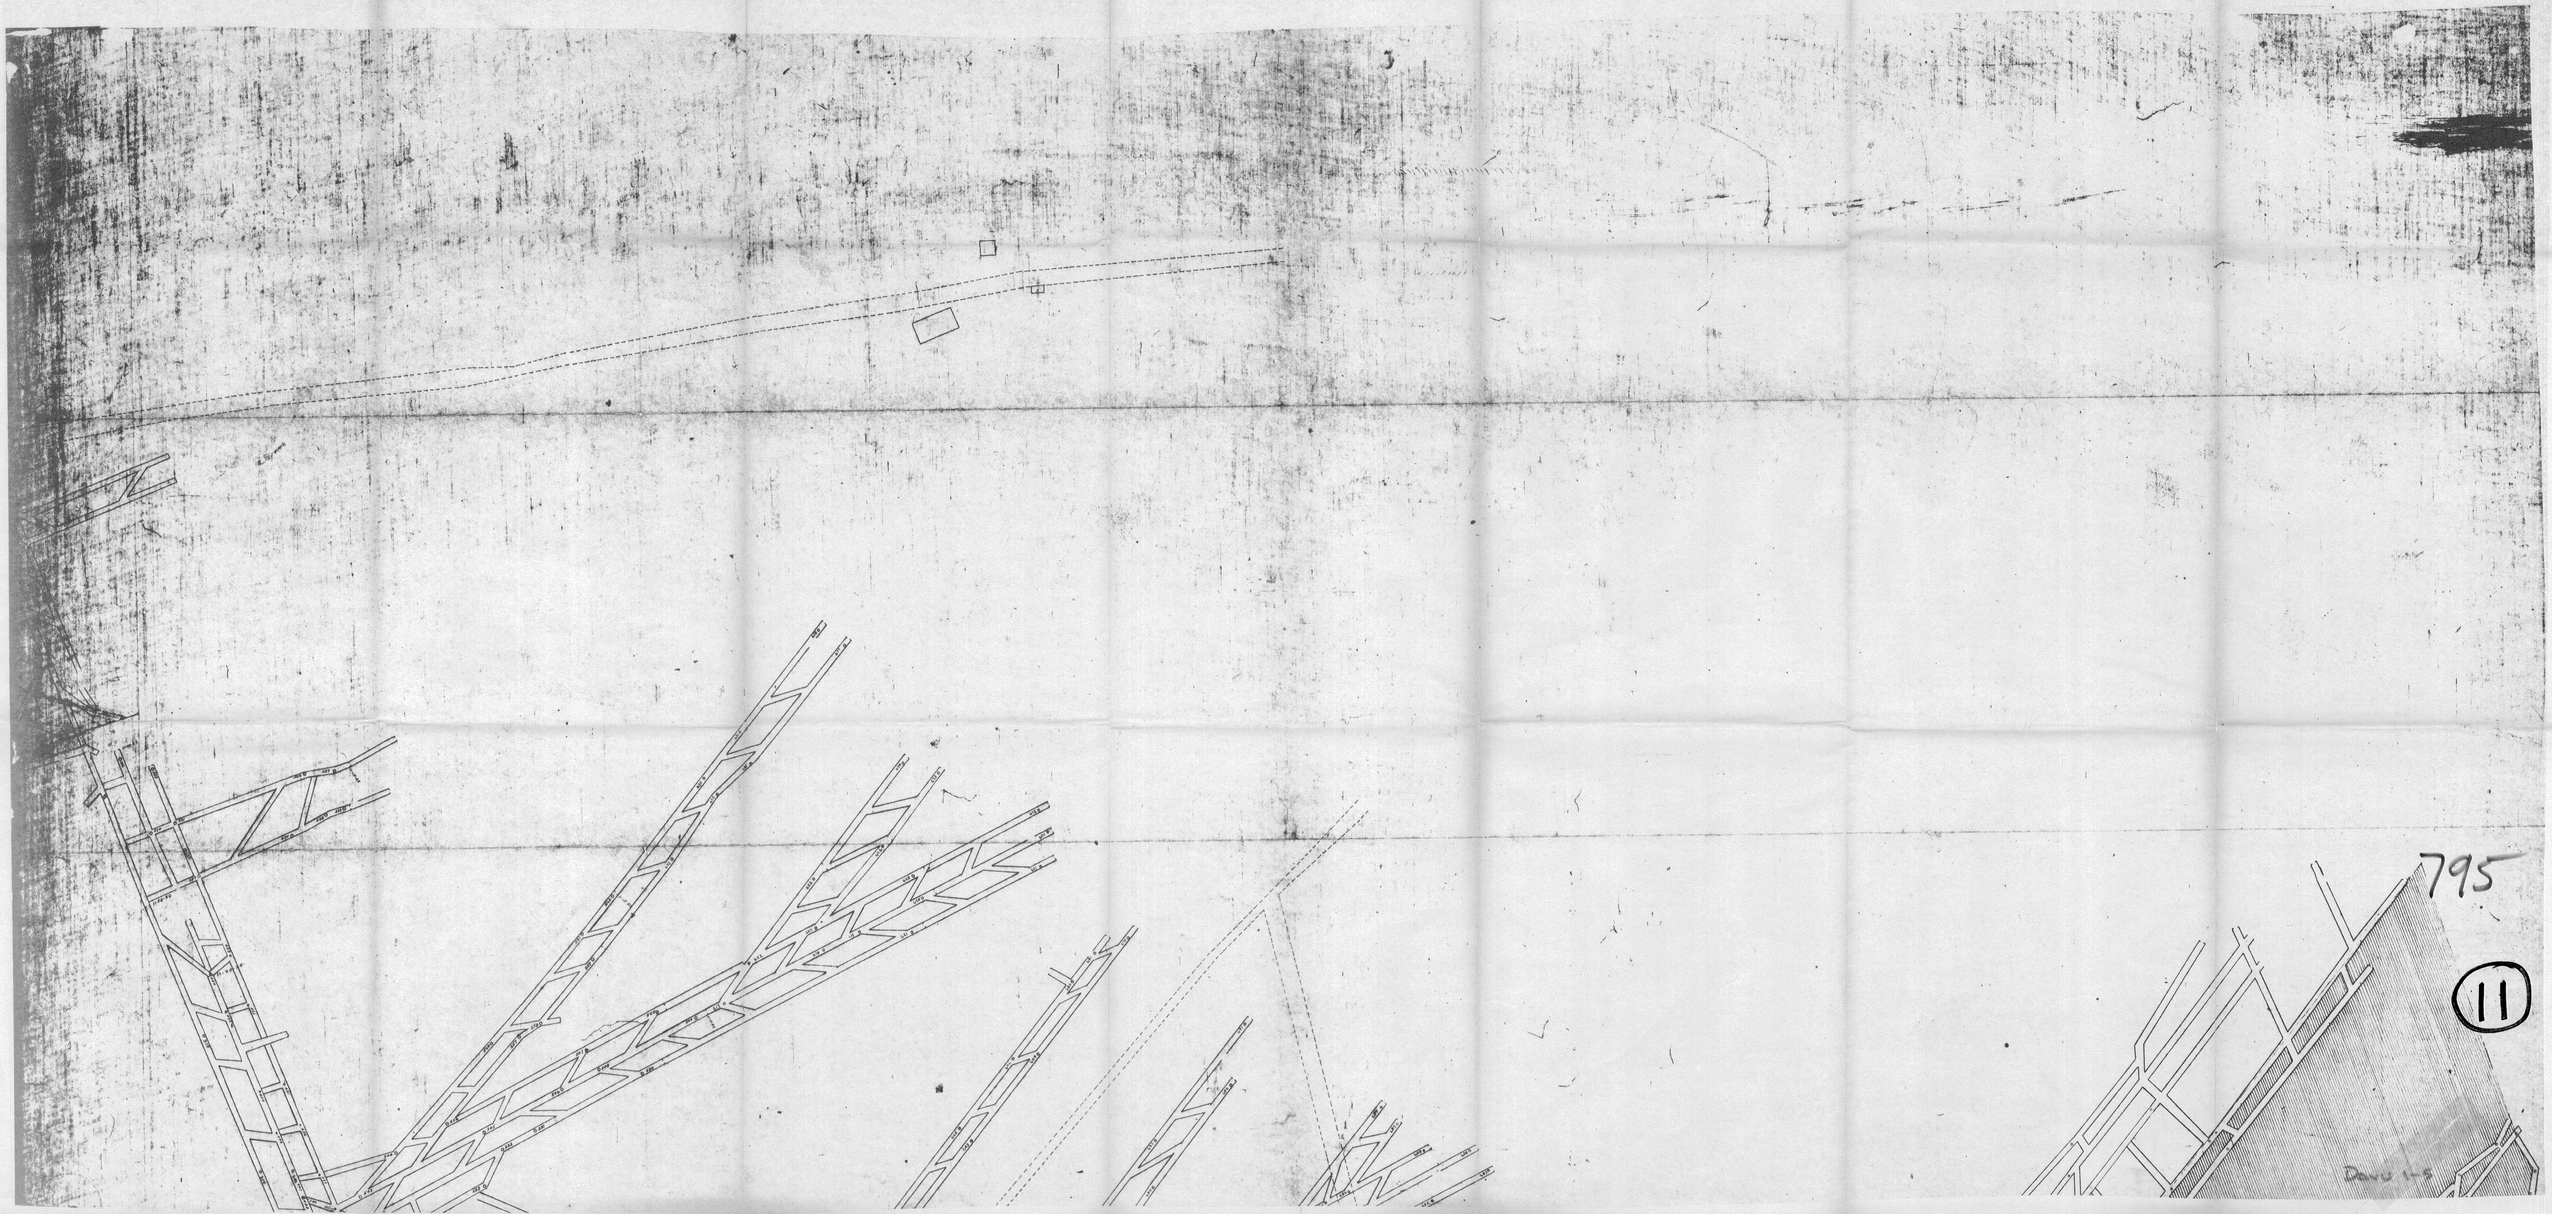

795
11