


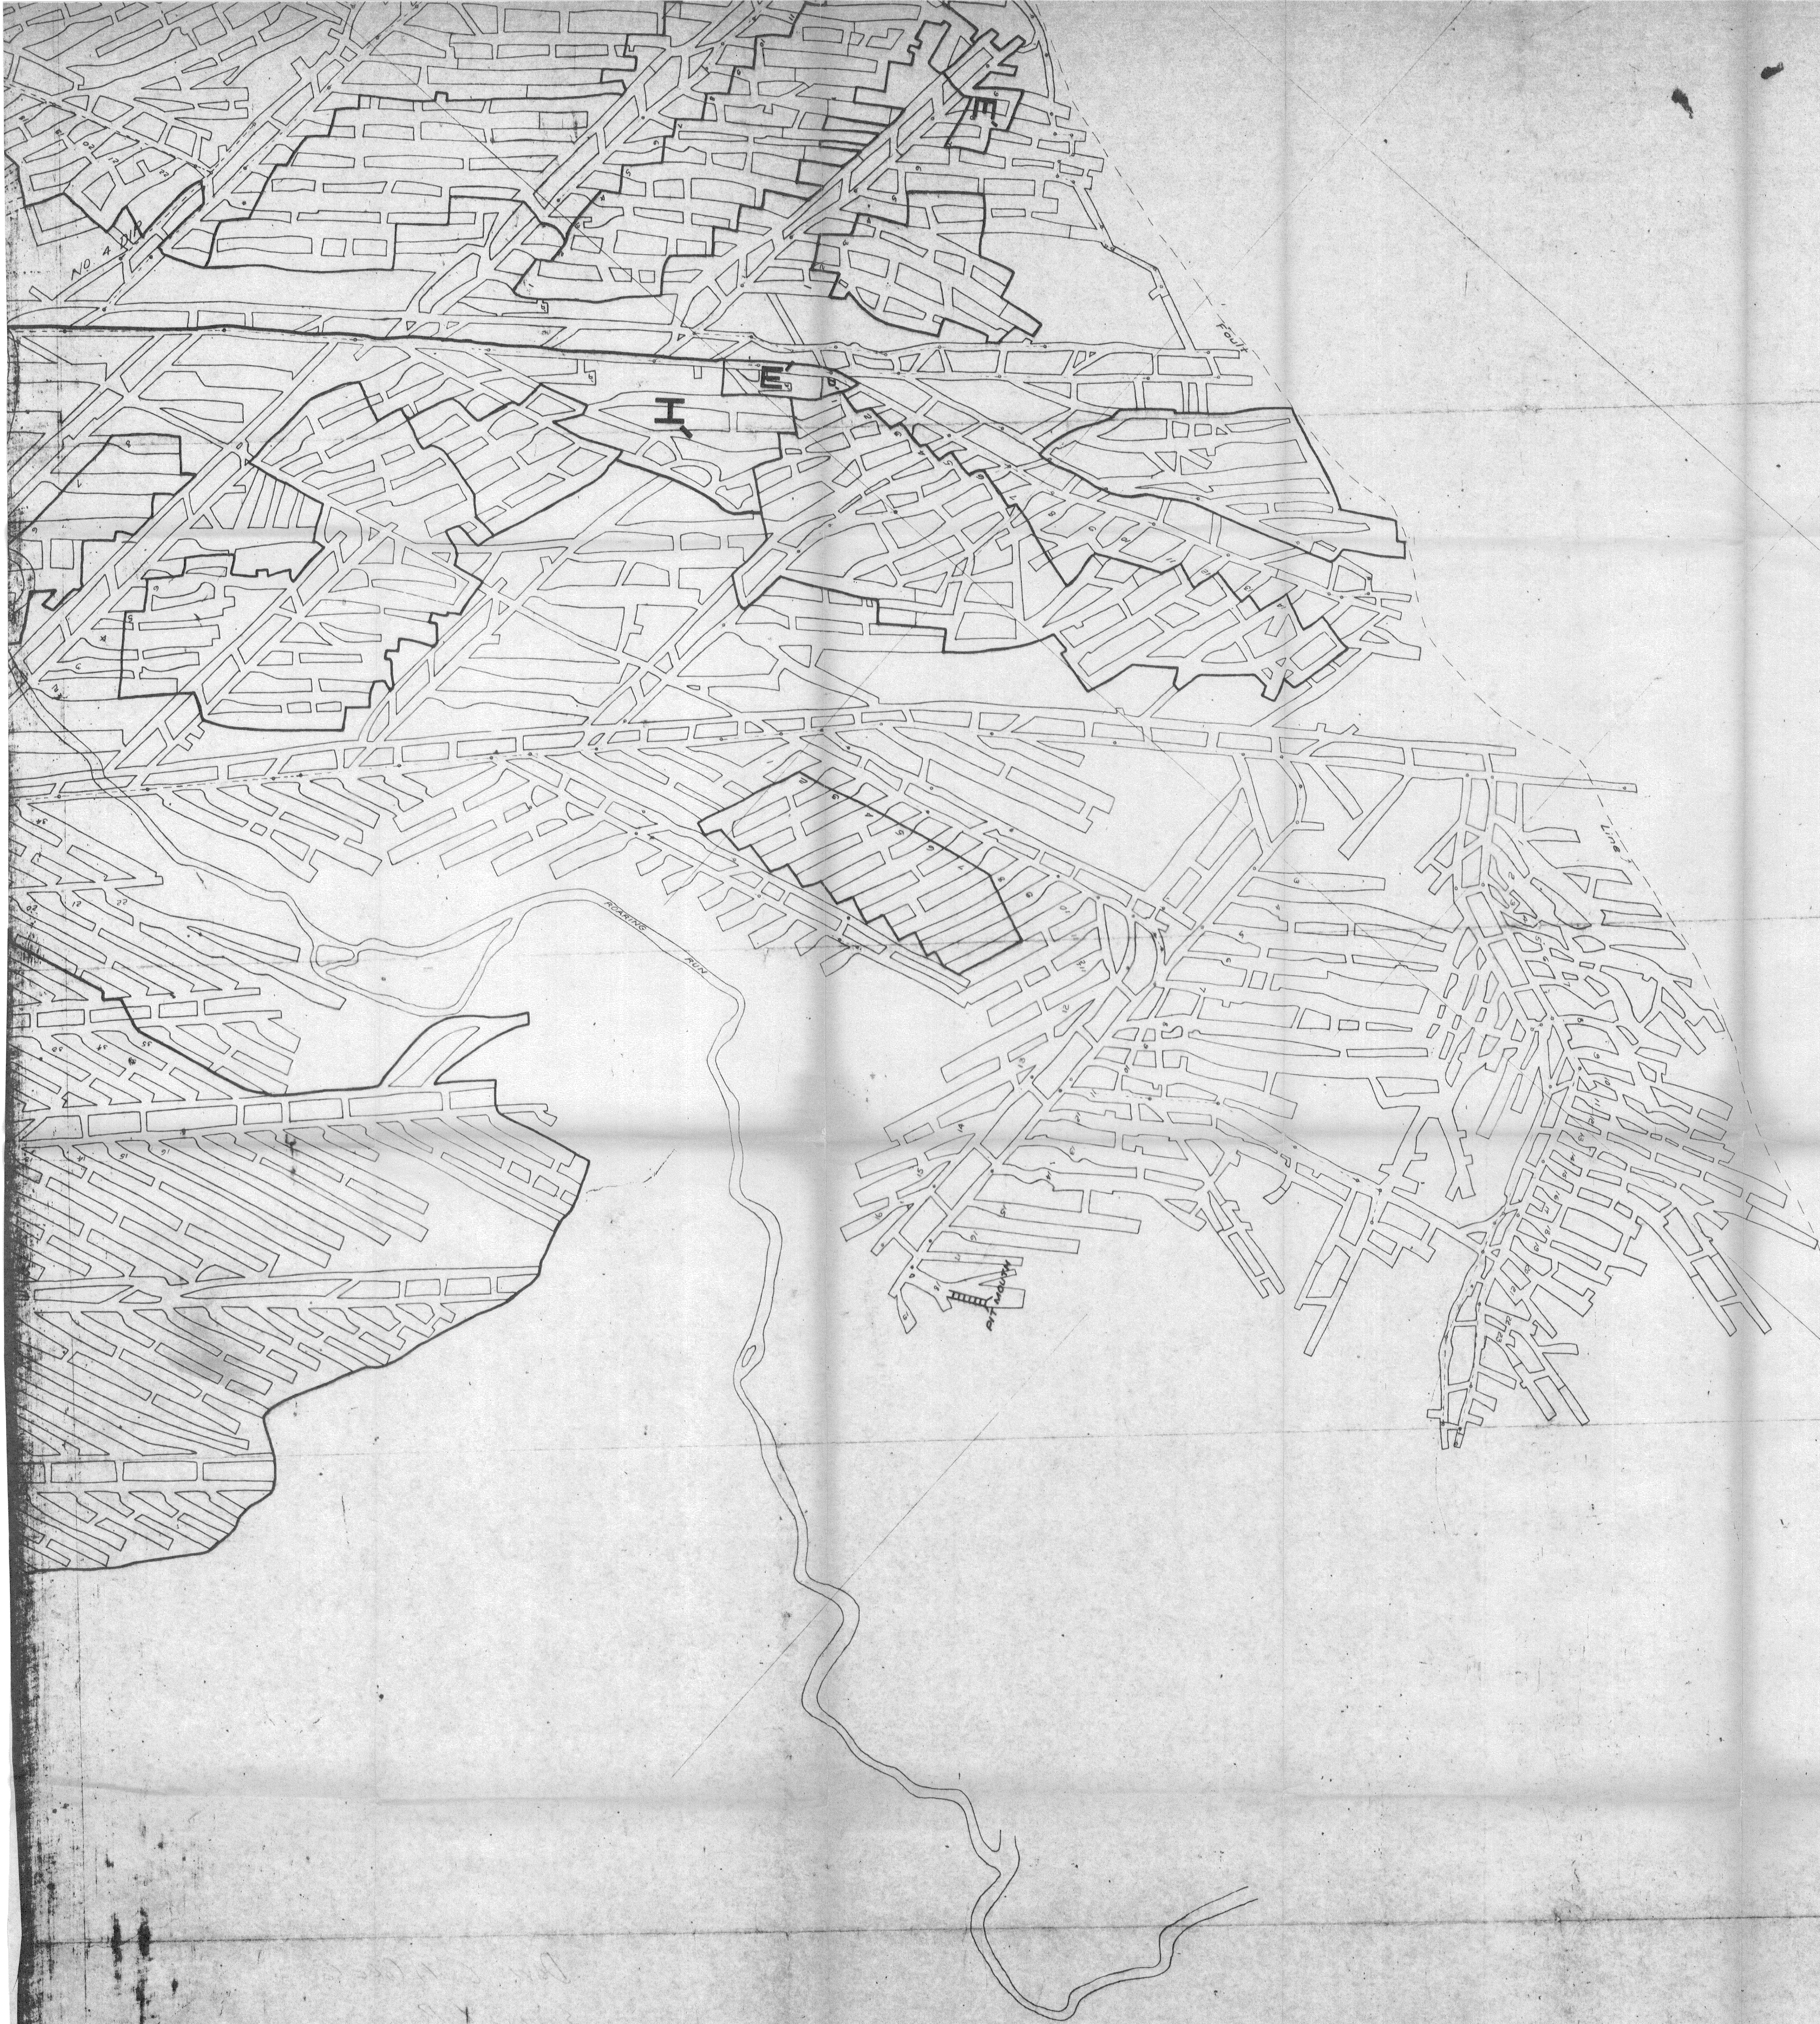

795

(12)