


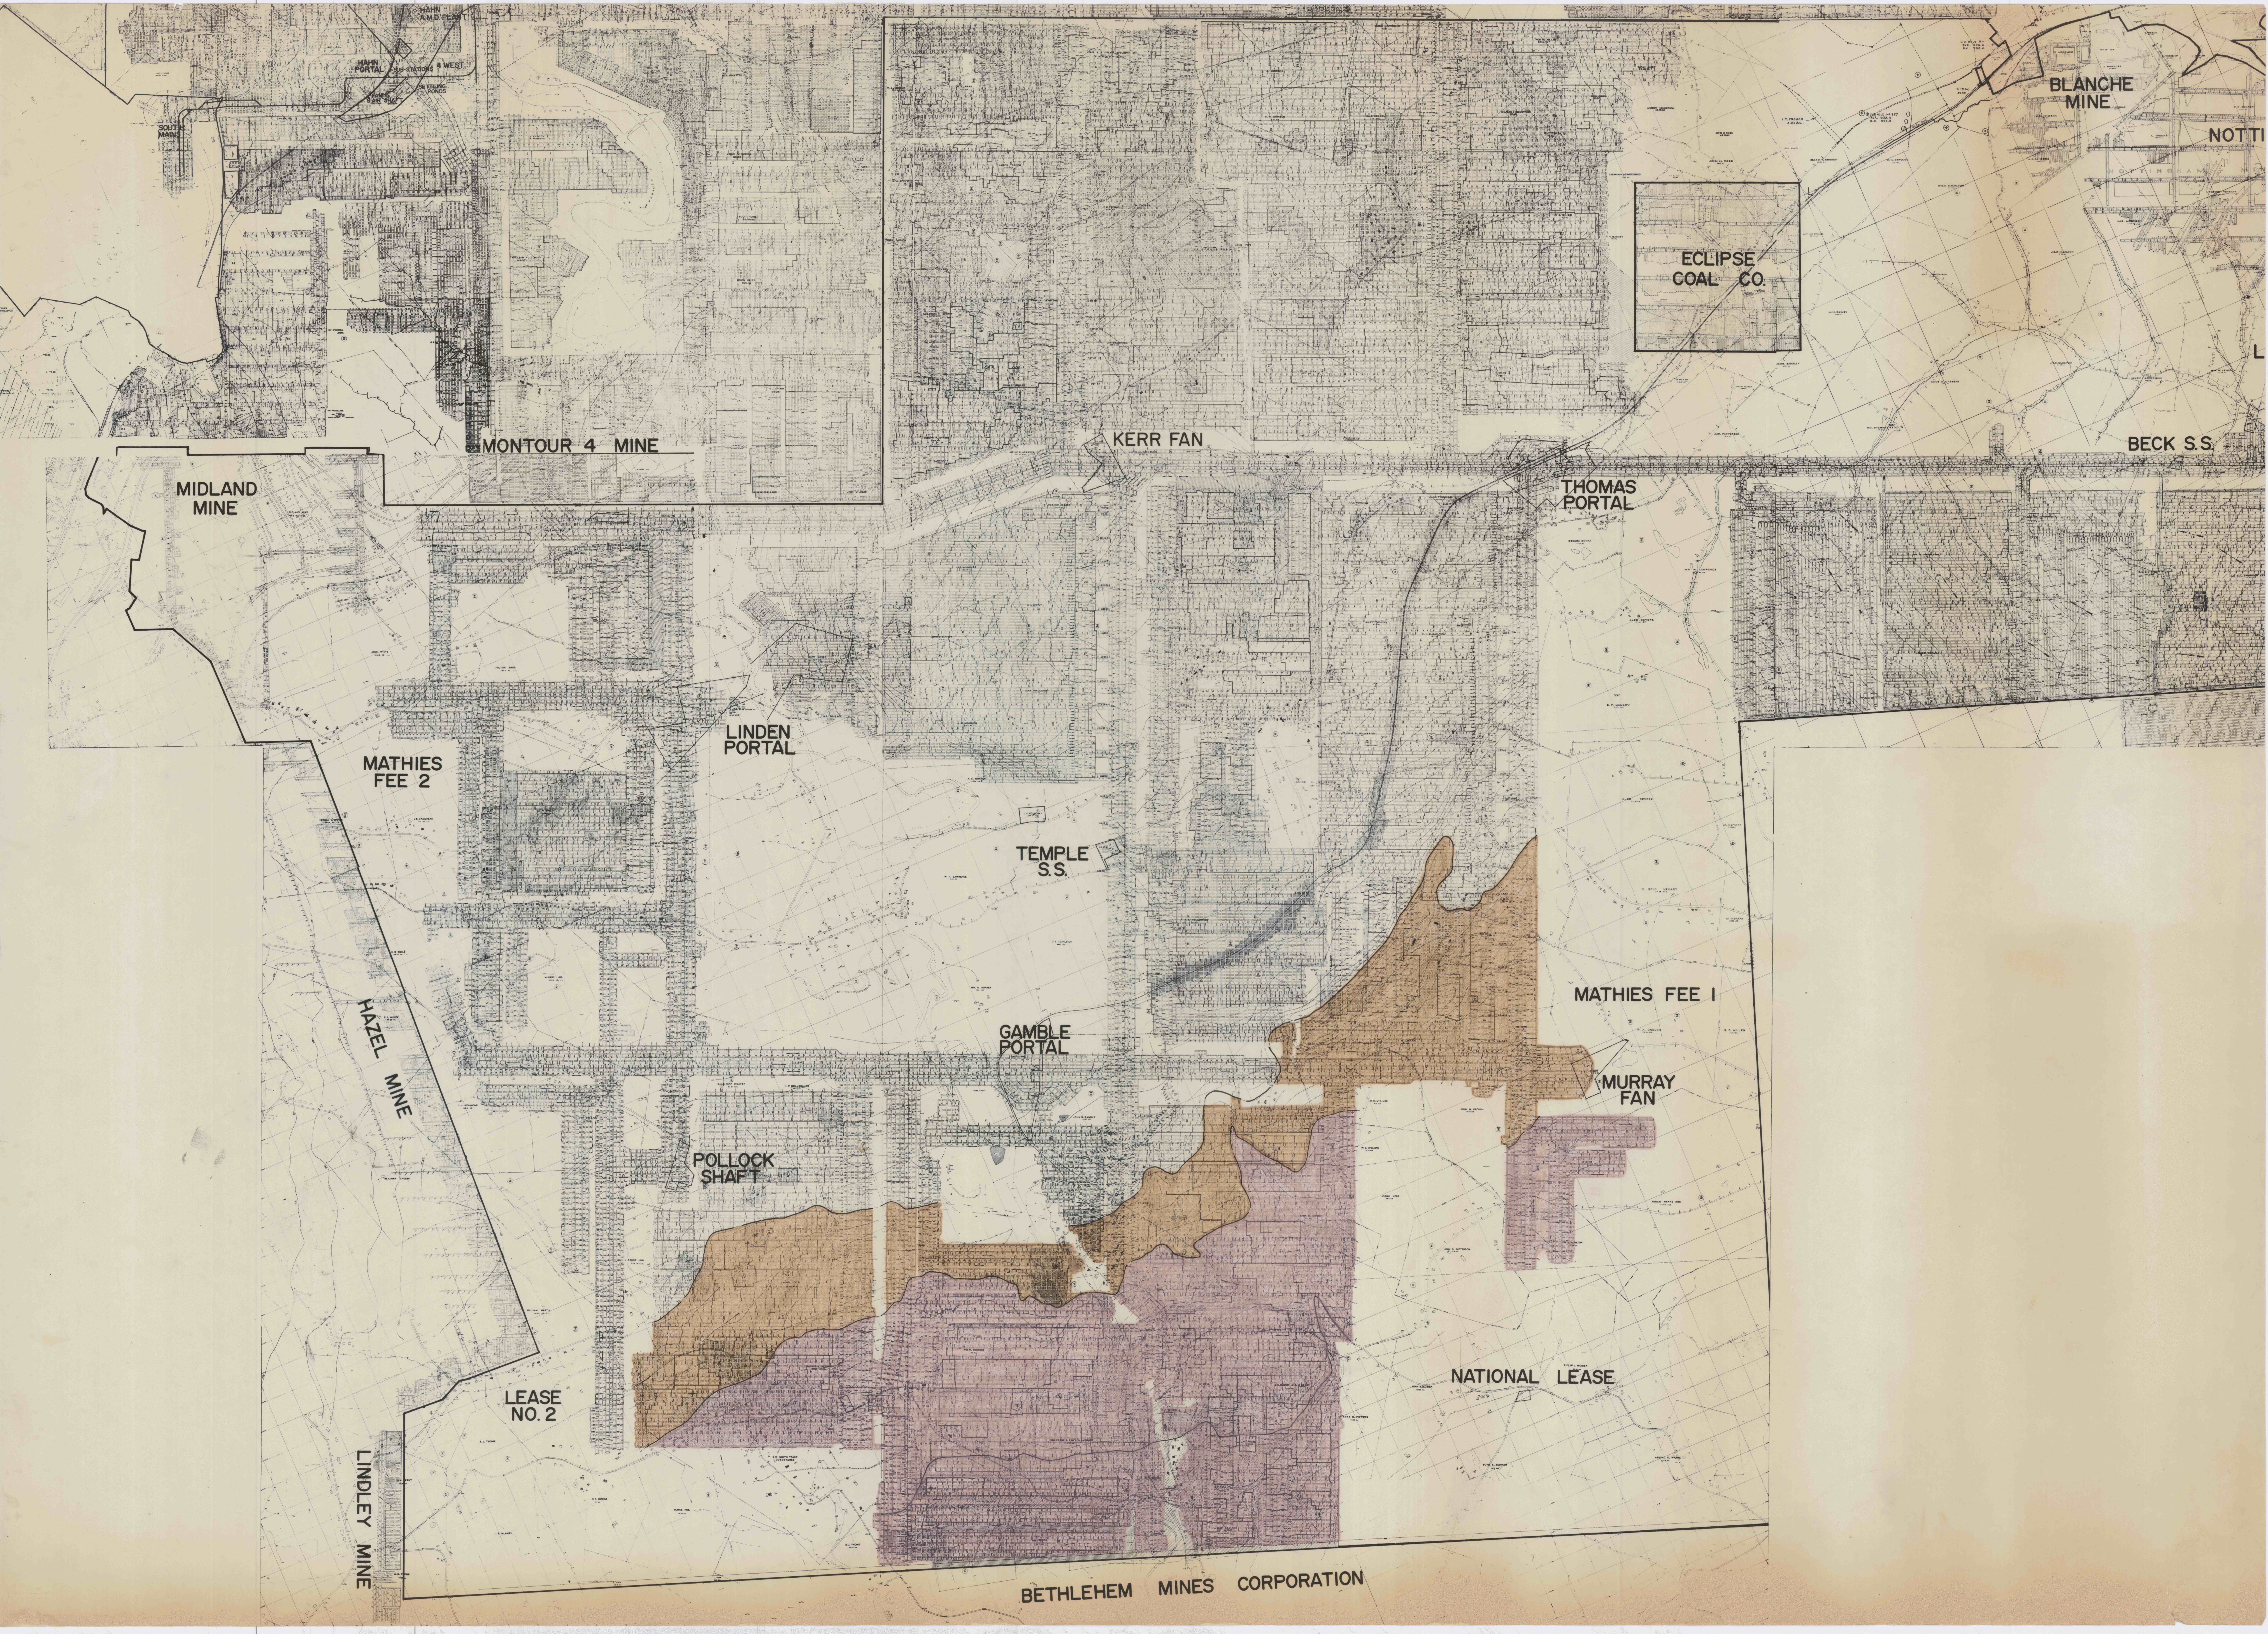

MIDLAND
MINE

MONTOUR 4 MINE

MATHIES
FEE 2

LINDEN
PORTAL

TEMPLE
S.S.

GAMBLE
PORTAL

POLLOCK
SHAFT

HAZEL
MINE

LEASE
NO. 2

LINDLEY
MINE

NATIONAL LEASE

MURRAY
FAN

MATHIES FEE 1

THOMAS
PORTAL

KERR FAN

ECLIPSE
COAL CO

BECK S.S.

BLANCHE
MINE

NOTTI

BETHLEHEM MINES CORPORATION