


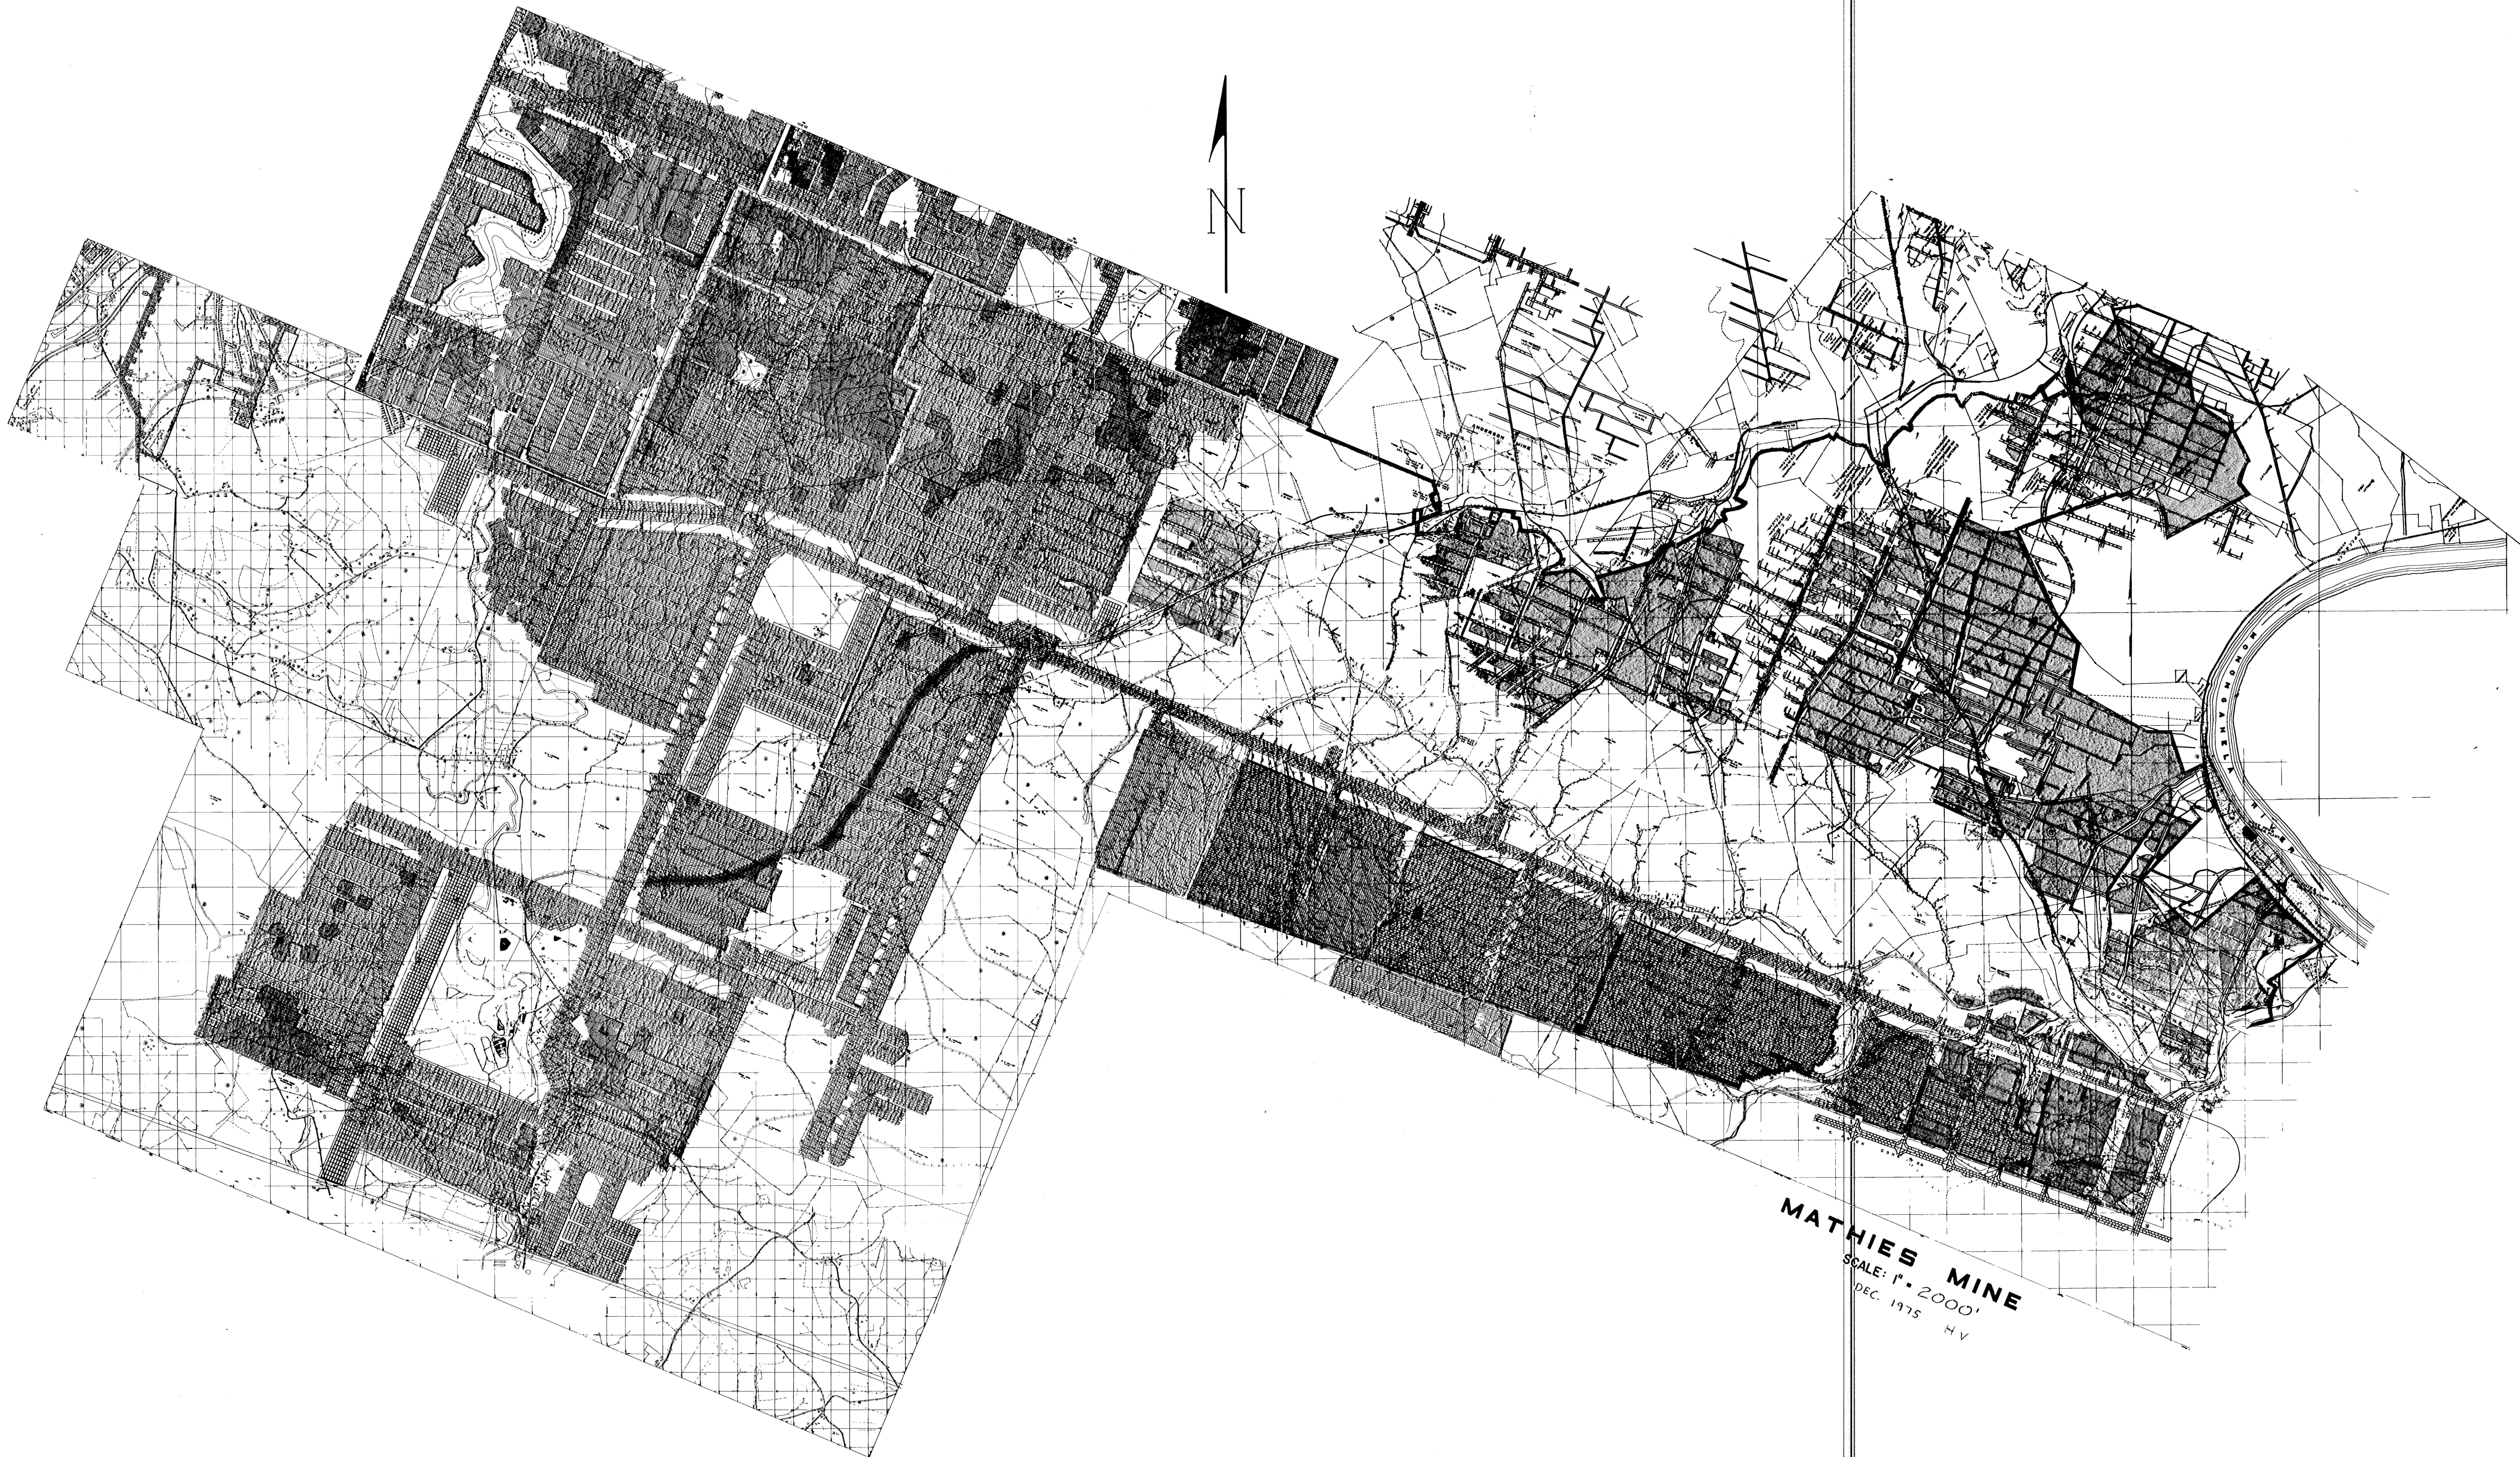

MATHIES MINE
SCALE: 1" = 2000'
DEC. 1975 H.V.