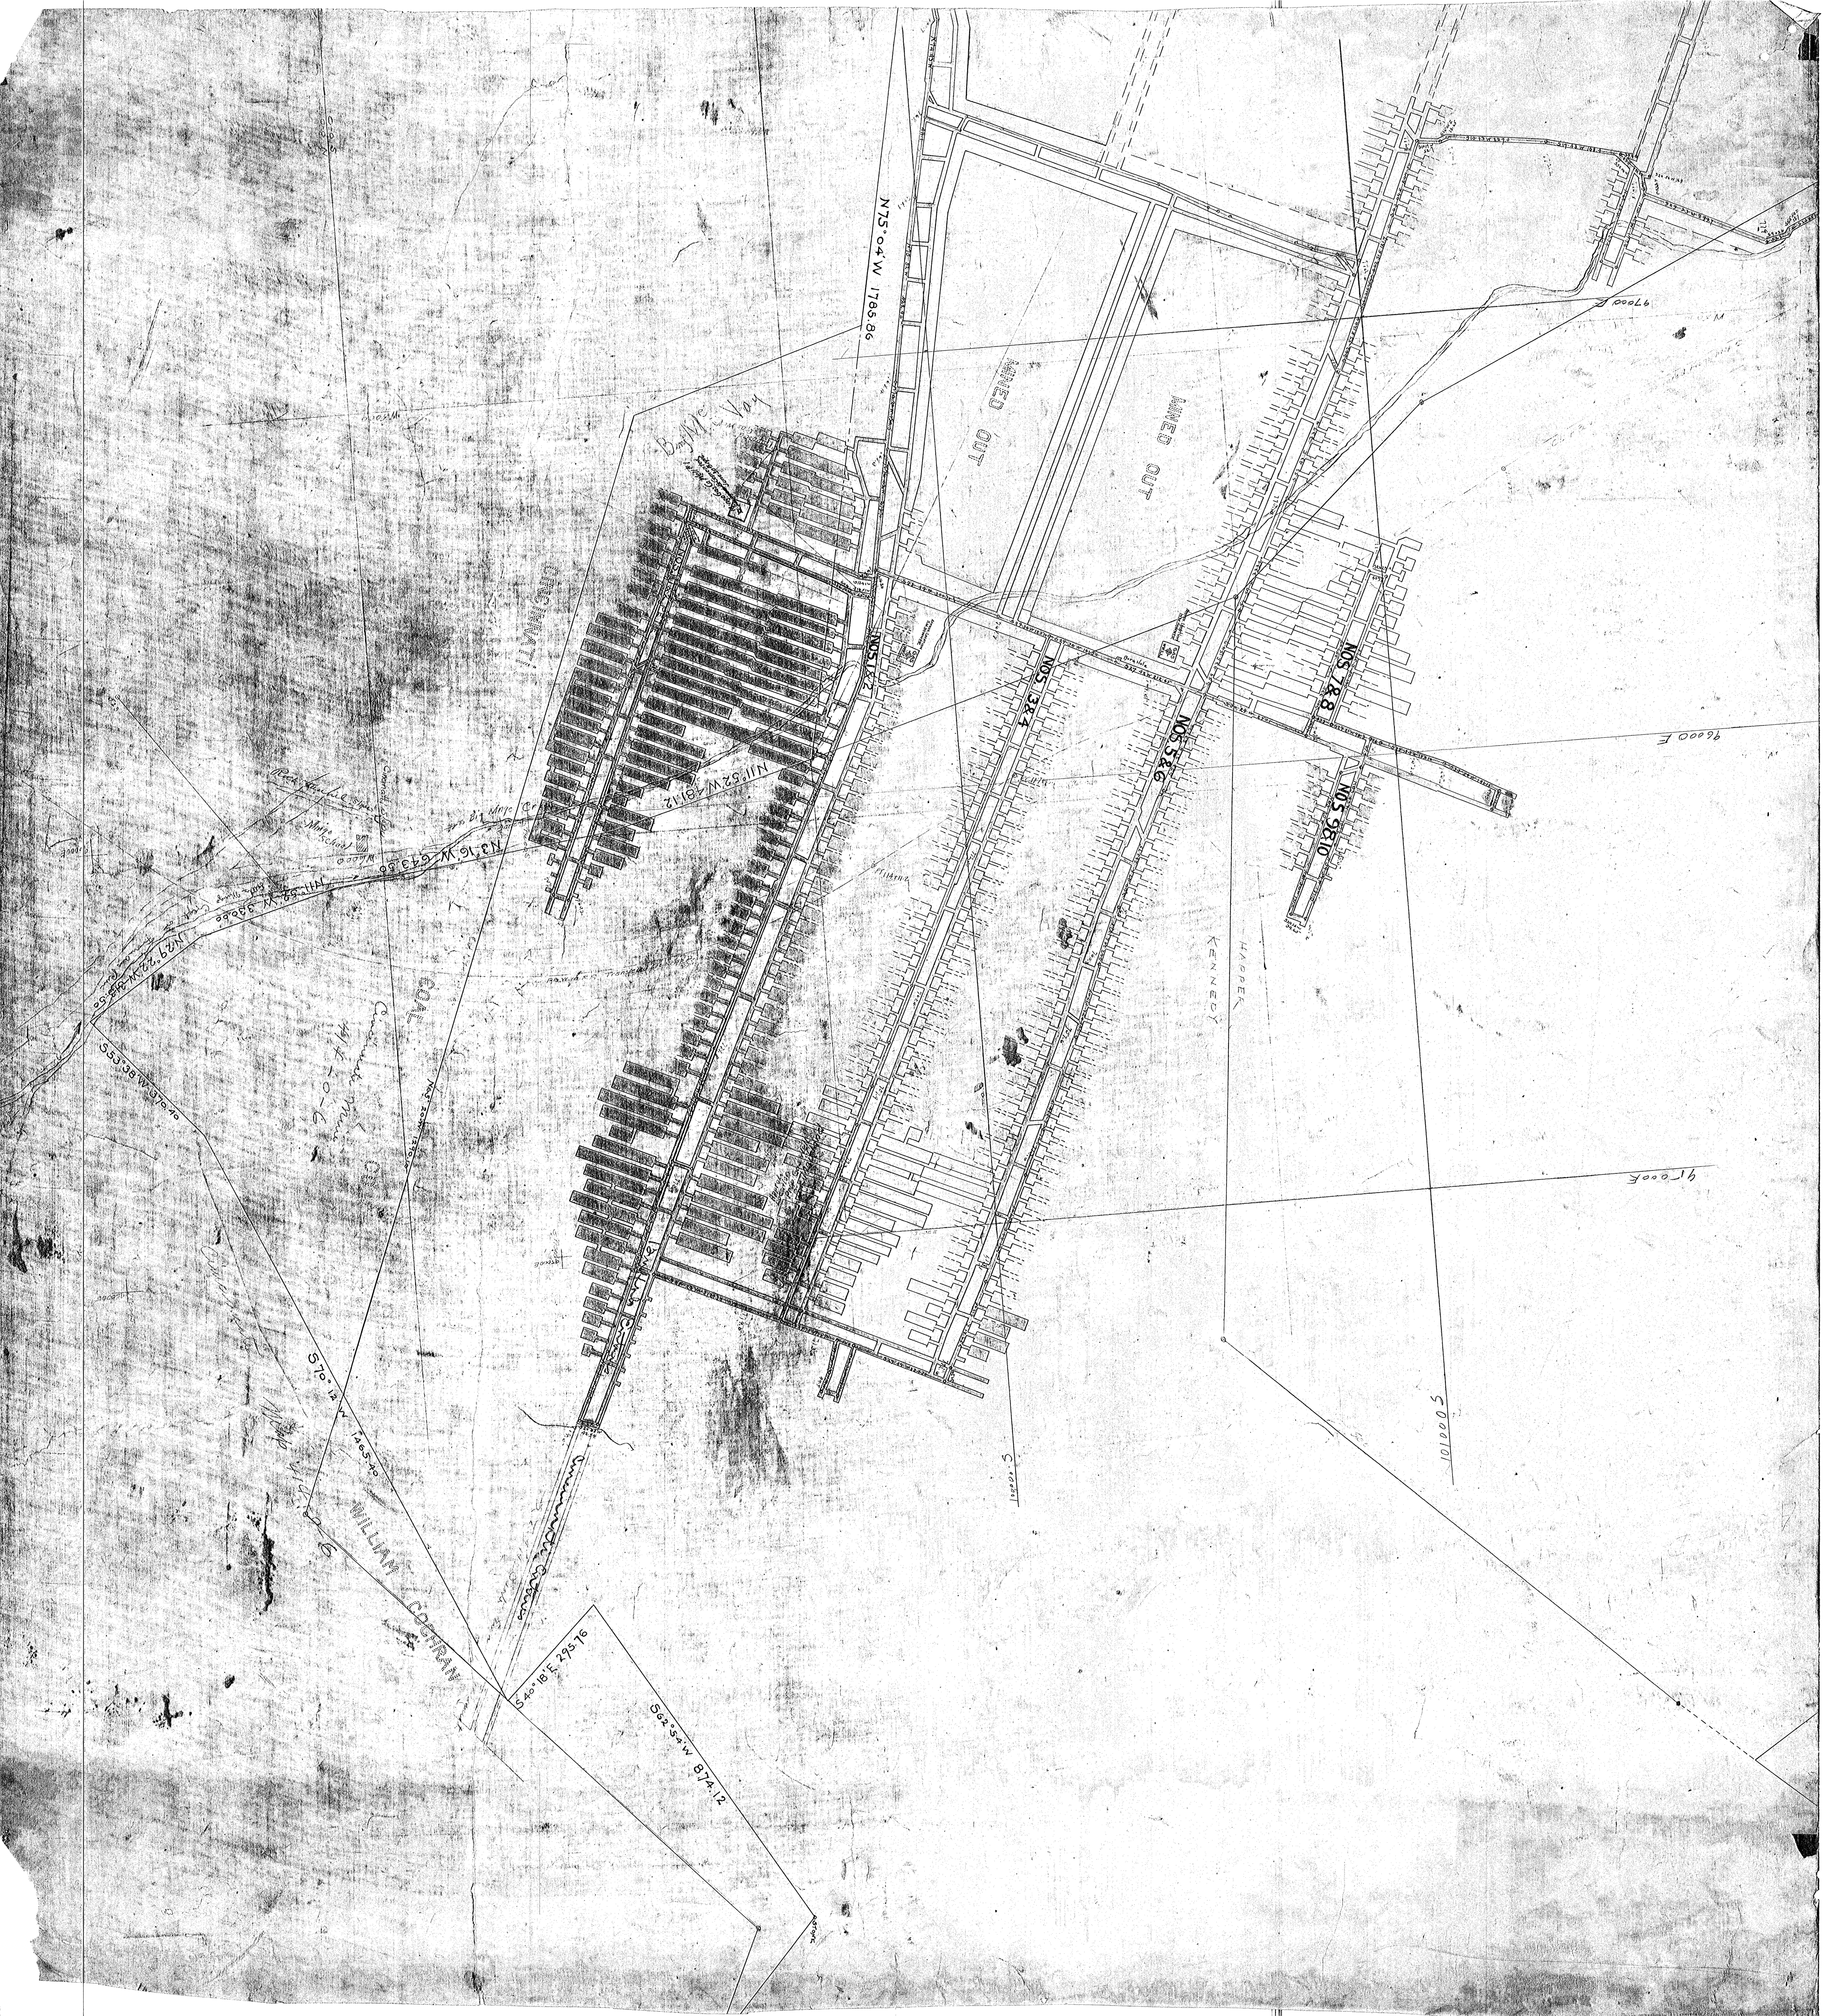
N75°04'W 1785.86
Benj. McVay
Virgo Gas Co. Well #1
MINED OUT
MINED OUT
NOS 1 & 2
NOS 3 & 4
NOS 5 & 6
NOS 7 & 8
NOS 9 & 10
GAS WELL
APPROX. LOCATION S.M. DOWNEY
N11°52'W 481.12
N3°16'W 643.50
N11°52'W 330.00
N29°22'W 313.50
S53°38'W 370.40
N65°20'W 1290.10
Rock Turnpike Road
Cincinnati Coal
Muse School
To Big Muse Cr.
COAL
Cincinnati Mine
4-1-0-6
S70°12'W 1465.40
WILLIAM COCHRAN
S40°18'E 293.16
S62°54'W 874.12
97000 E
96000 E
95000 E
101000 S
KENNEDY
HARPER
PT 114+11.2