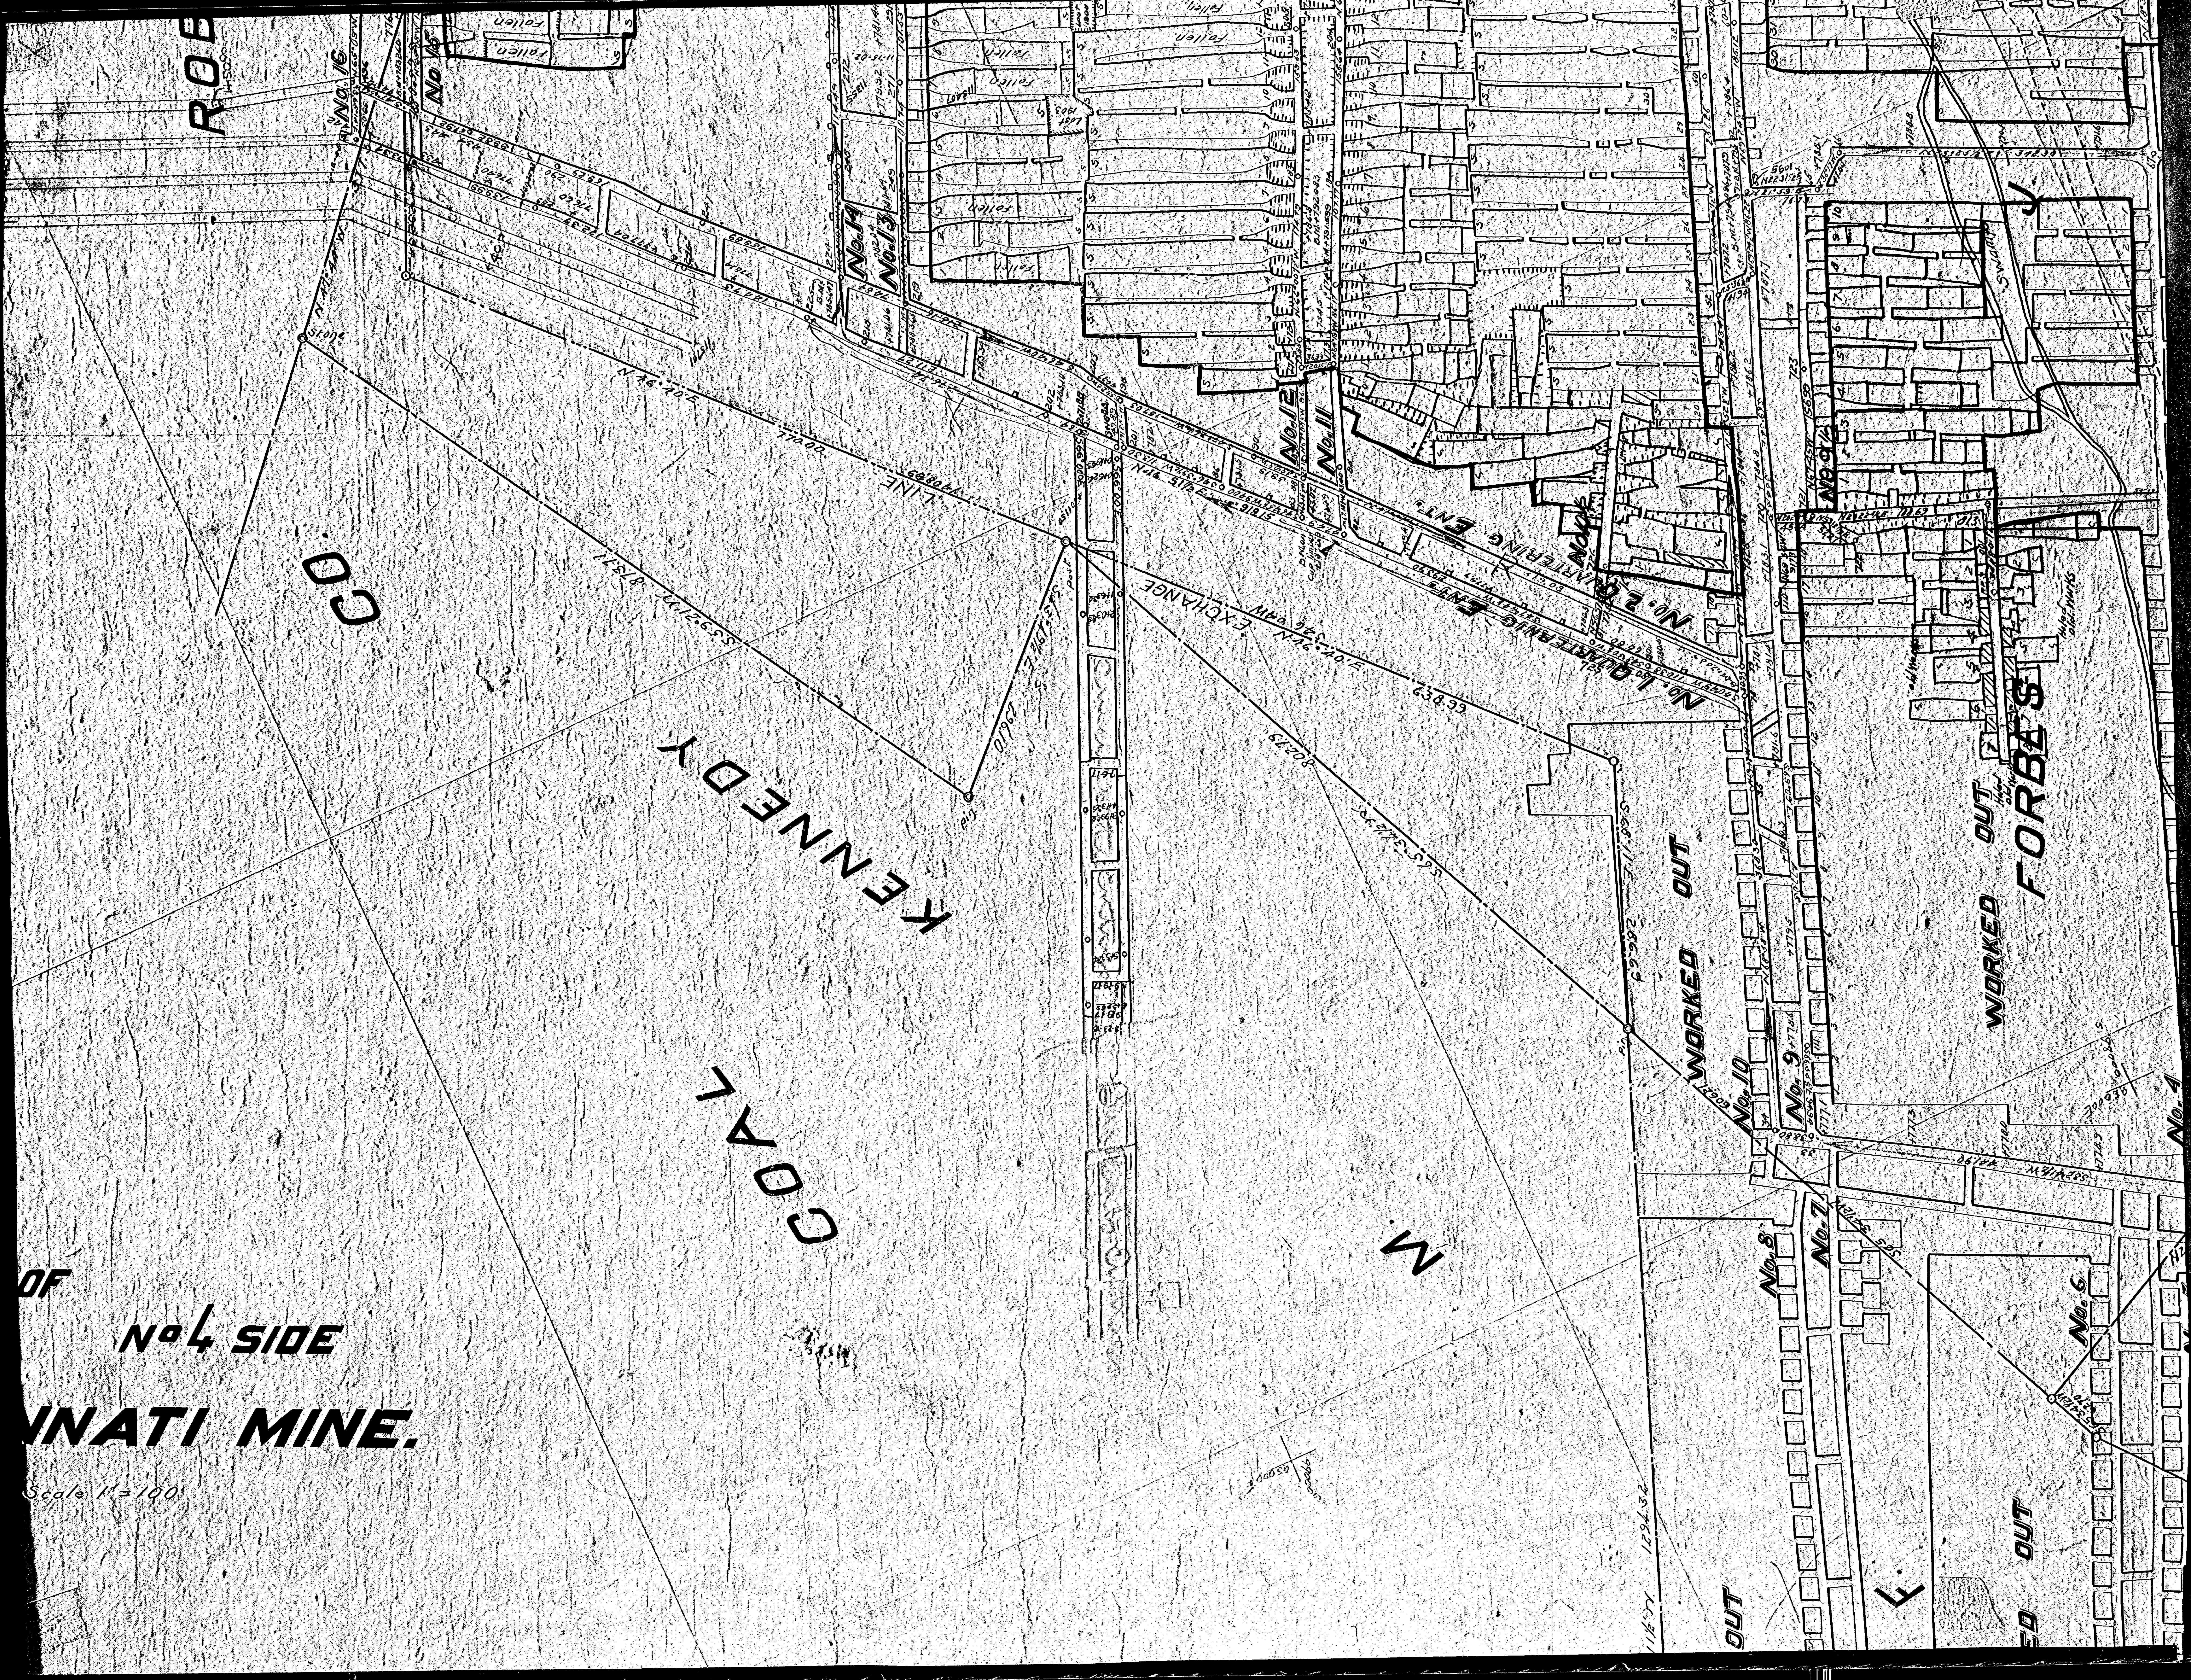
ROB
No.16
No.15
No.14
No.13
No.12
No.11
No.10
No.9
No.8
No.7
No.6
No.4
No.1 QUARTERING ENTS.
No.2 QUARTERING ENTS.
EXCHANGE
LINE
KENNEDY
COAL
CO
M
WORKED OUT
WORKED OUT
FORBES
OUT
OUT
J
F
fallen

OF

No4 SIDE

NNATI MINE.

Scale 1"=100'