


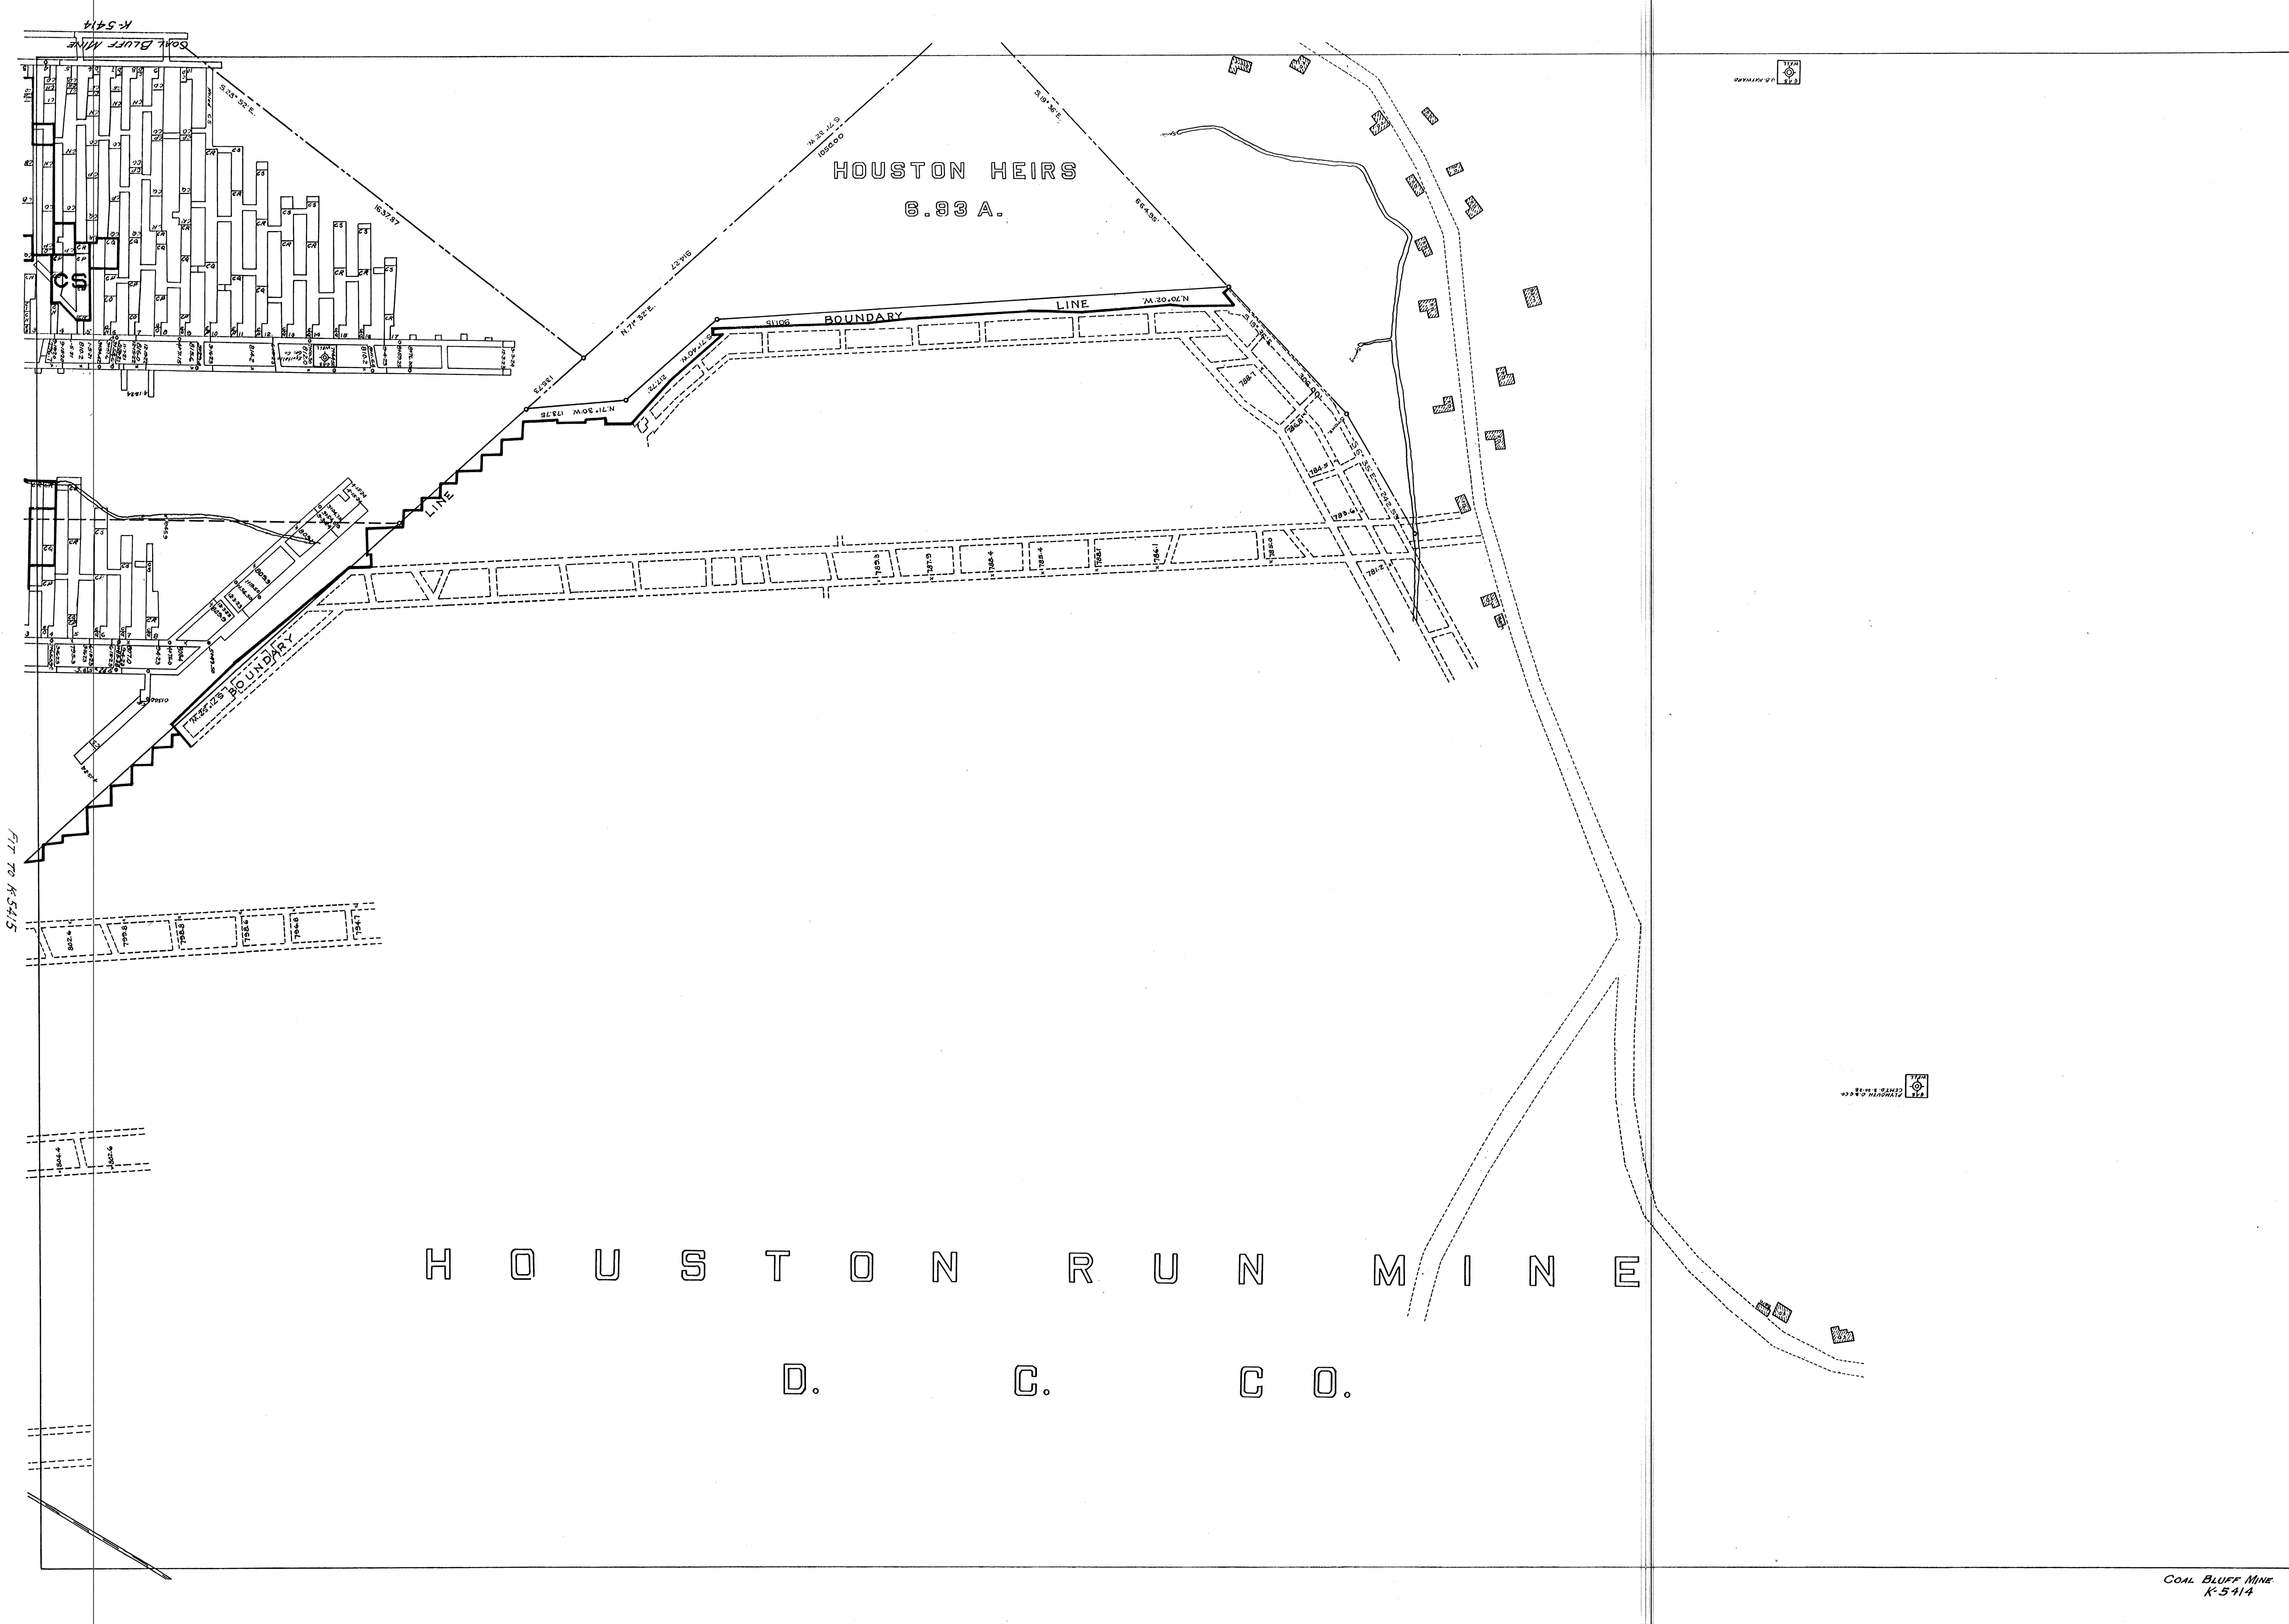

FT 70 K-5415

H O U S T O N R U N M I N E
D. C. C O.