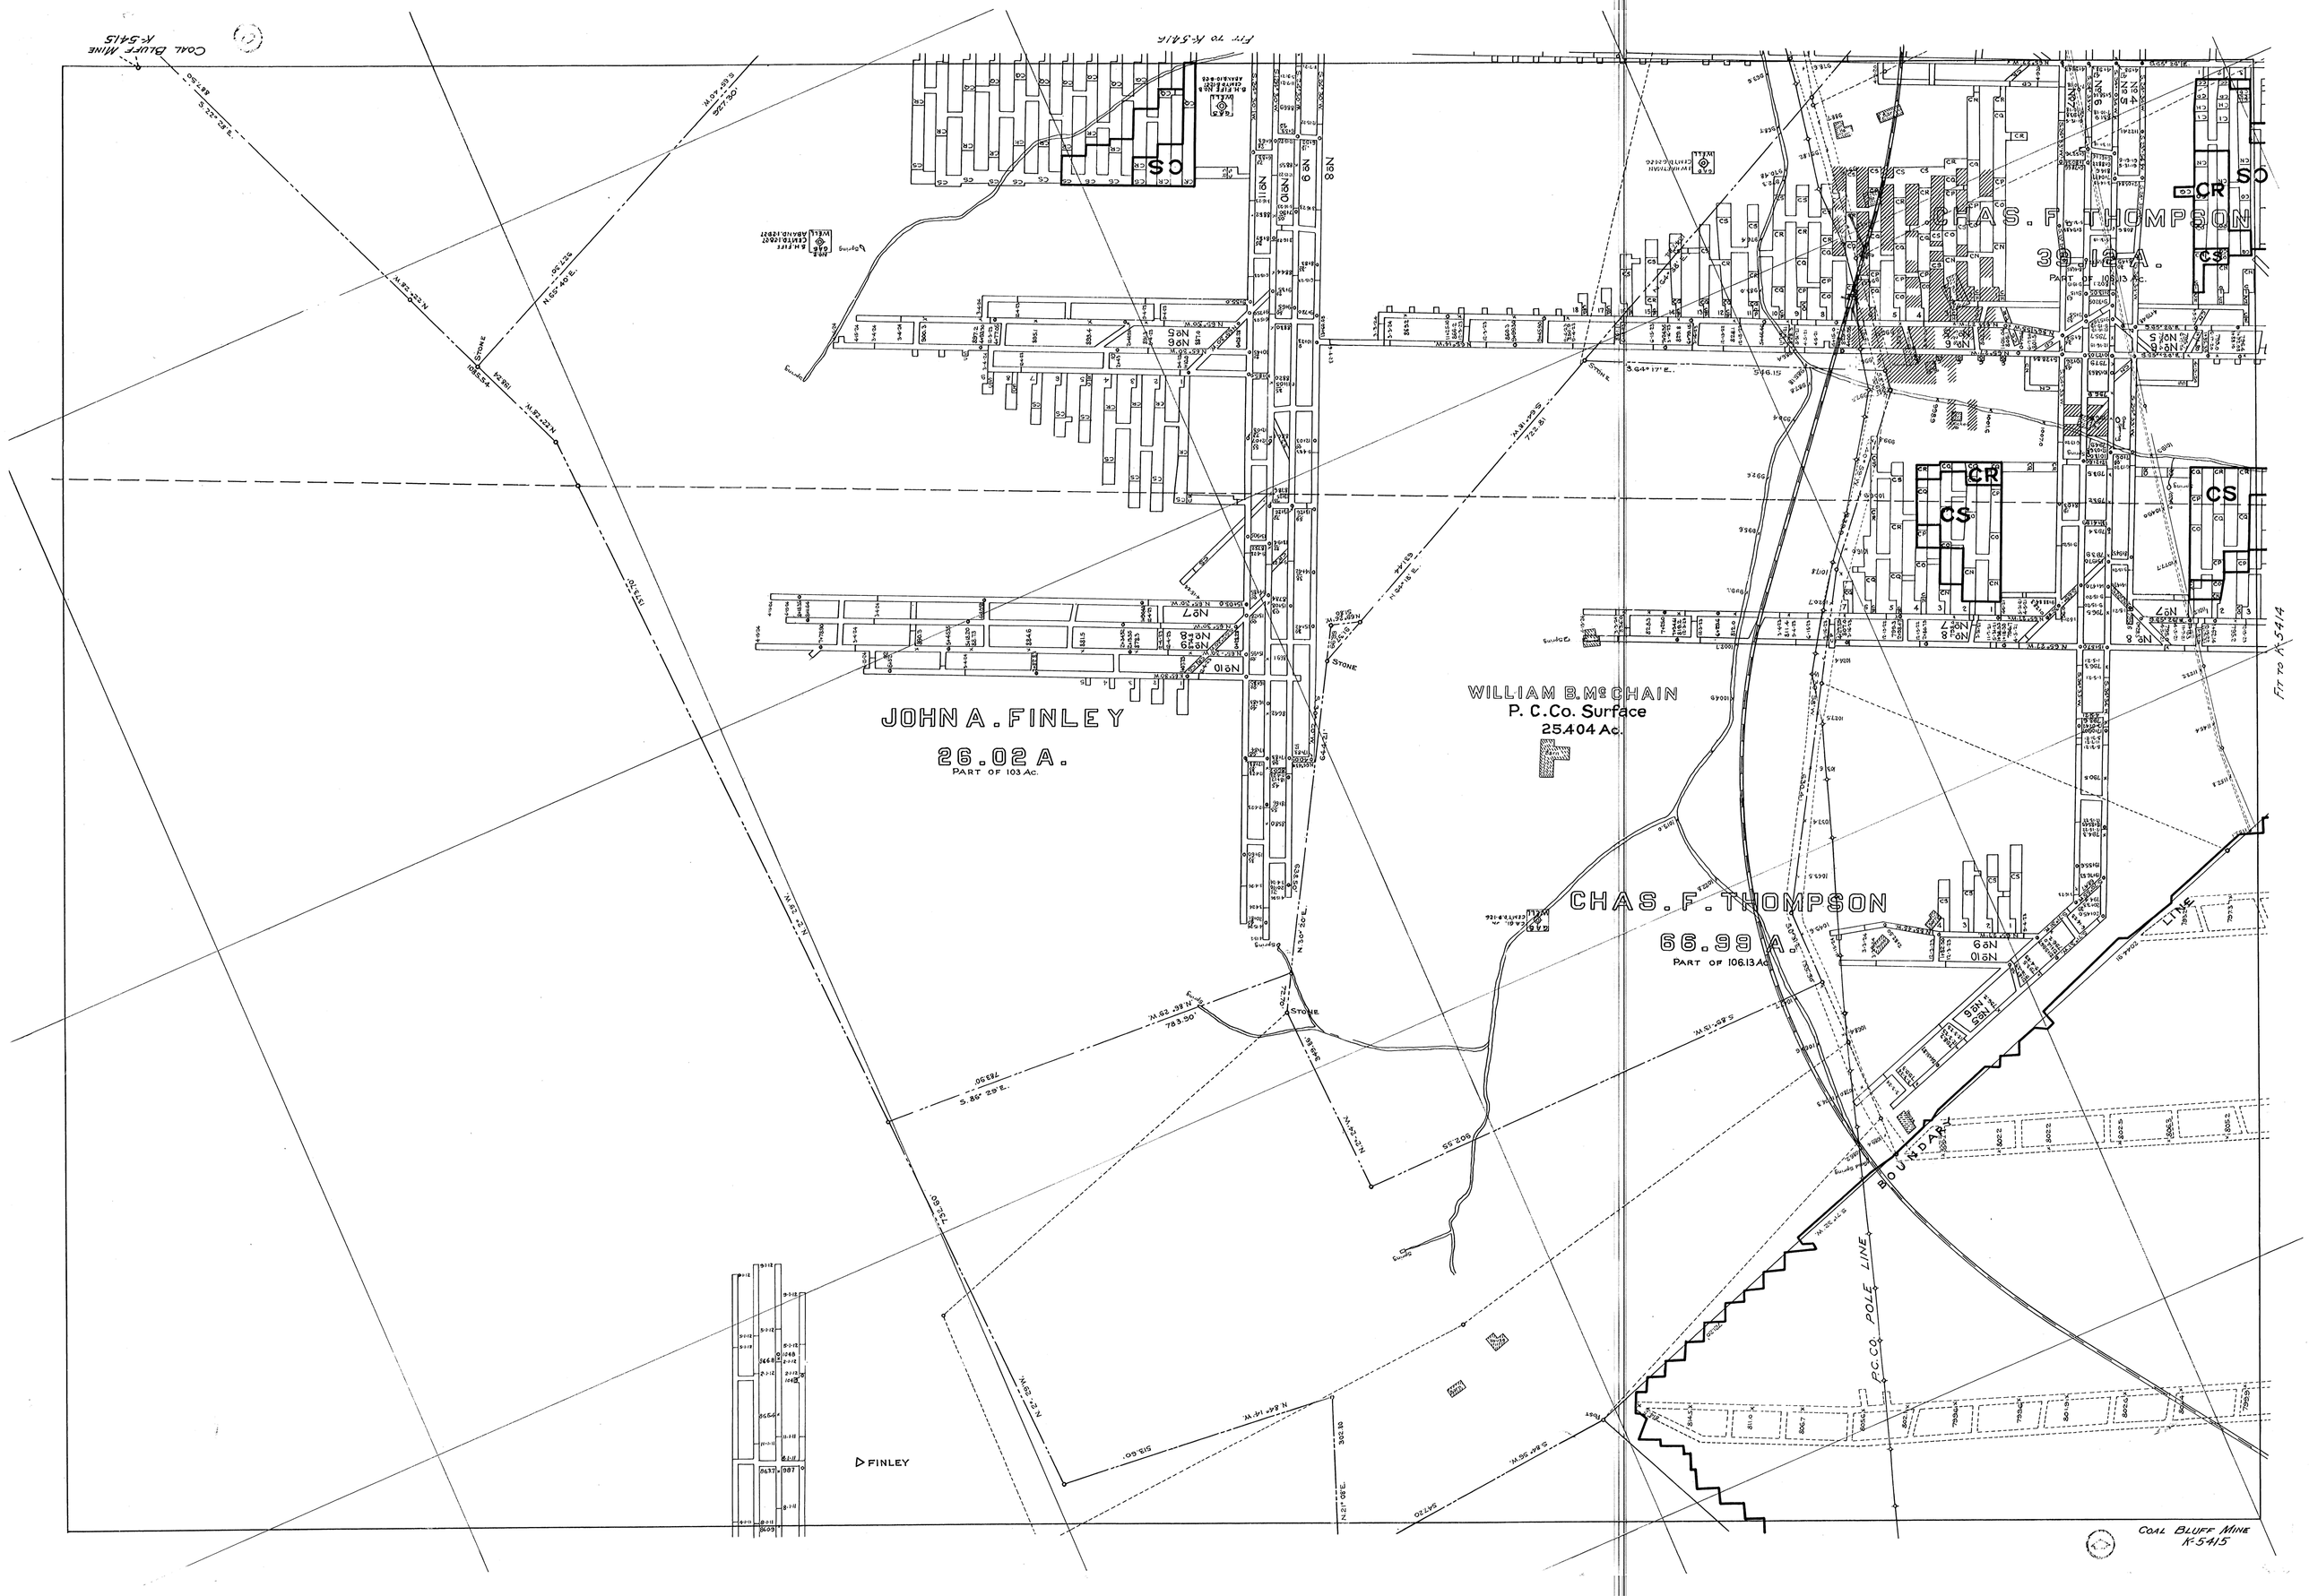
COAL BLUFF MINE
K-5415
FIT TO K-5414
JOHN A. FINLEY
26.02 A.
PART OF 103 Ac.
WILLIAM B. McCHAIN
P. C. Co. Surface
25.404 Ac.
CHAS. F. THOMPSON
66.99 A.
PART OF 106.13 Ac.
CHAS. F. THOMPSON
39.12 A.
PART OF 106.13 Ac.
P.C.CO. POLE LINE
BOUNDARY LINE
FINLEY
N.65°40'E.
527.30'
N.22°28'W.
1584.24'
S.86°29'E.
783.50'
N.86°29'W.
783.50'
N.22°28'W.
602.55'
S.86°19'W.
722.81'
N.86°19'W.
313.60'
S.86°56'W.
247.20'
N.27°08'E.
312.06'
N.30°20'E.
N.22°28'W.
1515.70'
S.65°26'W.
1056.26'
S.86°29'E.
1848.50'
N.86°19'W.
1134.18'
S.64°17'E.
948.15'
N