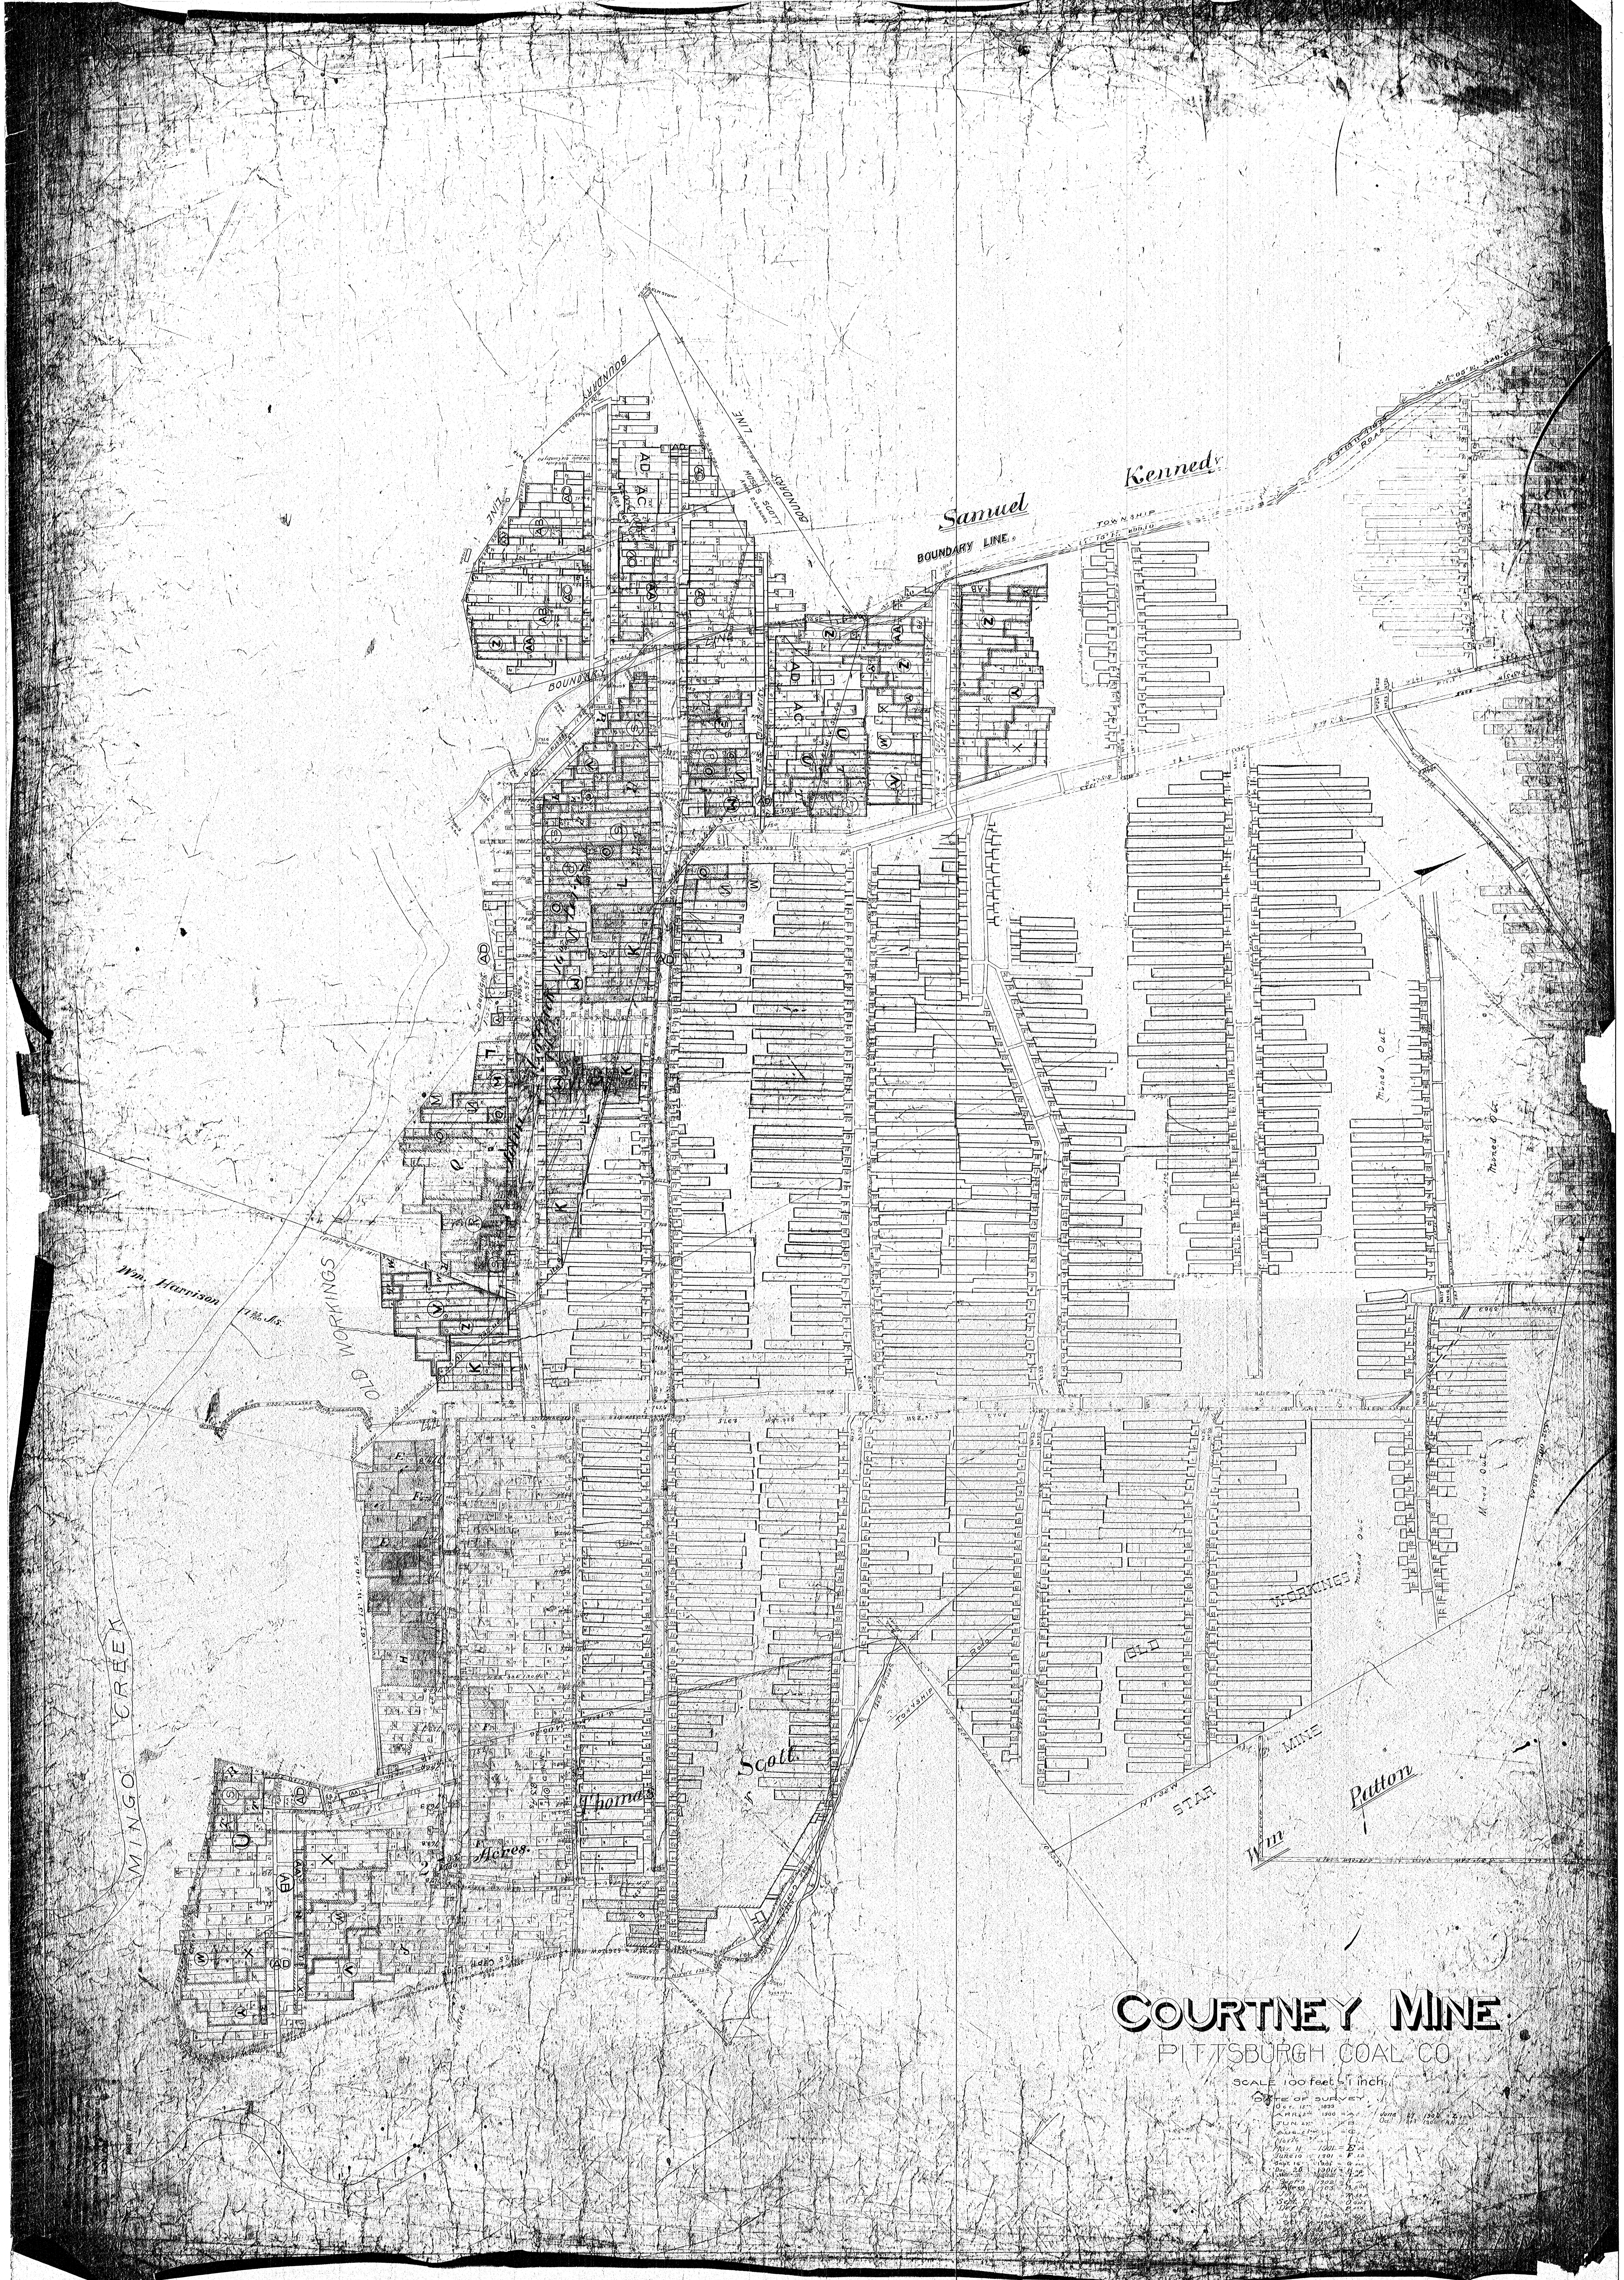
BOUNDARY LINE
MOSES SCOTT AREA 2.65 ACRES
ELM STUMP
Samuel Kennedy
BOUNDARY LINE
TOWNSHIP
ROAD
Wm. Harrison 17 25/100 As.
OLD WORKINGS
Mined Out
Mined Out
Mined Out
MINGO CREEK
Thomas Acres
Scott
OLD WORKINGS
TOWNSHIP ROAD
STAR MINE
Wm Patton

COURTNEY MINE

PITTSBURGH COAL CO.

SCALE 100 feet = 1 inch

DATE OF SURVEY

Oct. 15th 1899
Apr. 2nd 1900 = A
Jun. 27th " = B
Aug. 23rd " = C
Nov 26 " = D
Mar. 11 1901 = E J.C.
June 10 1901 = F S.D.
Sept. 16 1901 = G F.O.T.
Dec. 20 1901 = H H.B.
Mar. 7 1902 = I B.H.
Sept 9 1902 = K J.T.
Apr. 9 1903 = M E.G.R.
July 1 " = N G.H.P.
Sept. 7 " = O G.W.S.
Dec. 23 " = P C.S.A.
June 13 1904 = R J.S.G.
Sept. 14 1904 = S [illegible]
Dec. 5 1904 = T C.S.
Mch 13 1905 = U B.G.S.
June 16 1905 = V B.G.S.
[illegible] 15 1905 = [illegible] A.C.N.
June 27 1906 = Z J.T.
Oct. 24 1906 AA D.C.N.