FIT TO 26

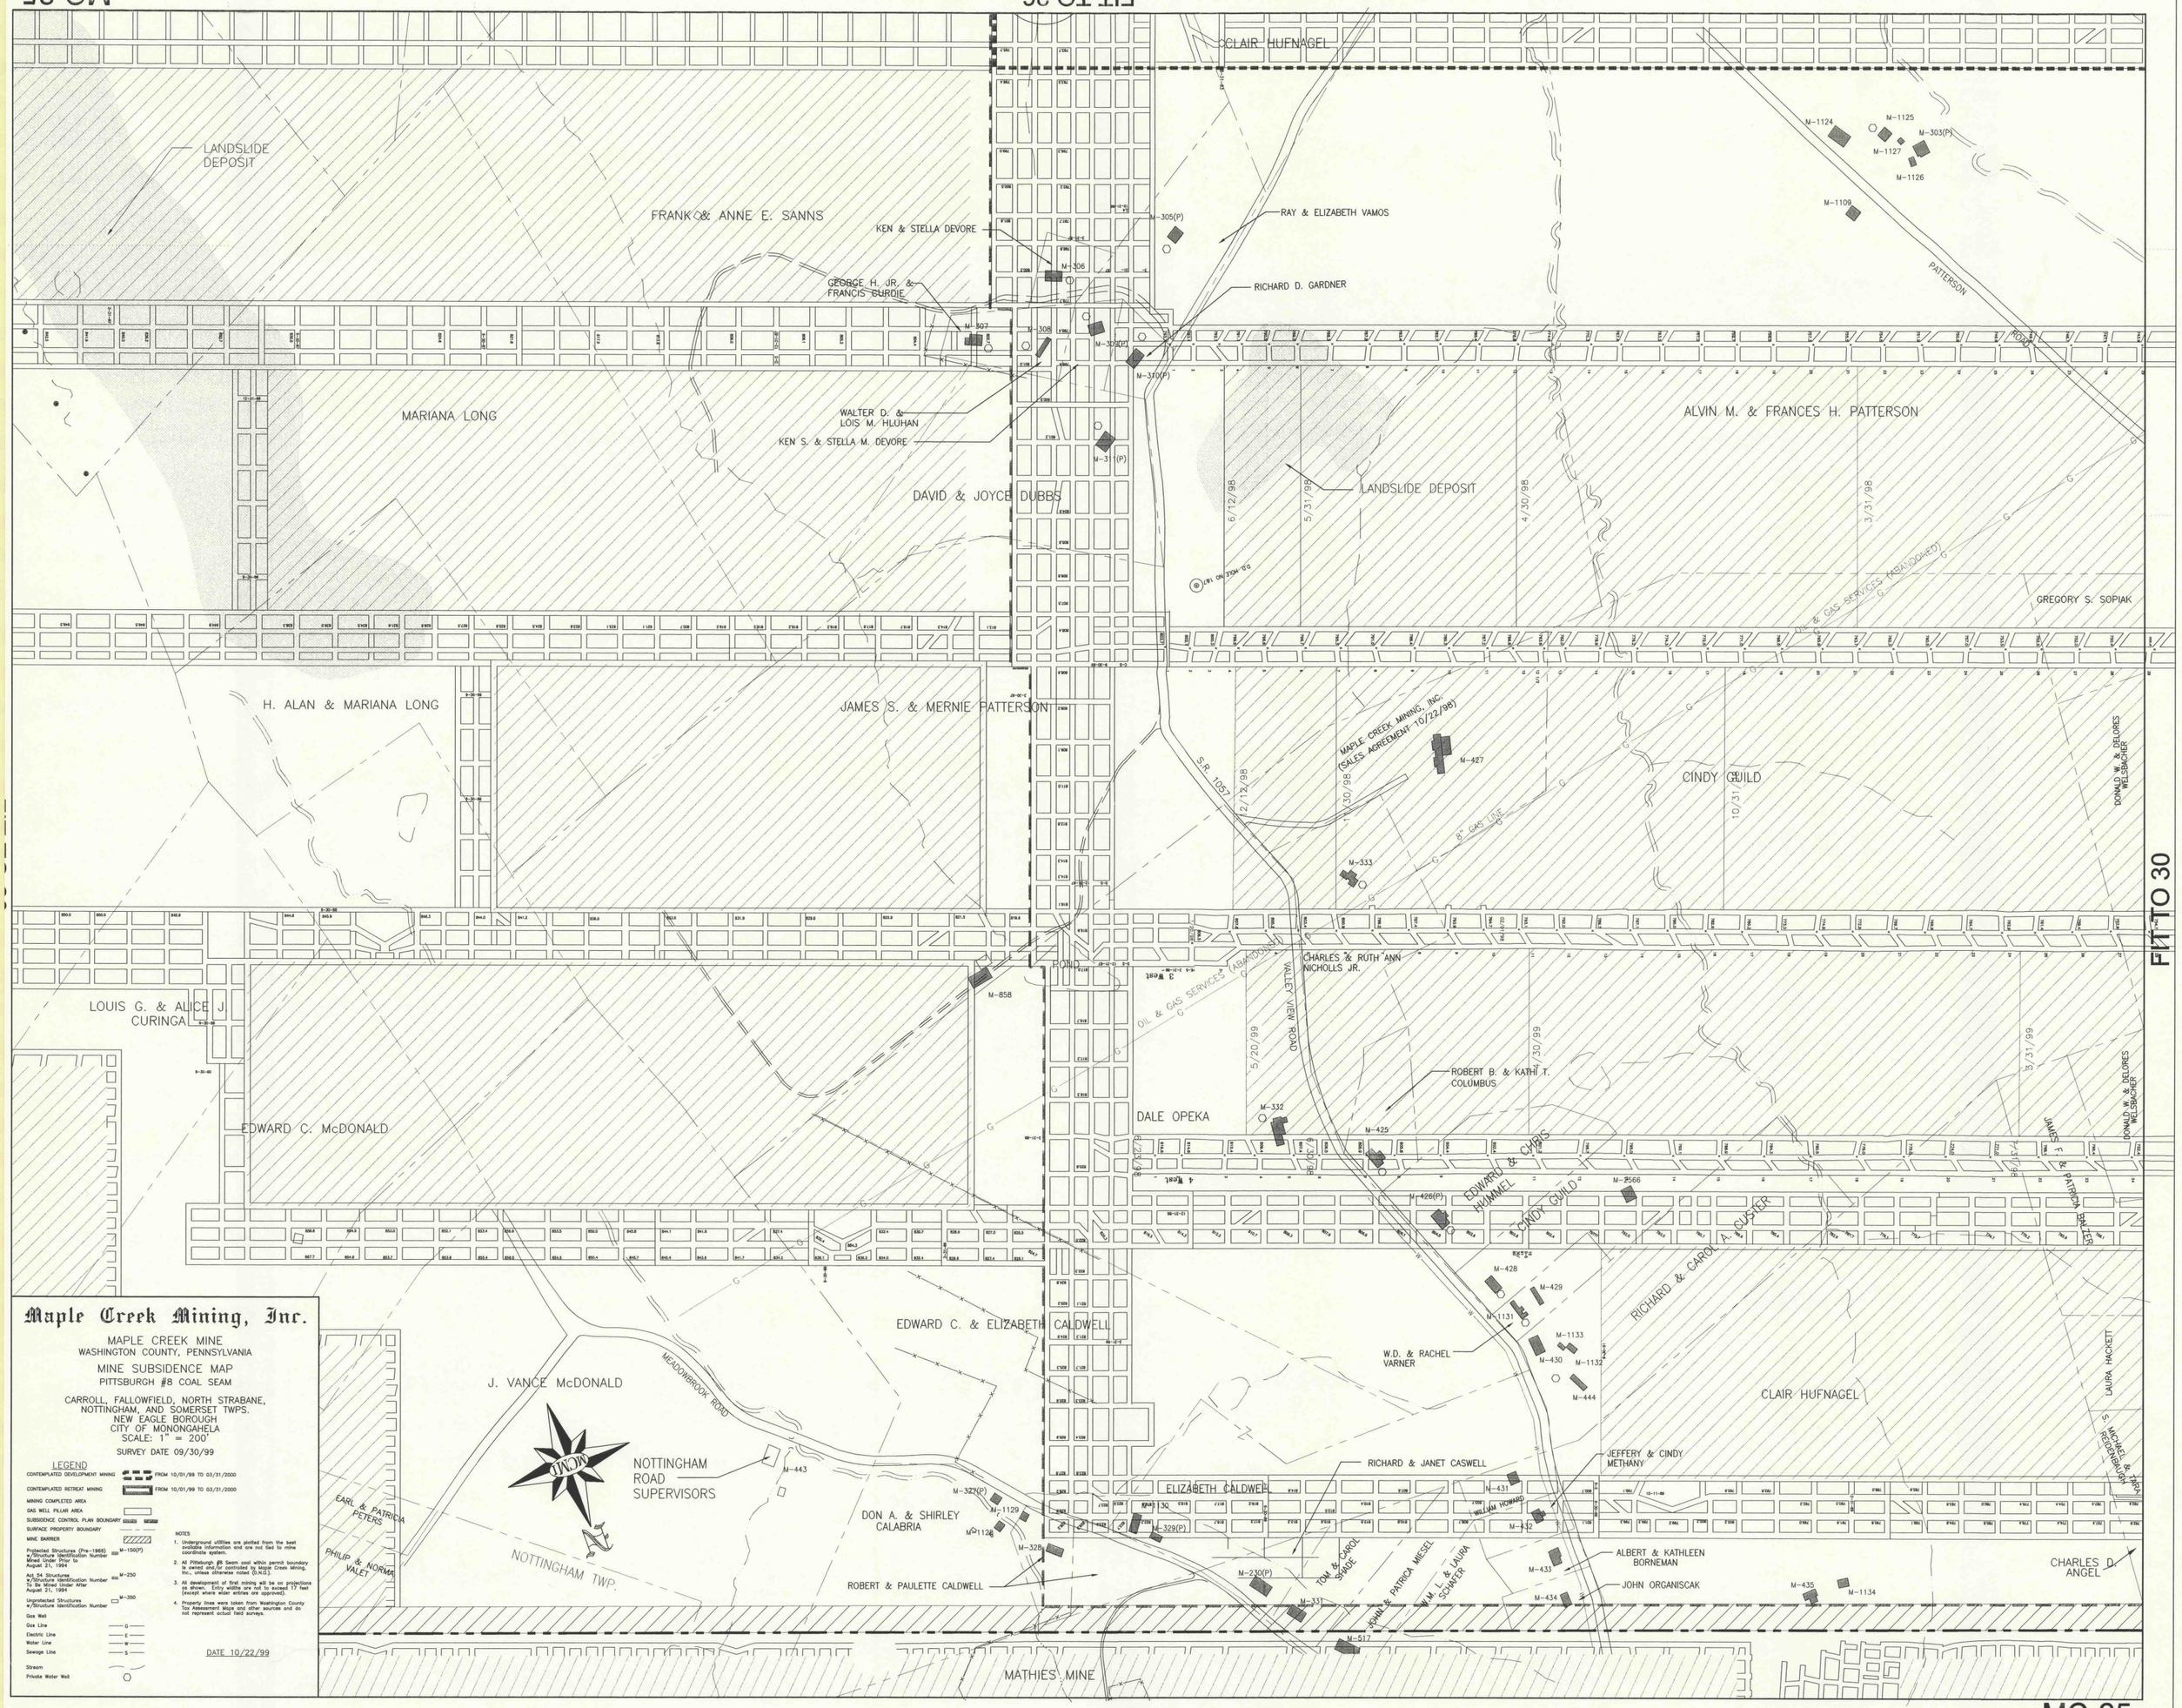
Maple Creek Mining, Inc.
MAPLE CREEK MINE
WASHINGTON COUNTY, PENNSYLVANIA
MINE SUBSIDENCE MAP
PITTSBURGH #8 COAL SEAM
CARROLL, FALLOWFIELD, NORTH STRABANE, NOTTINGHAM, AND SOMERSET TWPS.
NEW EAGLE BOROUGH
CITY OF MONONGAHELA
SCALE: 1" = 200'
SURVEY DATE 09/30/99
LEGEND
CONTEMPLATED DEVELOPMENT MINING FROM 10/01/99 TO 03/31/2000
CONTEMPLATED RETREAT MINING FROM 10/01/99 TO 03/31/2000
MINING COMPLETED AREA
GAS WELL PILLAR AREA
SUBSIDENCE CONTROL PLAN BOUNDARY
SURFACE PROPERTY BOUNDARY
MINE BARRIER
Protected Structures (Pre-1968) w/Structure Identification Number Mined Under Prior to August 21, 1994 M-150(P)
Act 54 Structures w/Structure Identification Number To Be Mined Under After August 21, 1994 M-250
Unprotected Structures w/Structure Identification Number M-350
Gas Well
Gas Line G
Electric Line E
Water Line
Sewage Line S
Stream
Private Water Well
NOTES
1. Underground utilities are plotted from the best available information and are not tied to mine coordinate system.
2. All Pittsburgh #8 Seam coal within permit boundary is owned and/or controlled by Maple Creek Mining, Inc., unless otherwise noted (U.N.O.).
3. All development of that mining will be on projections as shown. Entry widths are not to exceed 17 feet (except where wider entries are approved).
4. Property lines were taken from Washington County Tax Assessment Maps and other sources and do not represent actual field surveys.
DATE 10/22/99
LANDSLIDE DEPOSIT
FRANK & ANNE E. SANNS
KEN & STELLA DEVORE
GEORGE H. JR. & FRANCIS GURDIE
MARIANA LONG
WALTER D. & LOIS M. HLUHAN
KEN S. & STELLA M. DEVORE
DAVID & JOYCE DUBBS
CLAIR HUFNAGEL
RAY & ELIZABETH VAMOS
RICHARD D. GARDNER
ALVIN M. & FRANCES H. PATTERSON
PATTERSON
LANDSLIDE DEPOSIT
GREGORY S. SOPIAK
H. ALAN & MARIANA LONG
JAMES S. & MERNIE PATTERSON
MAPLE CREEK MINING, INC. (SALES AGREEMENT 10/22/98)
CINDY GUILD
DONALD W. & DELORES WELSBACHER
S.R. 1057
8" GAS LINE
OIL & GAS SERVICES (ABANDONED)
CHARLES & RUTH ANN NICHOLLS JR.
VALLEY VIEW ROAD
LOUIS G. & ALICE J. CURINGA
EDWARD C. McDONALD
ROBERT B. & KATHI T. COLUMBUS
DALE OPEKA
EDWARD & CYRIS HUMMEL
CINDY GUILD
JAMES F. & PATRICIA BALLER
RICHARD & CAROL A. CUSTER
EDWARD C. & ELIZABETH CALDWELL
W.D. & RACHEL VARNER
CLAIR HUFNAGEL
LAURA HACKETT
S. MICHAEL & TARA REIDENBAUGH
J. VANCE McDONALD
MEADOWBROOK ROAD
NOTTINGHAM ROAD SUPERVISORS
RICHARD & JANET CASWELL
JEFFERY & CINDY METHANY
ELIZABETH CALDWELL
WILLIAM HOWARD
EARL & PATRICIA PETERS
PHILIP & NORMA VALET
DON A. & SHIRLEY CALABRIA
NOTTINGHAM TWP.
ROBERT & PAULETTE CALDWELL
TOM & CAROL SHADE
JOHN & PATRICA MIESEL
W.M. J. & LAURA SCHWER
ALBERT & KATHLEEN BORNEMAN
JOHN ORGANISCAK
CHARLES D. ANGEL
MATHIES MINE