

J. H. McLean
1882-1883 MOD. L.L.S.







W. I. Cowan

H. H. Rainey

John M. Ross

Mary Jane Douglass

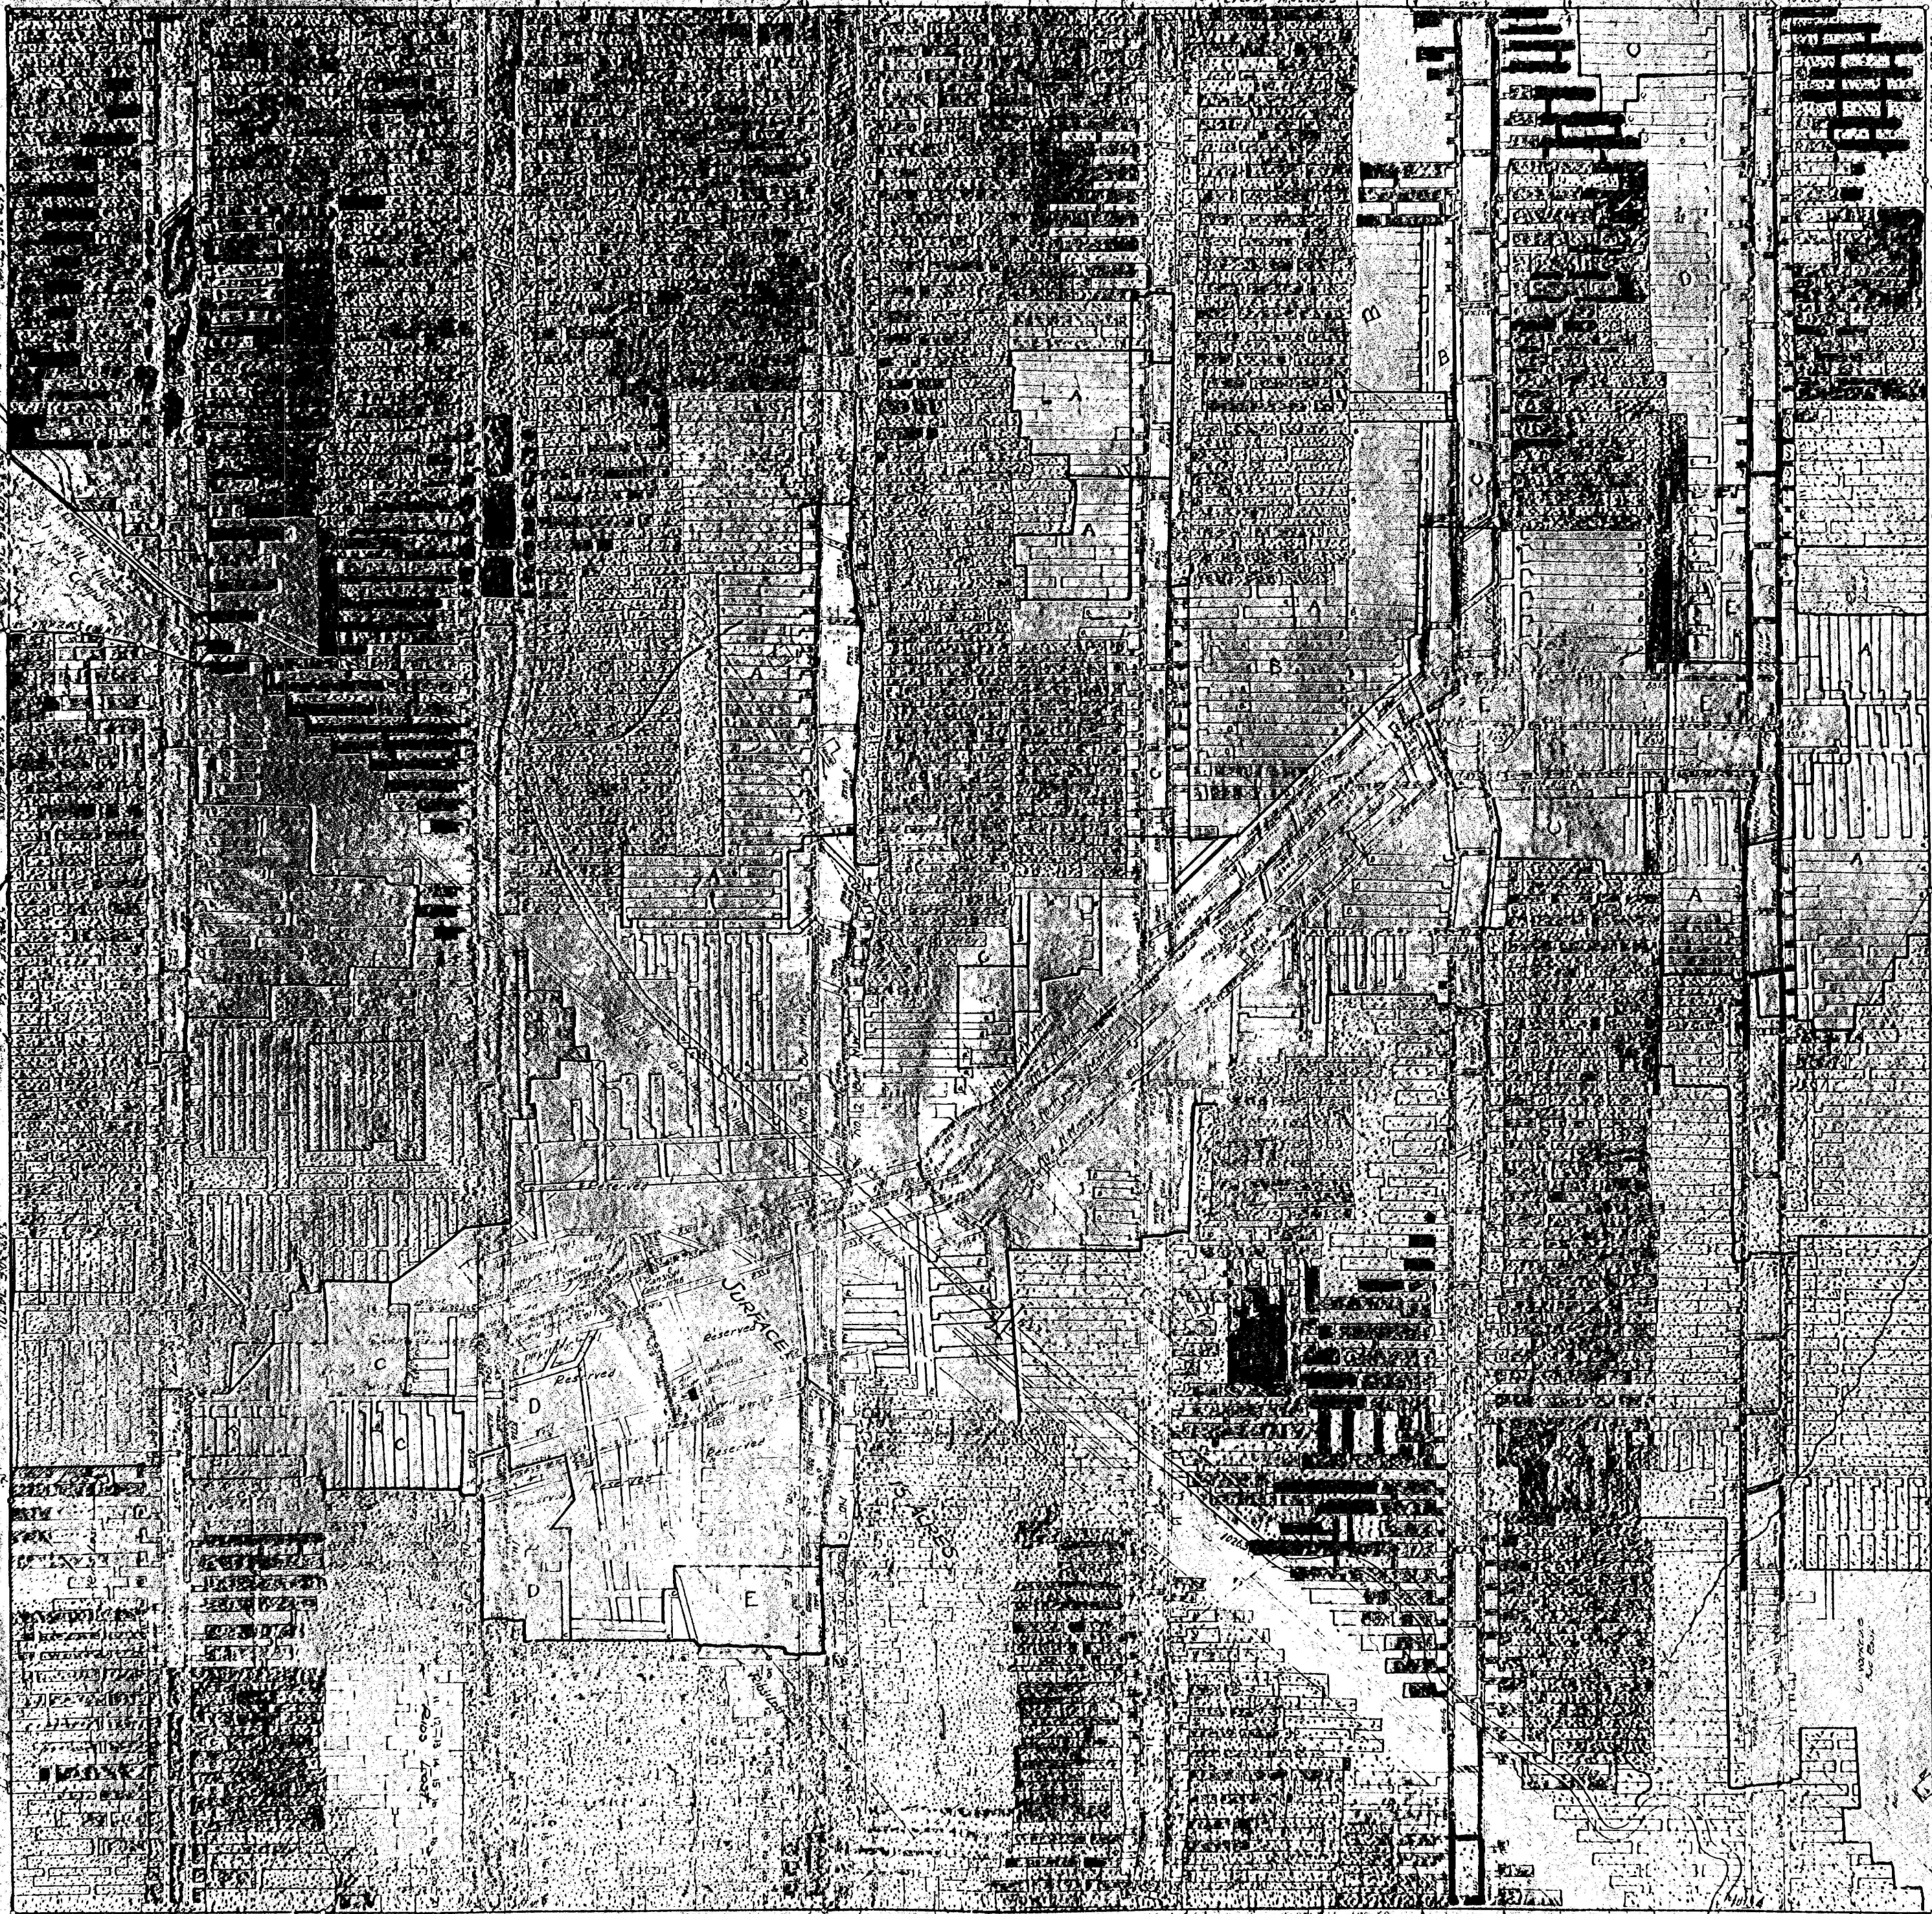

Margaret Barclay

H. H. Rainey

Mary Jane Douglass

SCALE - 1" = 200'

ECLIPSE GAS COAL COMPANY
Plan of Mine

Surveyed in
Peters & Nottingham Truss Washington Co. Pa.
