


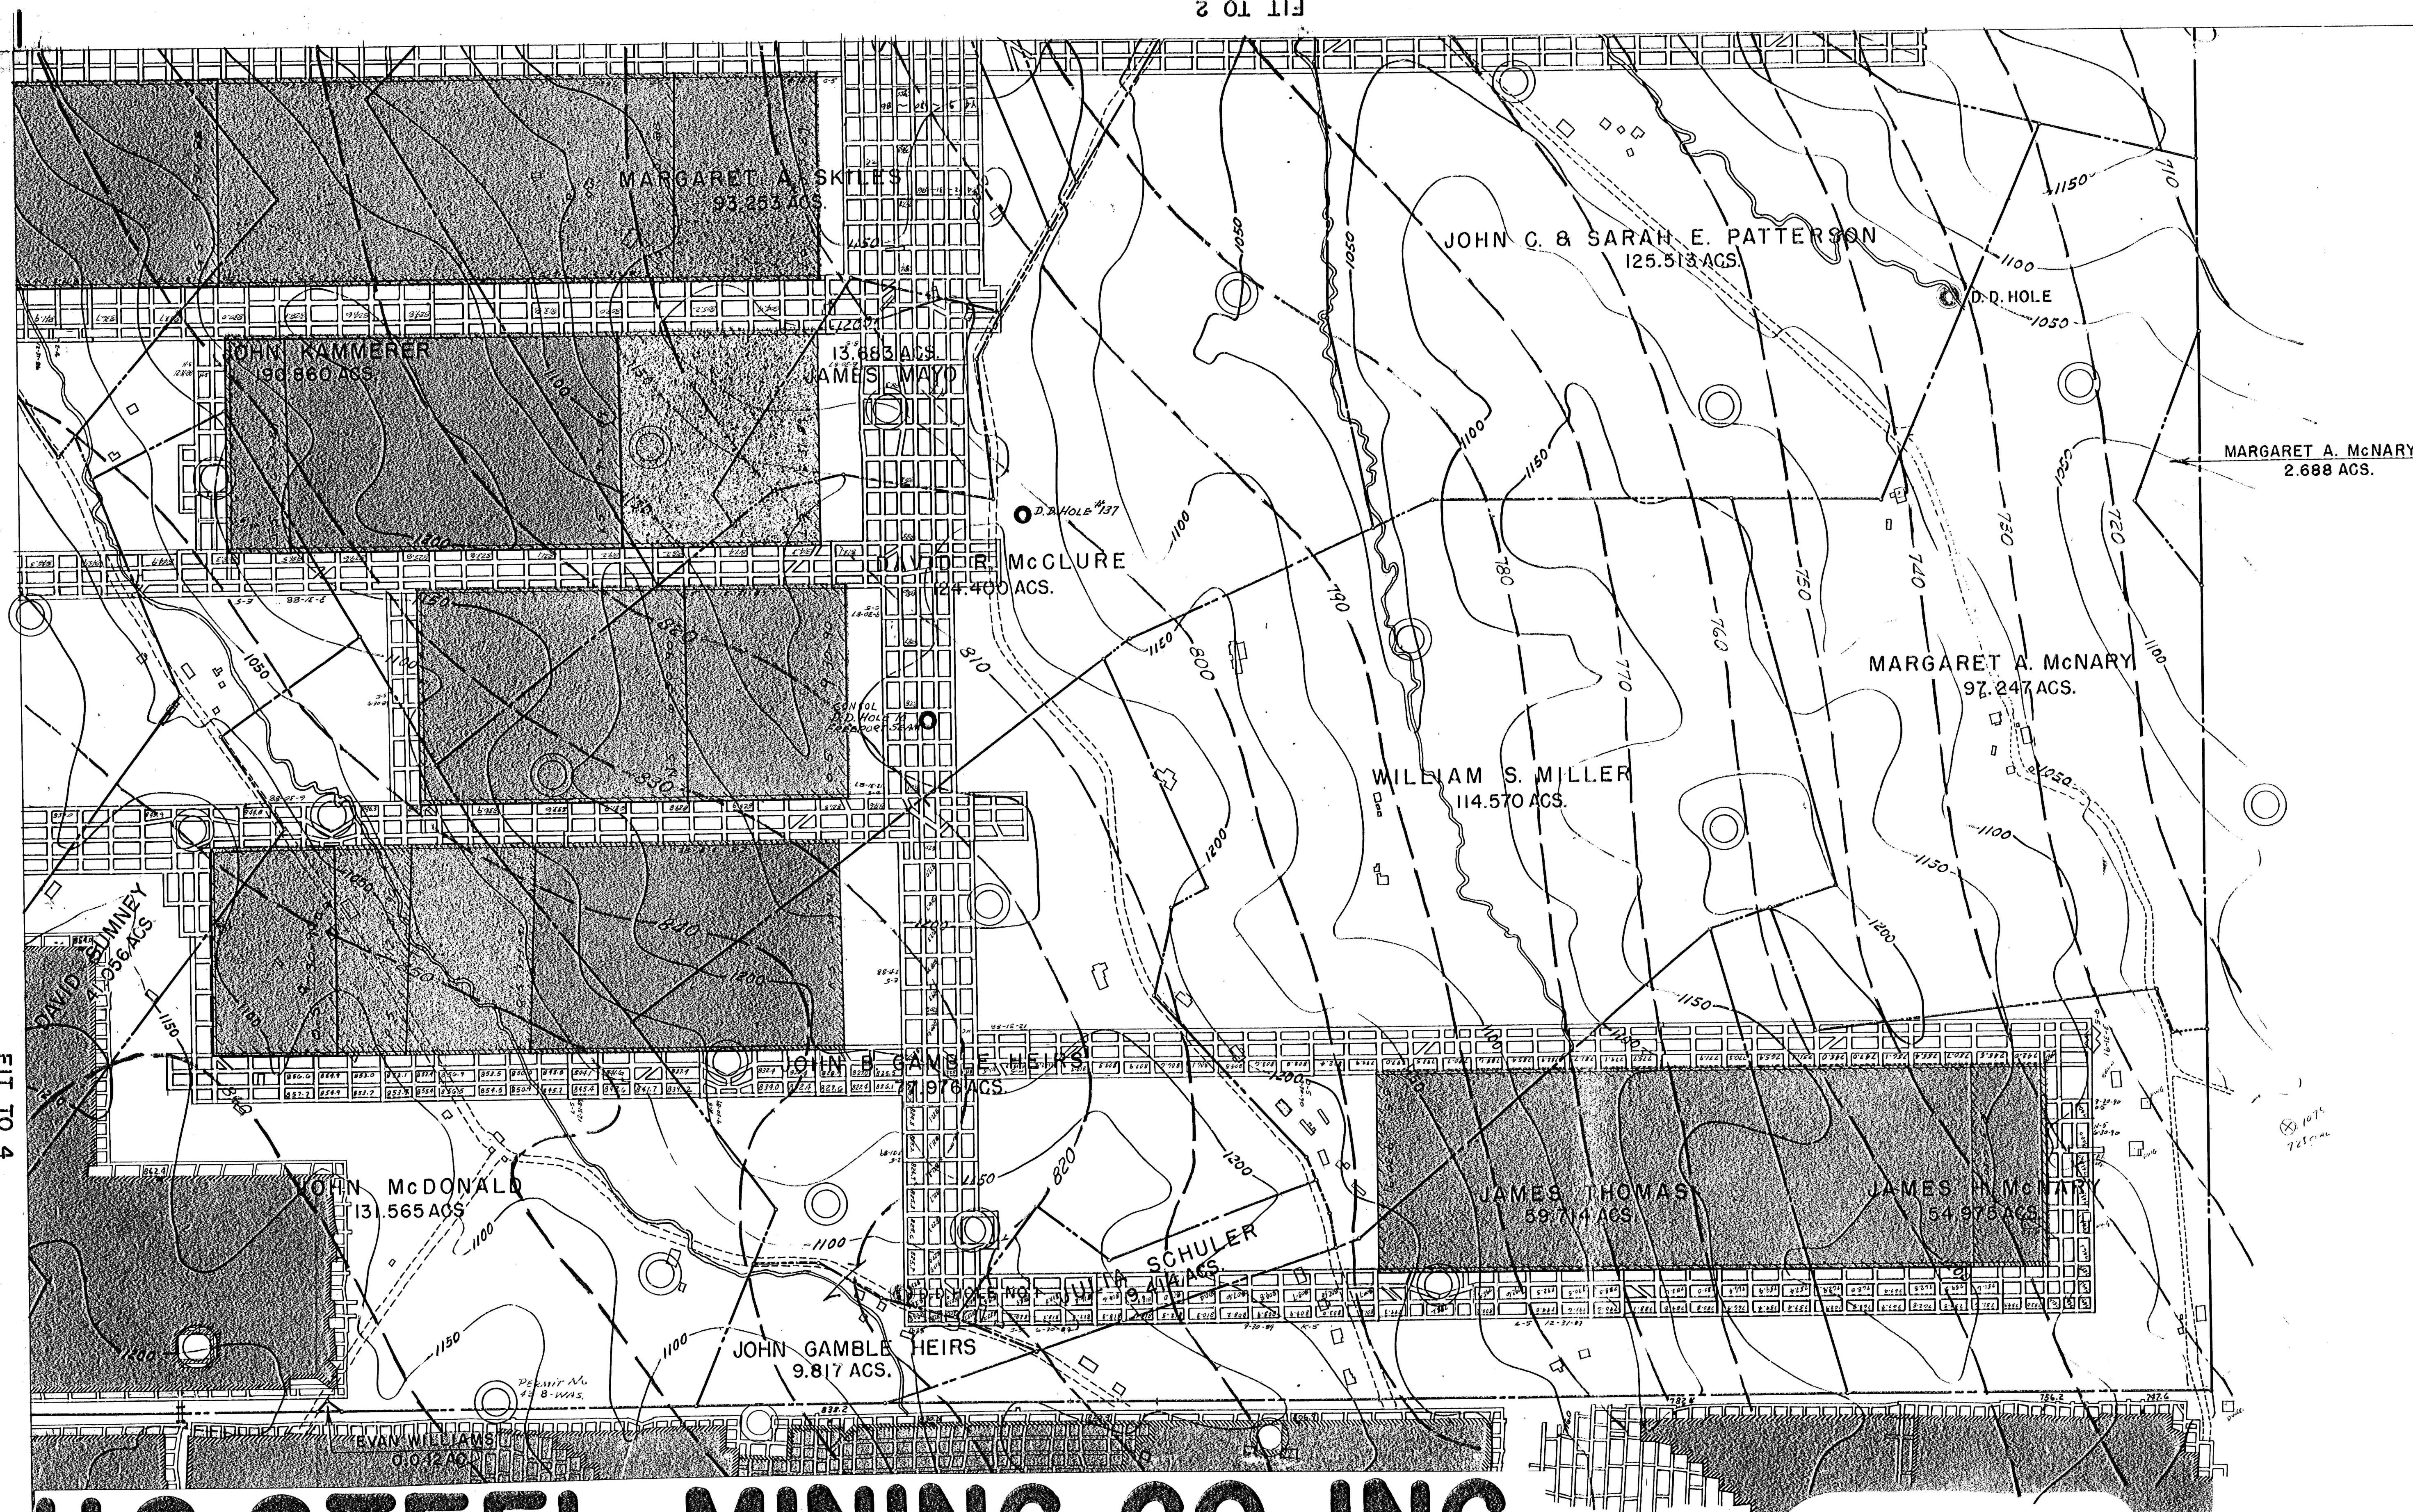

FIT TO 4

U.S. STEEL MINING CO., INC.

NORTHERN DIVISION

MAPLE CREEK MINE

**NOTTINGHAM, FALLOWFIELD,
SOMERSET, CARROLL TOWNSHIPS
AND NEW EAGLE BOROUGH**

WASHINGTON COUNTY, PA.

SCALE 1" = 300'

	10	6	3
13	9	5	2
12	8	4	1
11	TITLE 7		

300' Tracings