


FIT TO 8

4

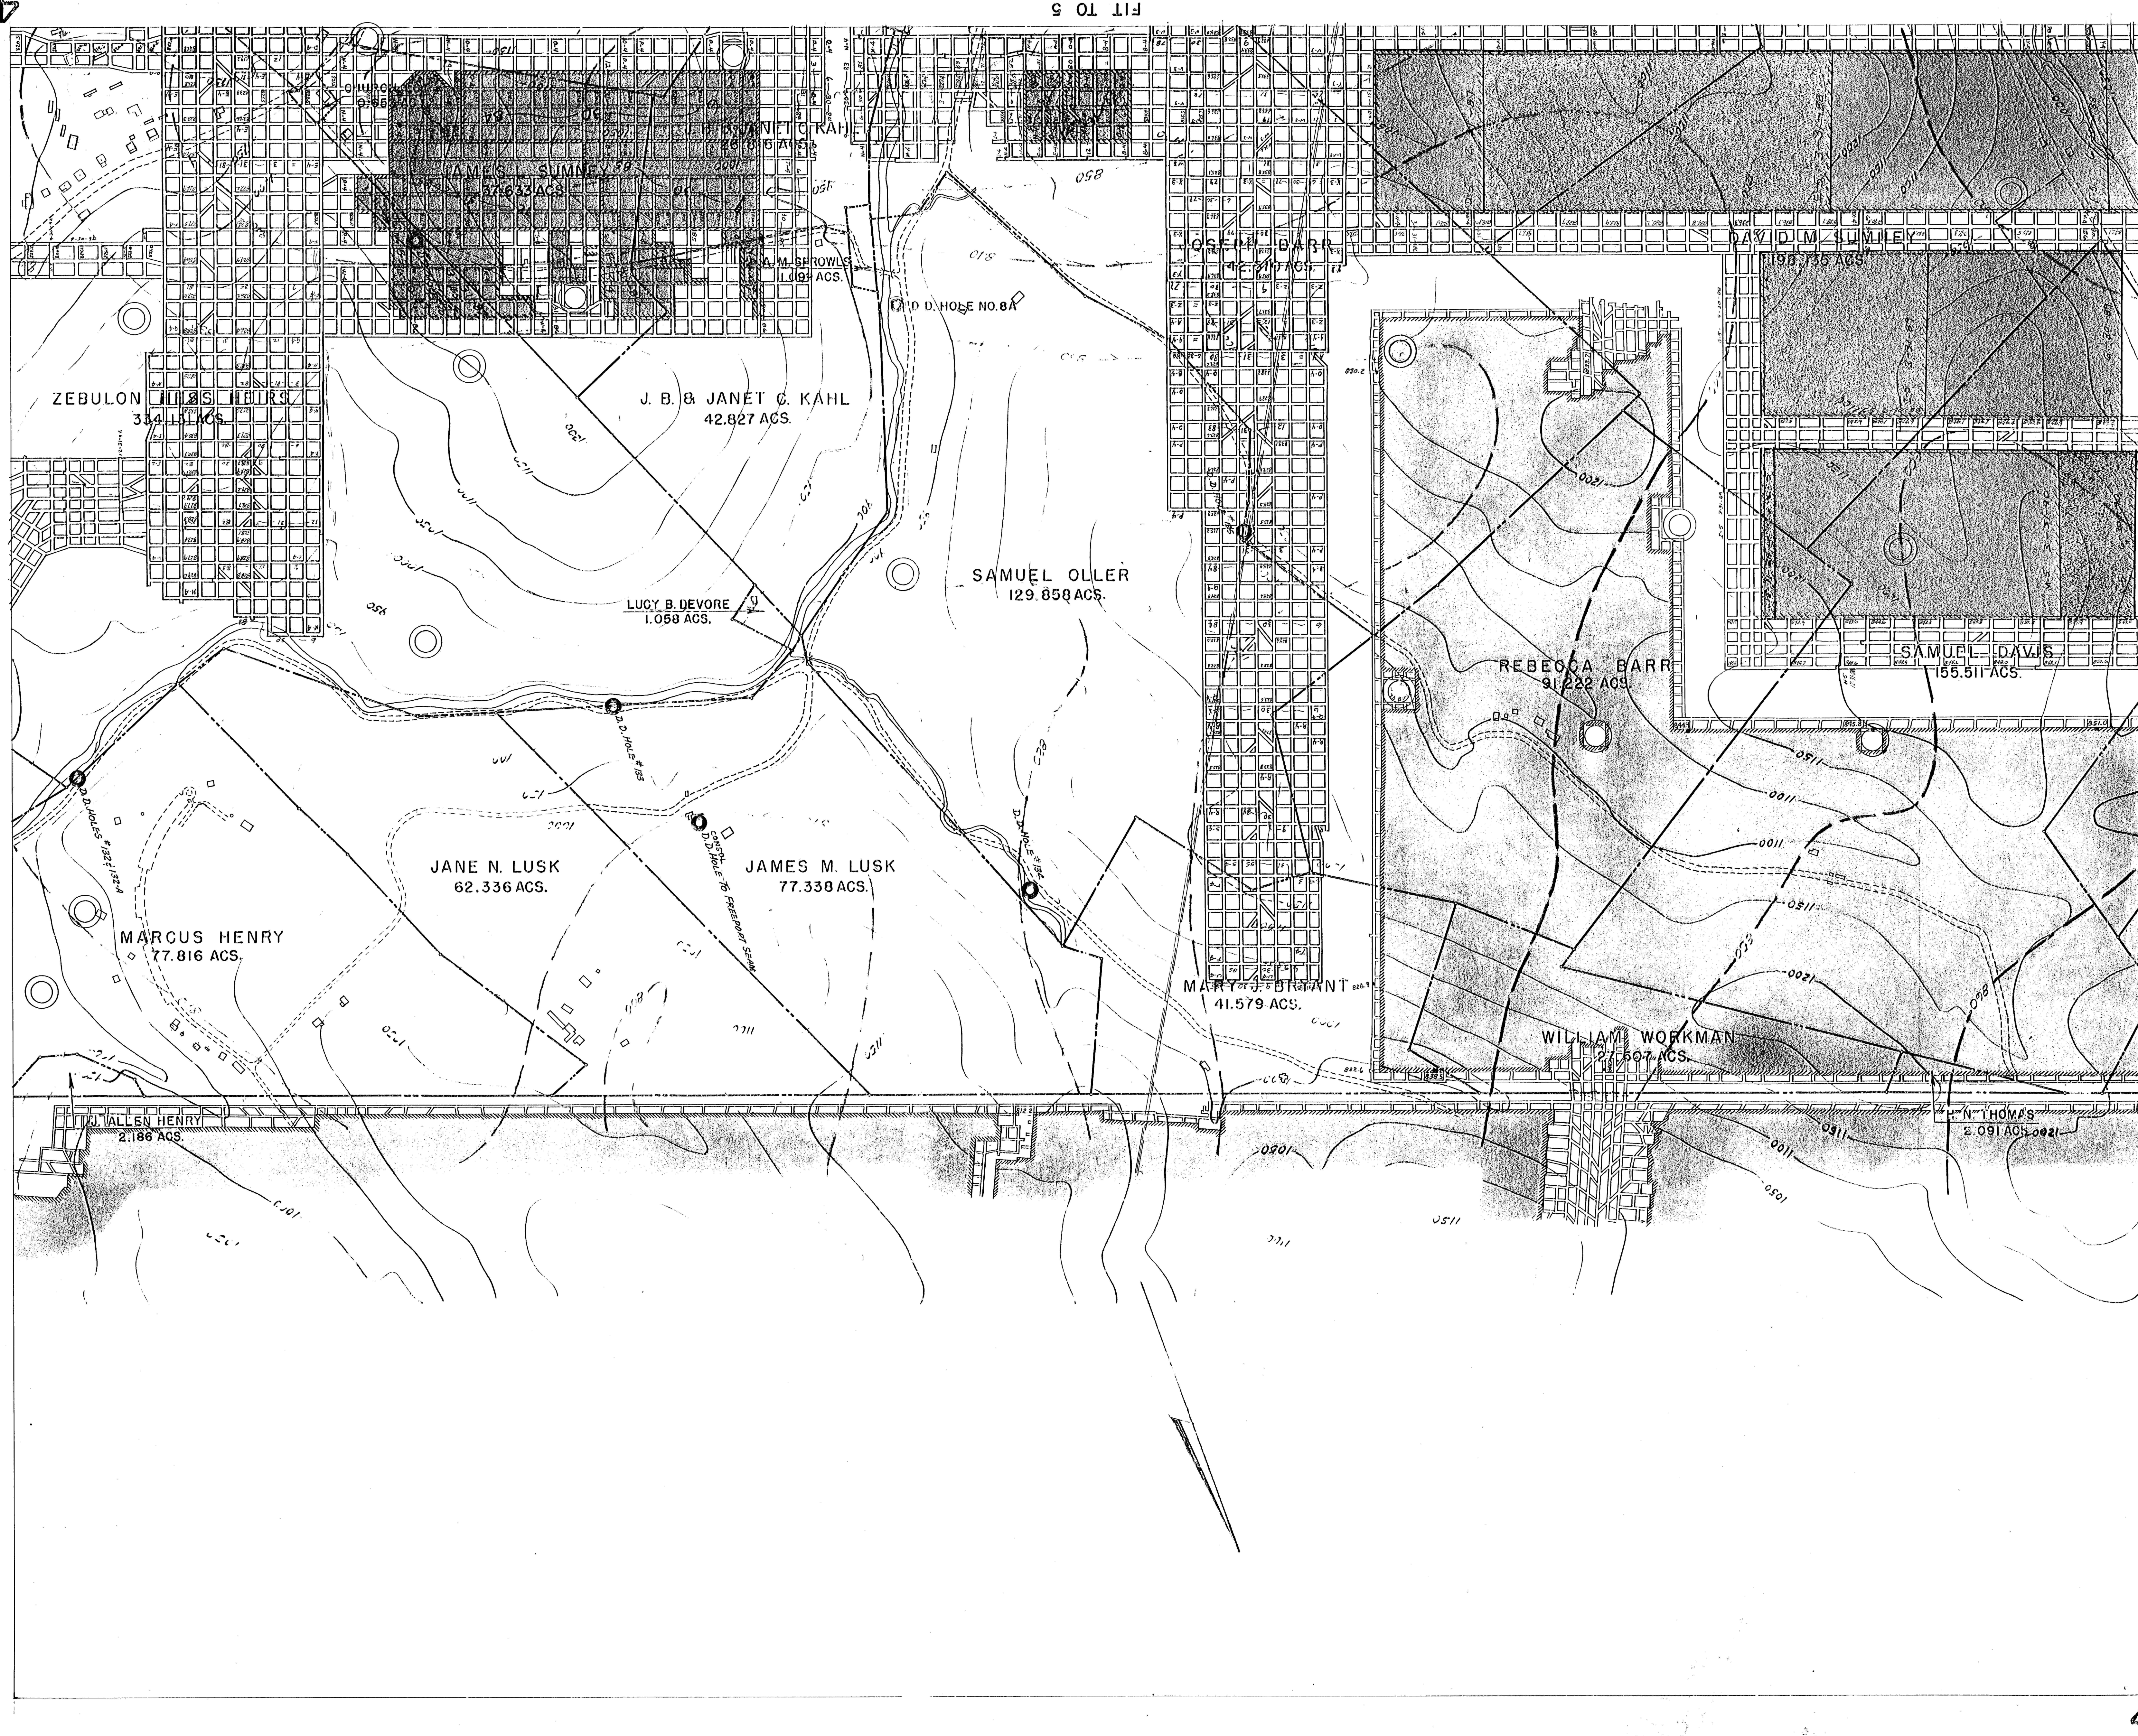

5 OF 114

FIT TO 1

4