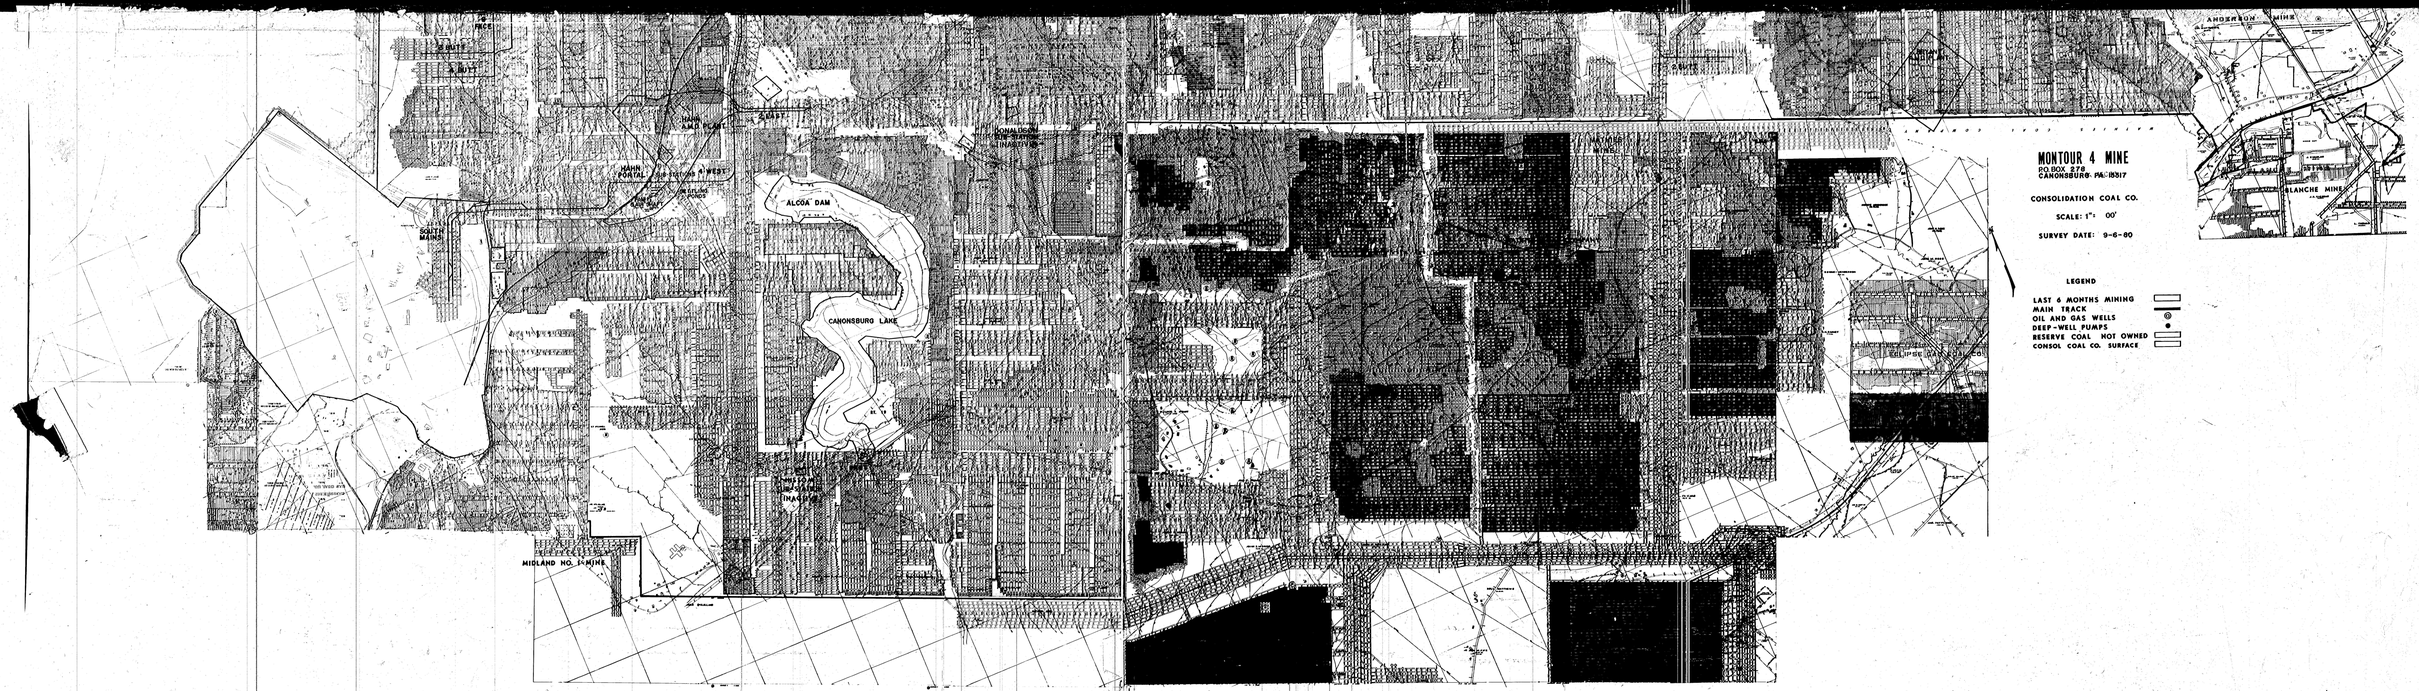
ALCOA DAM
CANONSBURG LAKE
MIDLAND NO. 1 MINE
ANDERSON MINE
BLANCHE MINE
ECLIPSE DAM
MONTOUR 4 MINE
P.O. BOX 278
CANONSBURG, PA. 15317
CONSOLIDATION COAL CO.
SCALE: 1" = 00'
SURVEY DATE: 9-6-80
LEGEND
LAST 6 MONTHS MINING
MAIN TRACK
OIL AND GAS WELLS
DEEP-WELL PUMPS
RESERVE COAL NOT OWNED
CONSOL COAL CO. SURFACE