


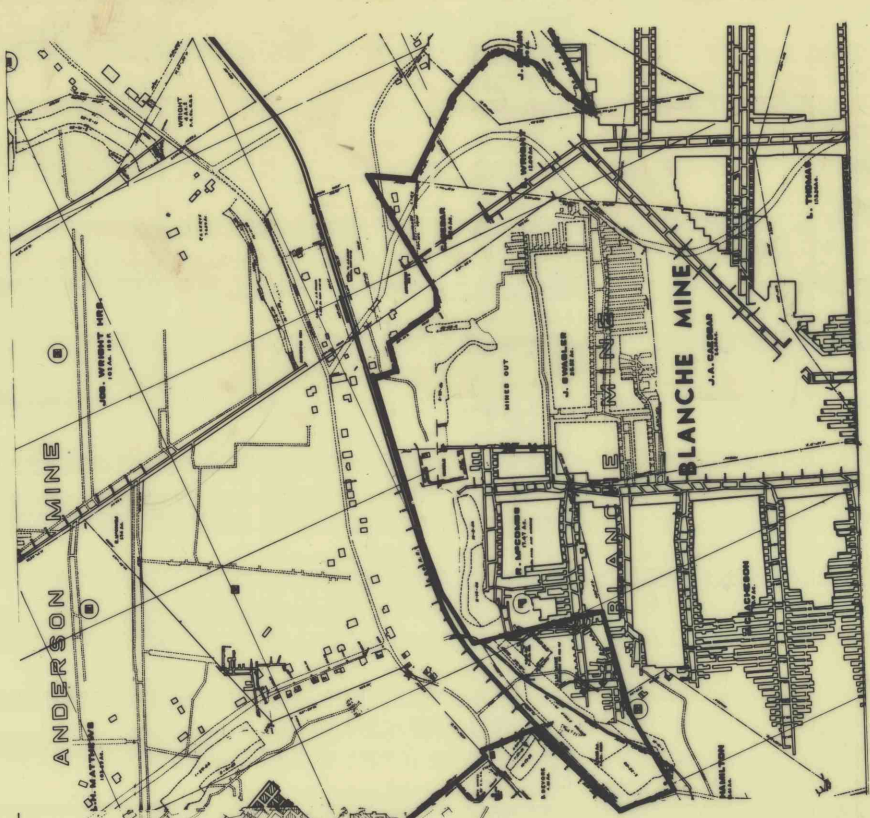

MONTOUR 4 MINE
P.O. BOX 278
CANONSBURG, PA. 15317

CONSOLIDATION COAL CO.

SCALE: 1" = 100'

SURVEY DATE: 9-6-80

LEGEND

- LAST 6 MONTHS MINING
- MAIN TRACK
- OIL AND GAS WELLS
- DEEP-WELL PUMPS
- RESERVE COAL
- NOT OWNED
- CONSOL COAL CO. SURFACE

