


140

MATHIES MINE K-5618


FIT TO K-5628

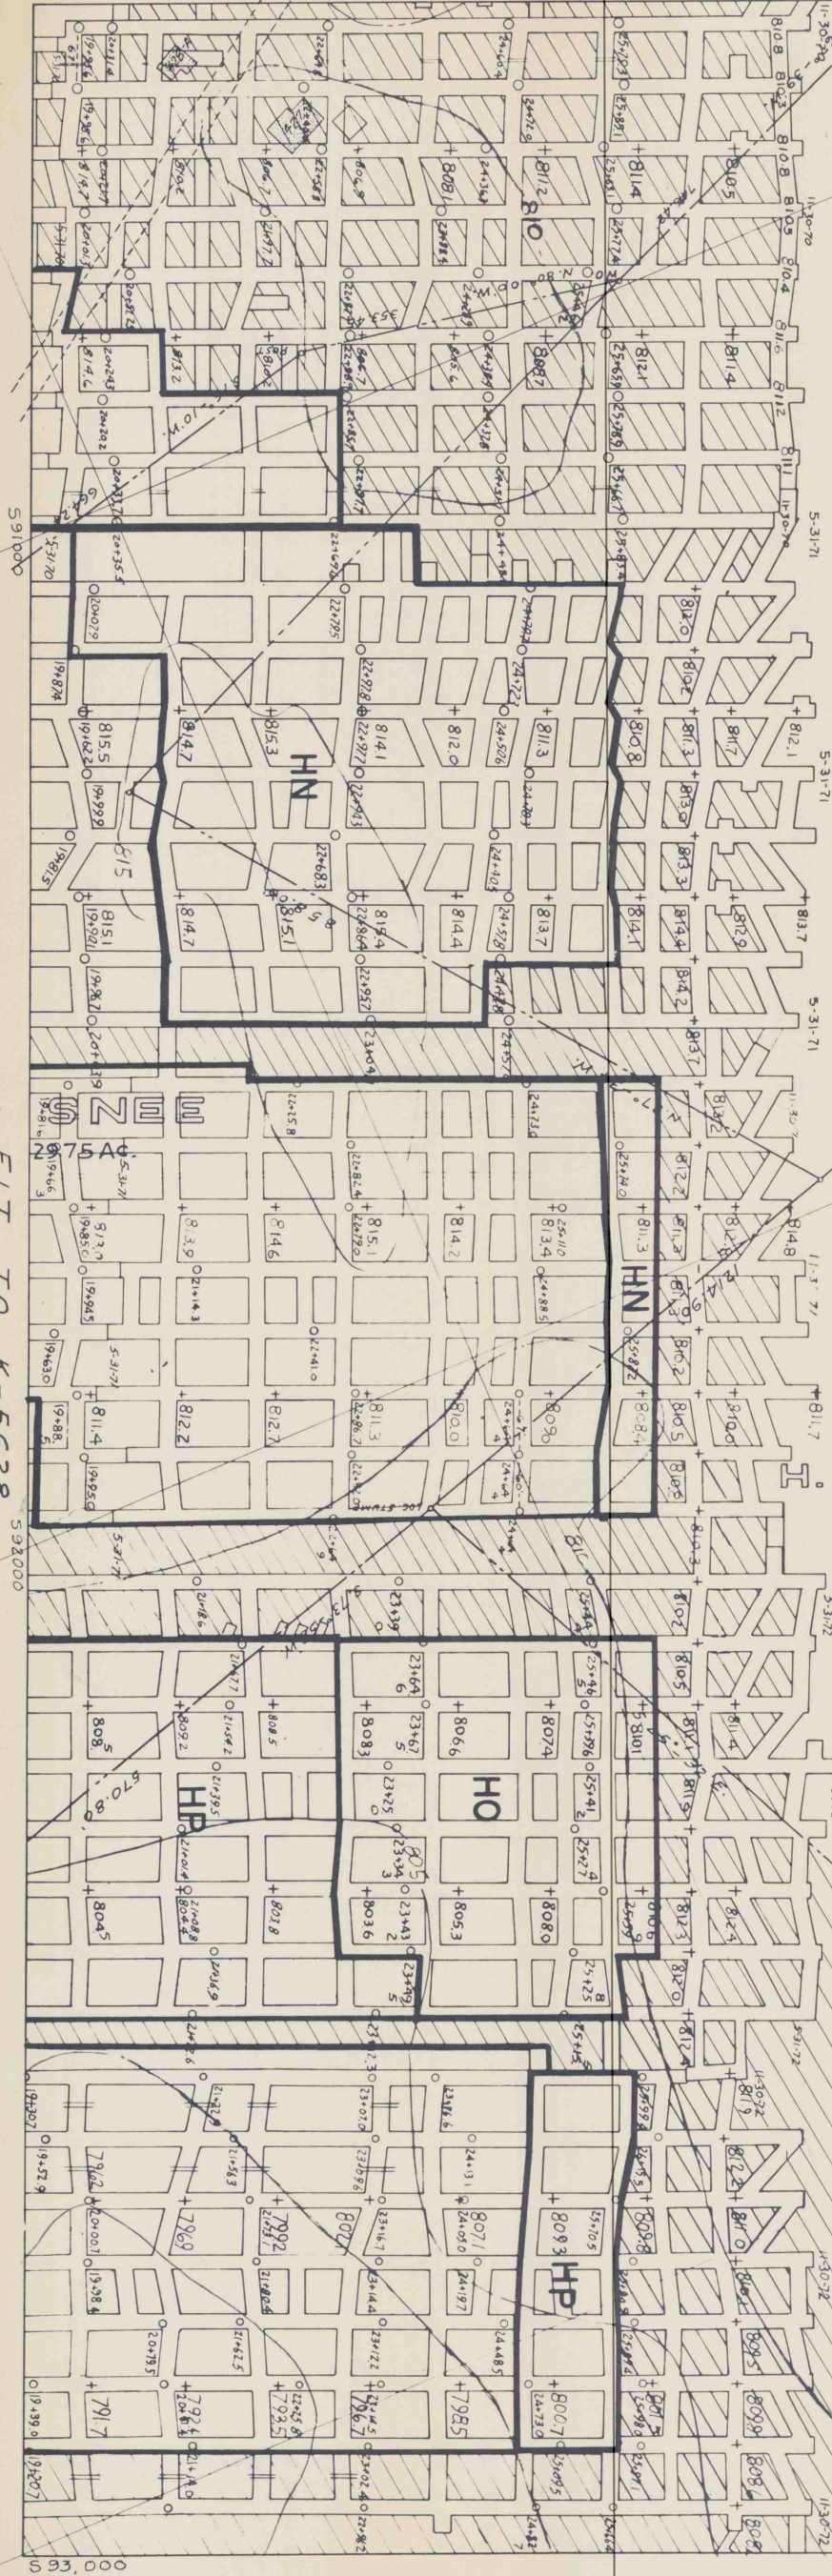

COWAN - HENDERSON
30.0 AC.

H.H. RAINEY
17.11 AC.

FIT TO 5671

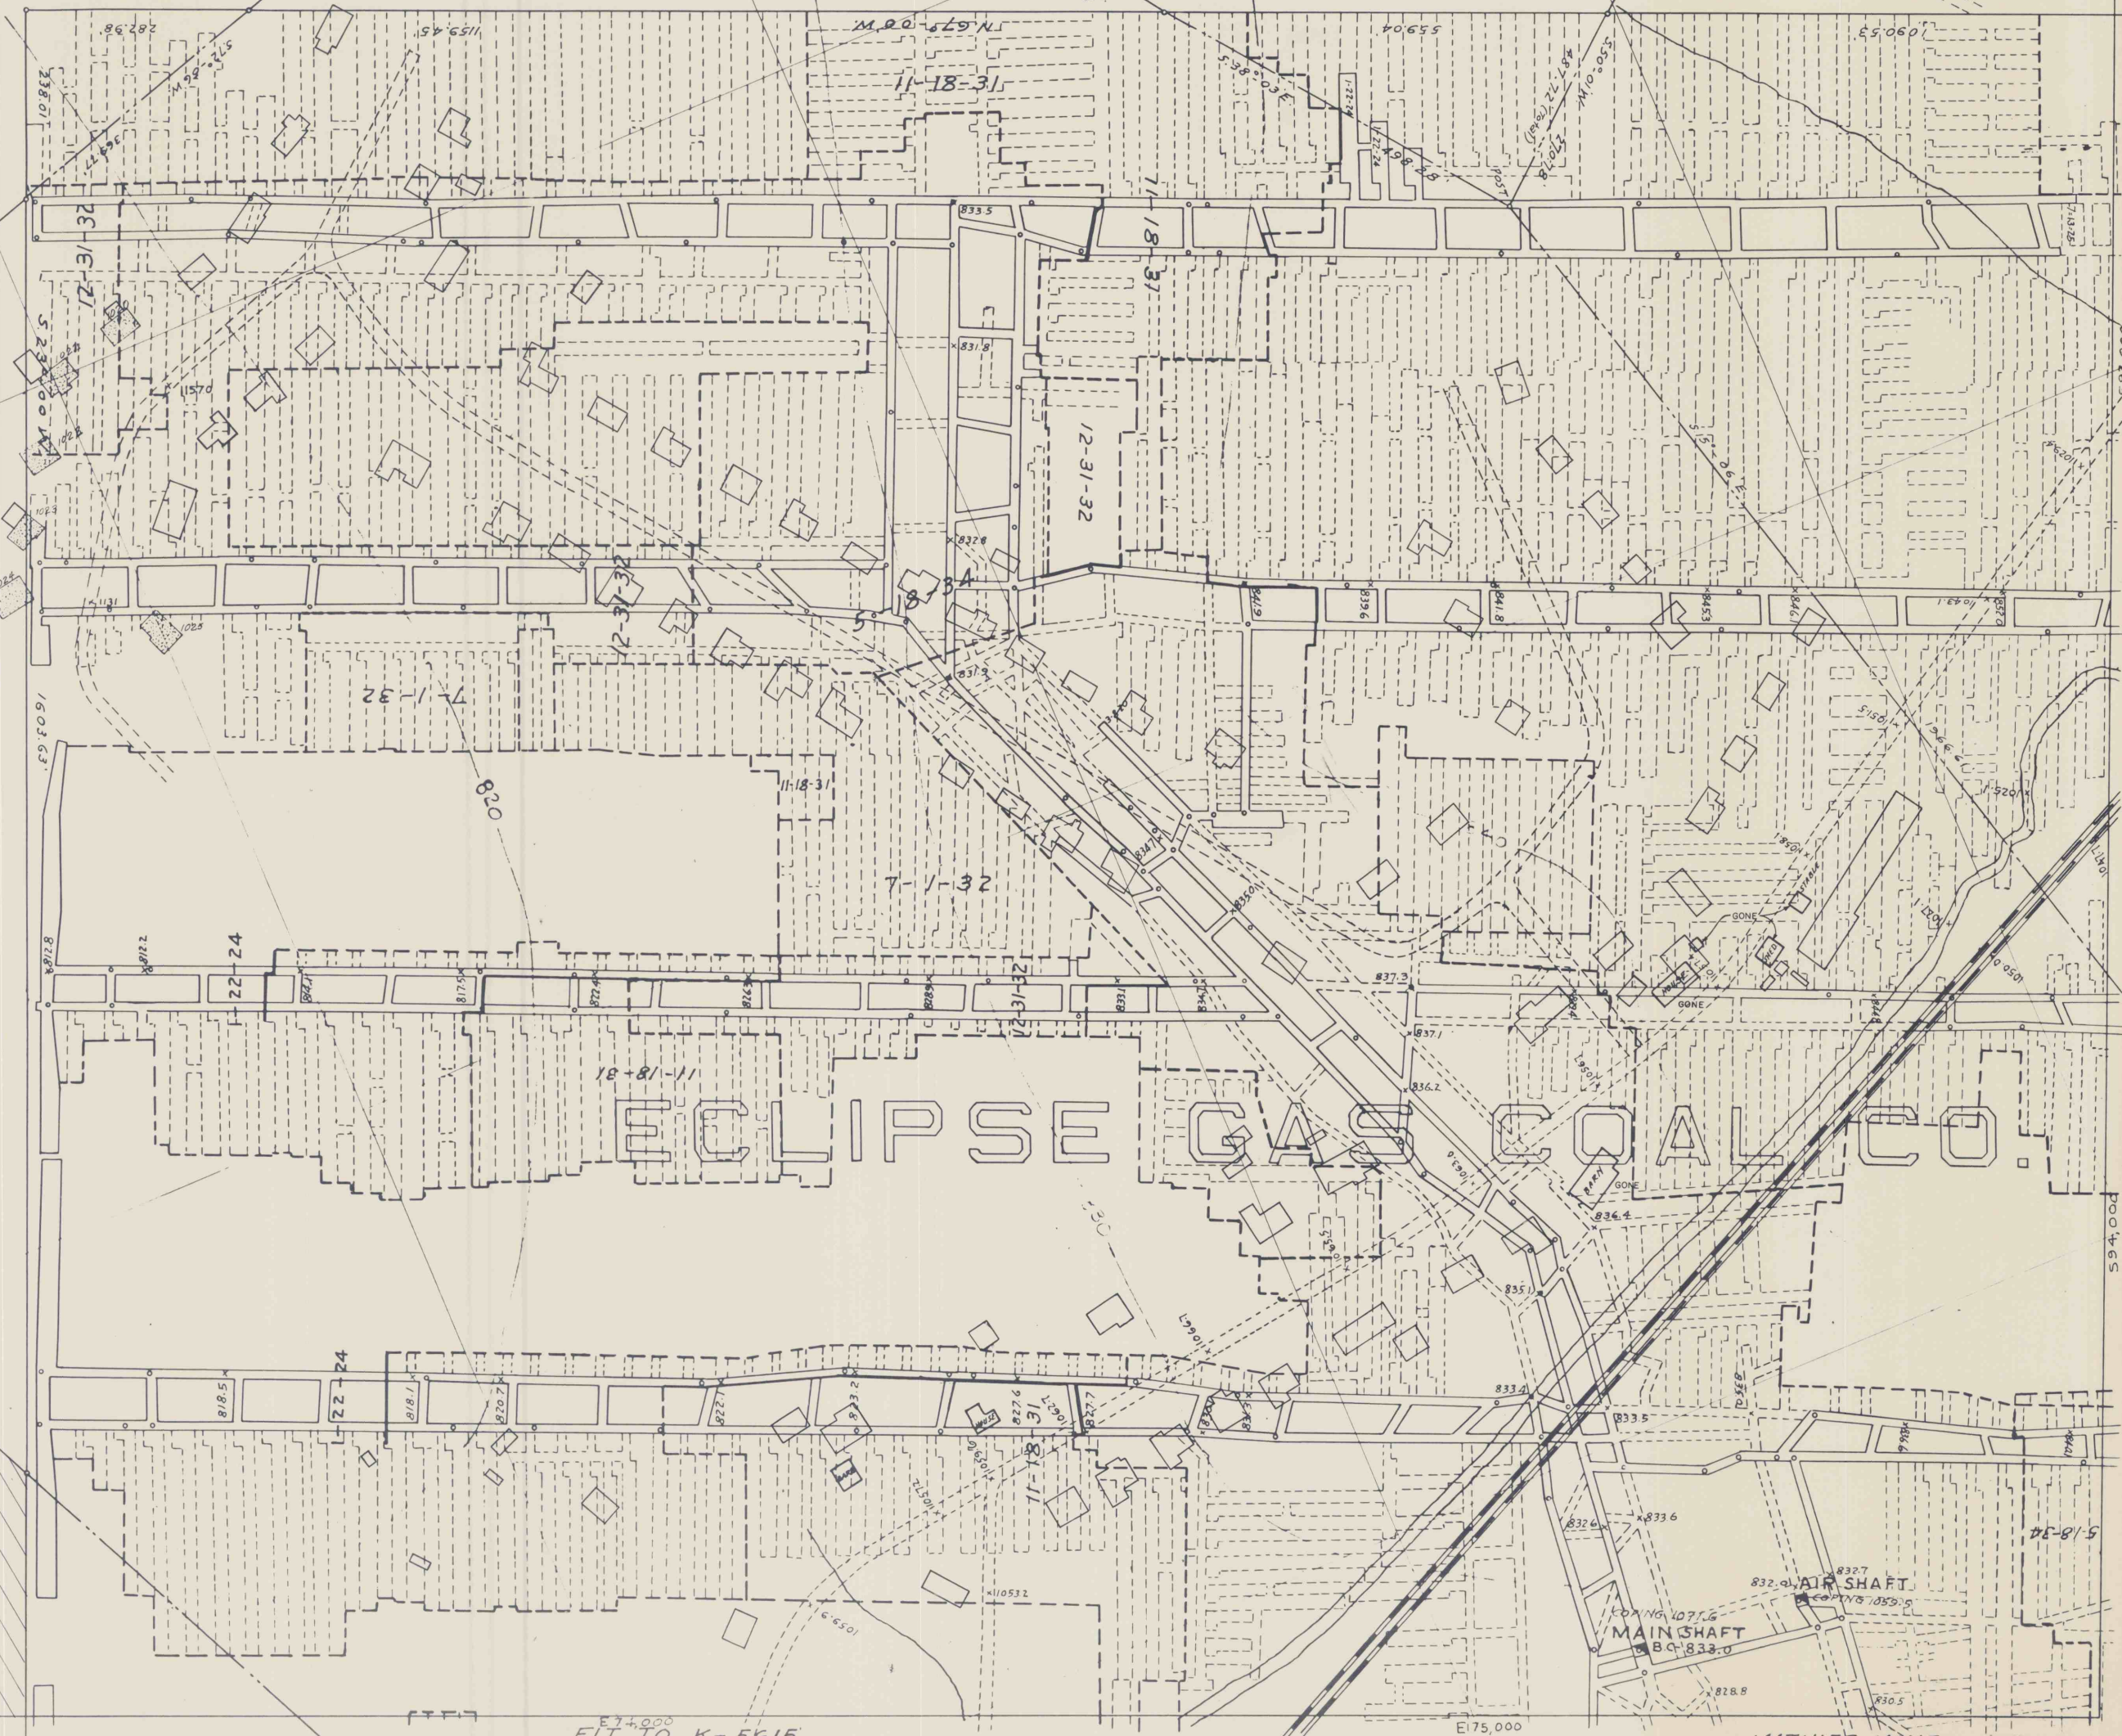

JOHN M. ROSS
48.75 AC.

H.H. RAINEY
4.12 AC.

ECLIPSE GAS COAL CO.

MAIN SHAFT
AIR SHAFT

MATHIES MINE K-5618