


MATHIES MINE K-5650

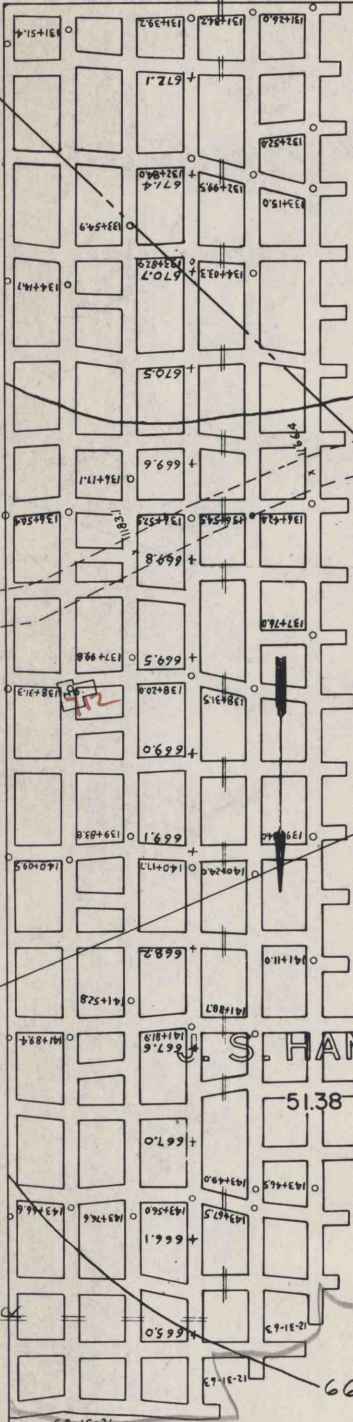

670

S. HAMILTON  
51.38 ACS.

665

HIRAM WARNE HRS  
215.59 ACS.

Fit to K-5649

2601

N 19° 34' 30" E

4.15 AC

MATHIES MINE K-5650

OK