


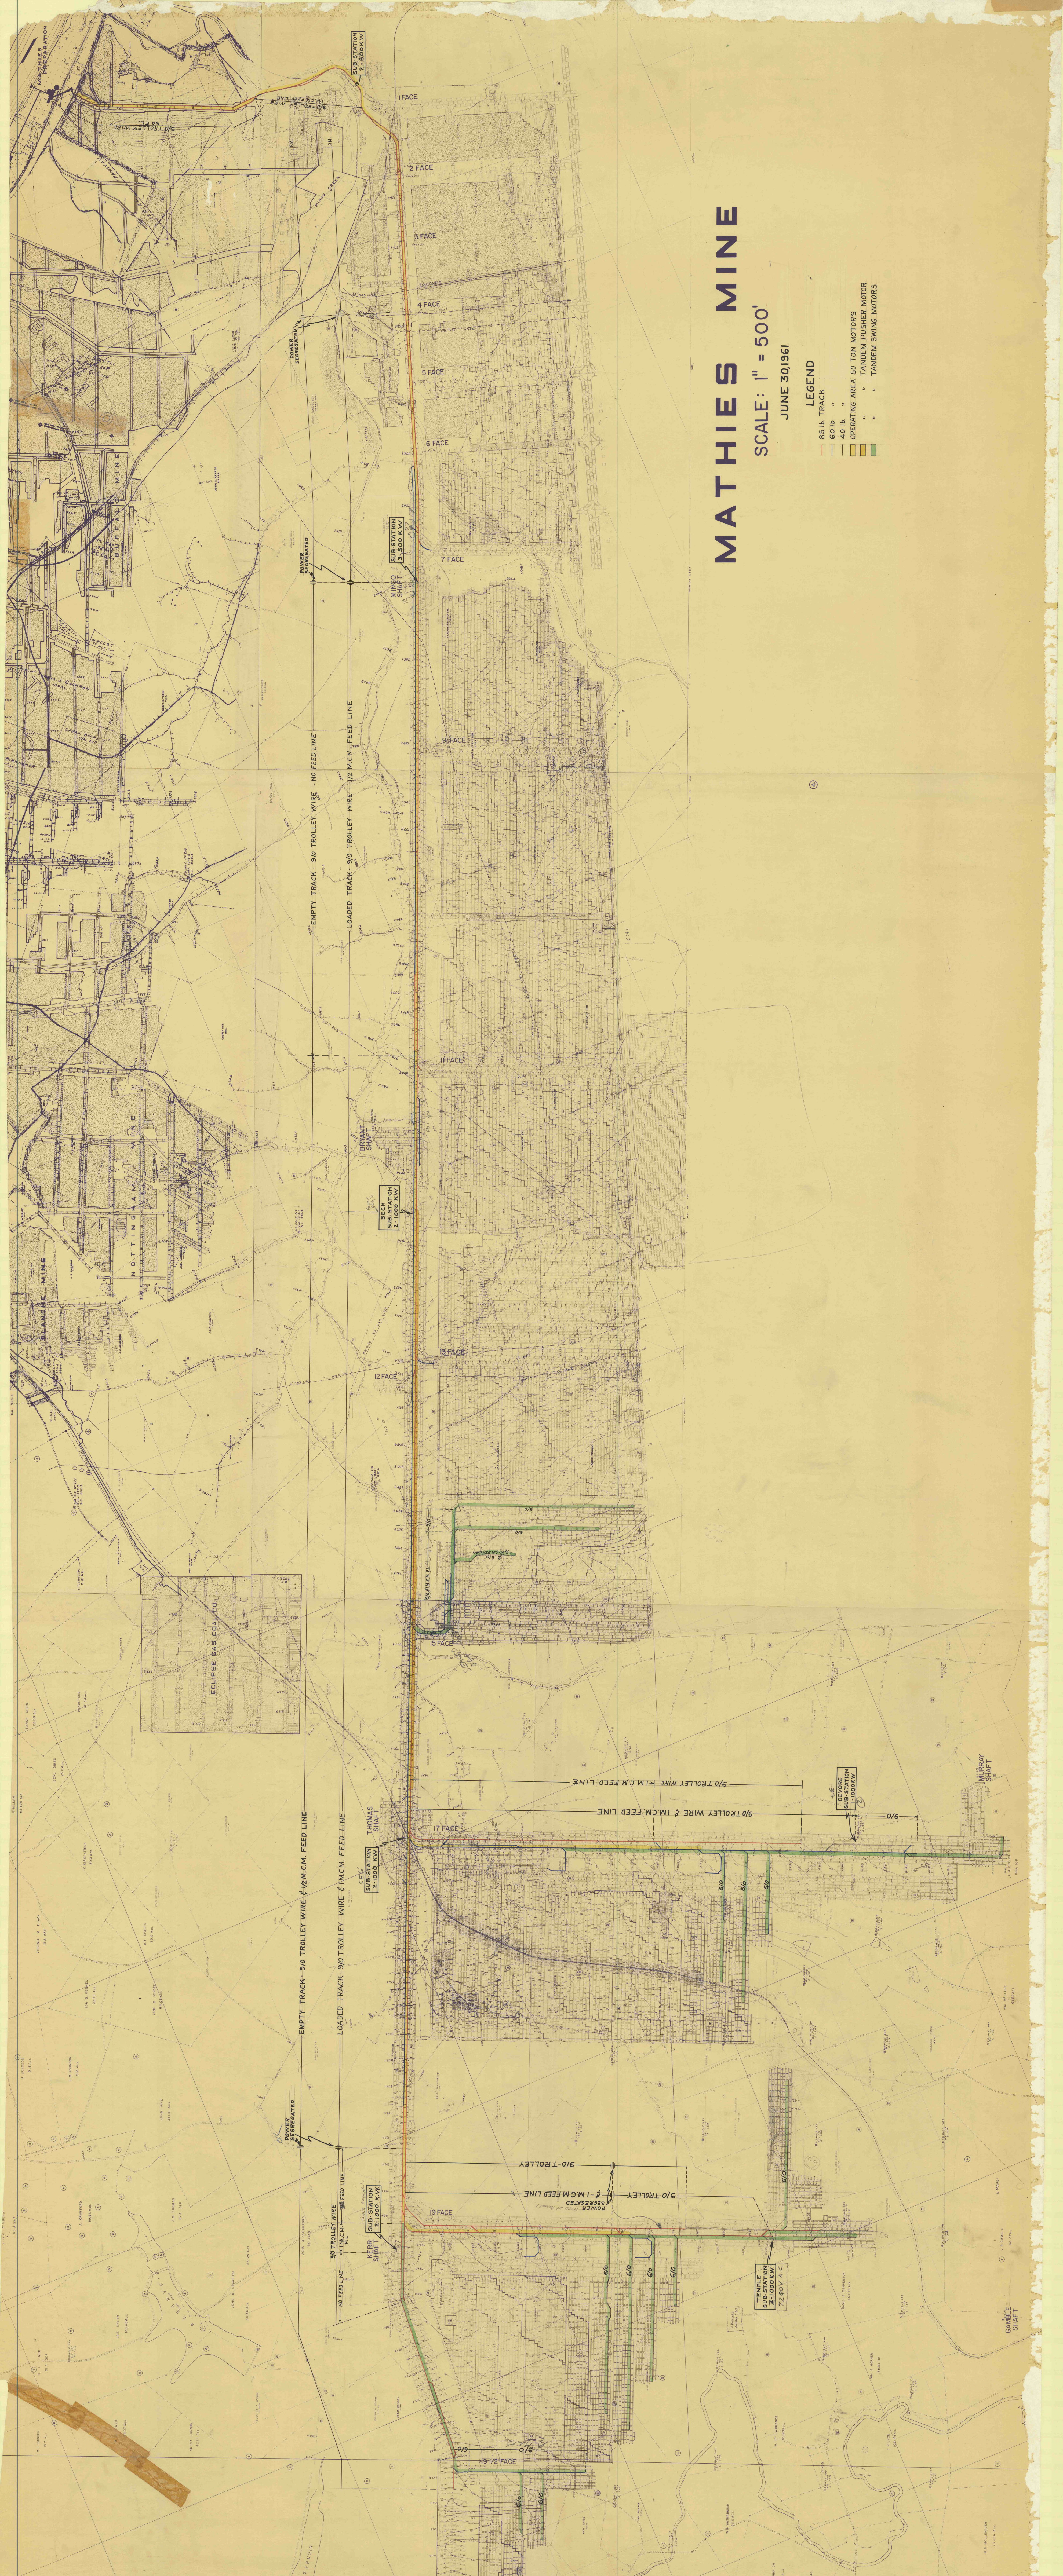

MATHIES MINE

SCALE: 1" = 500'

JUNE 30, 1961

LEGEND

- 85 lb. TRACK
- 60 lb. "
- 40 lb. "
- OPERATING AREA 50 TON MOTORS
- TANDEM PUSHER MOTOR
- TANDEM SWING MOTORS