
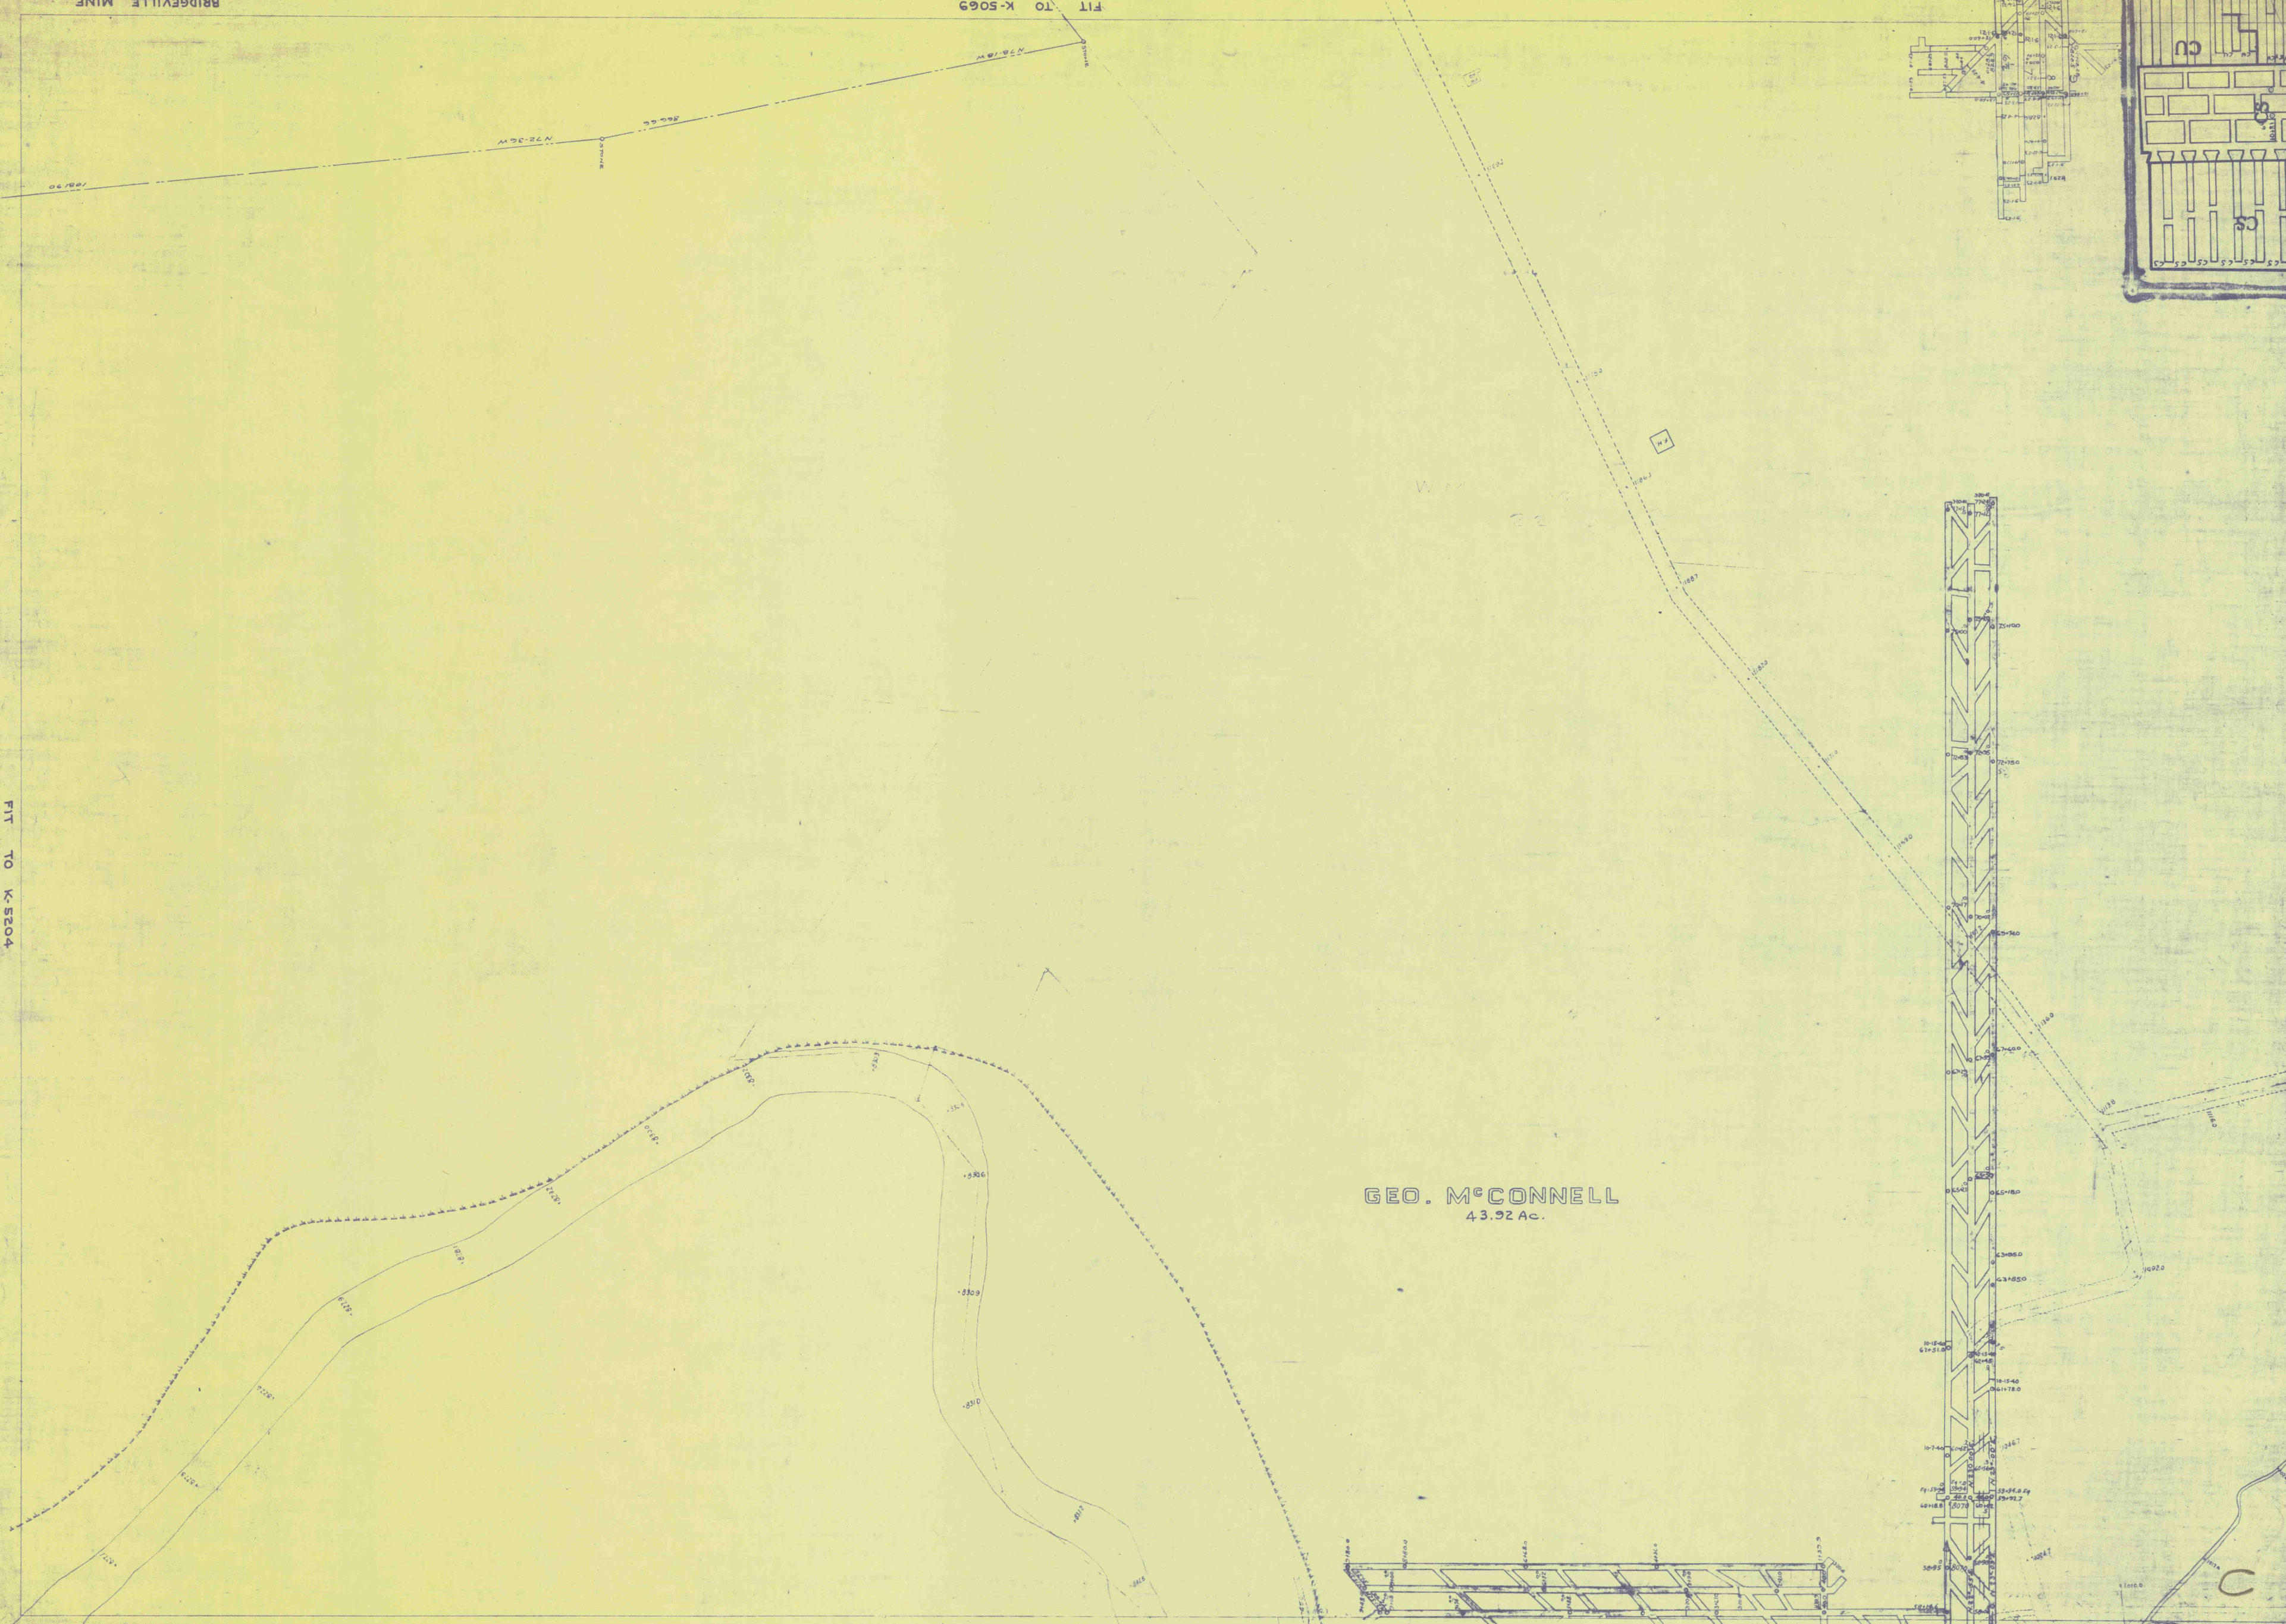


BRIDGEVILLE MINE
K-5205

FIT TO K-5069

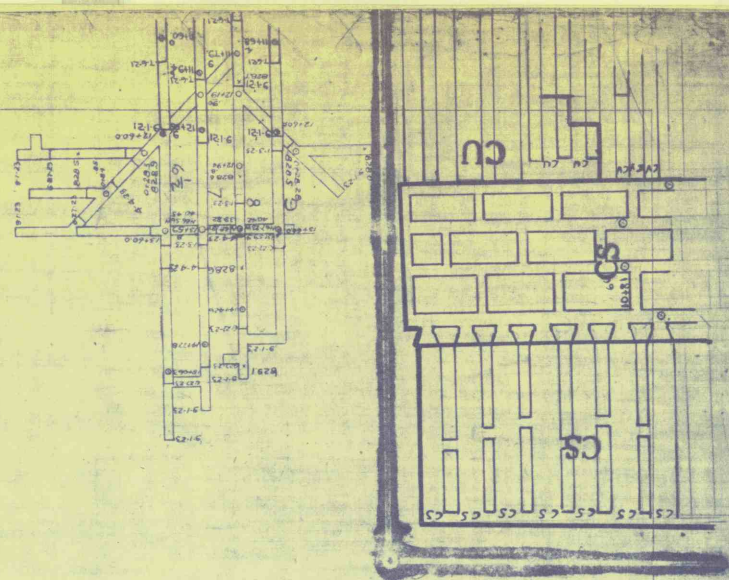

GEO. McCONNELL
43.92 Ac.

FIT TO K-5455

BRIDGEVILLE MINE
K-5205

FIT TO K-5206

FIT TO K-5204