


K-5060

HARRISON MINE

FIT TO K-5079

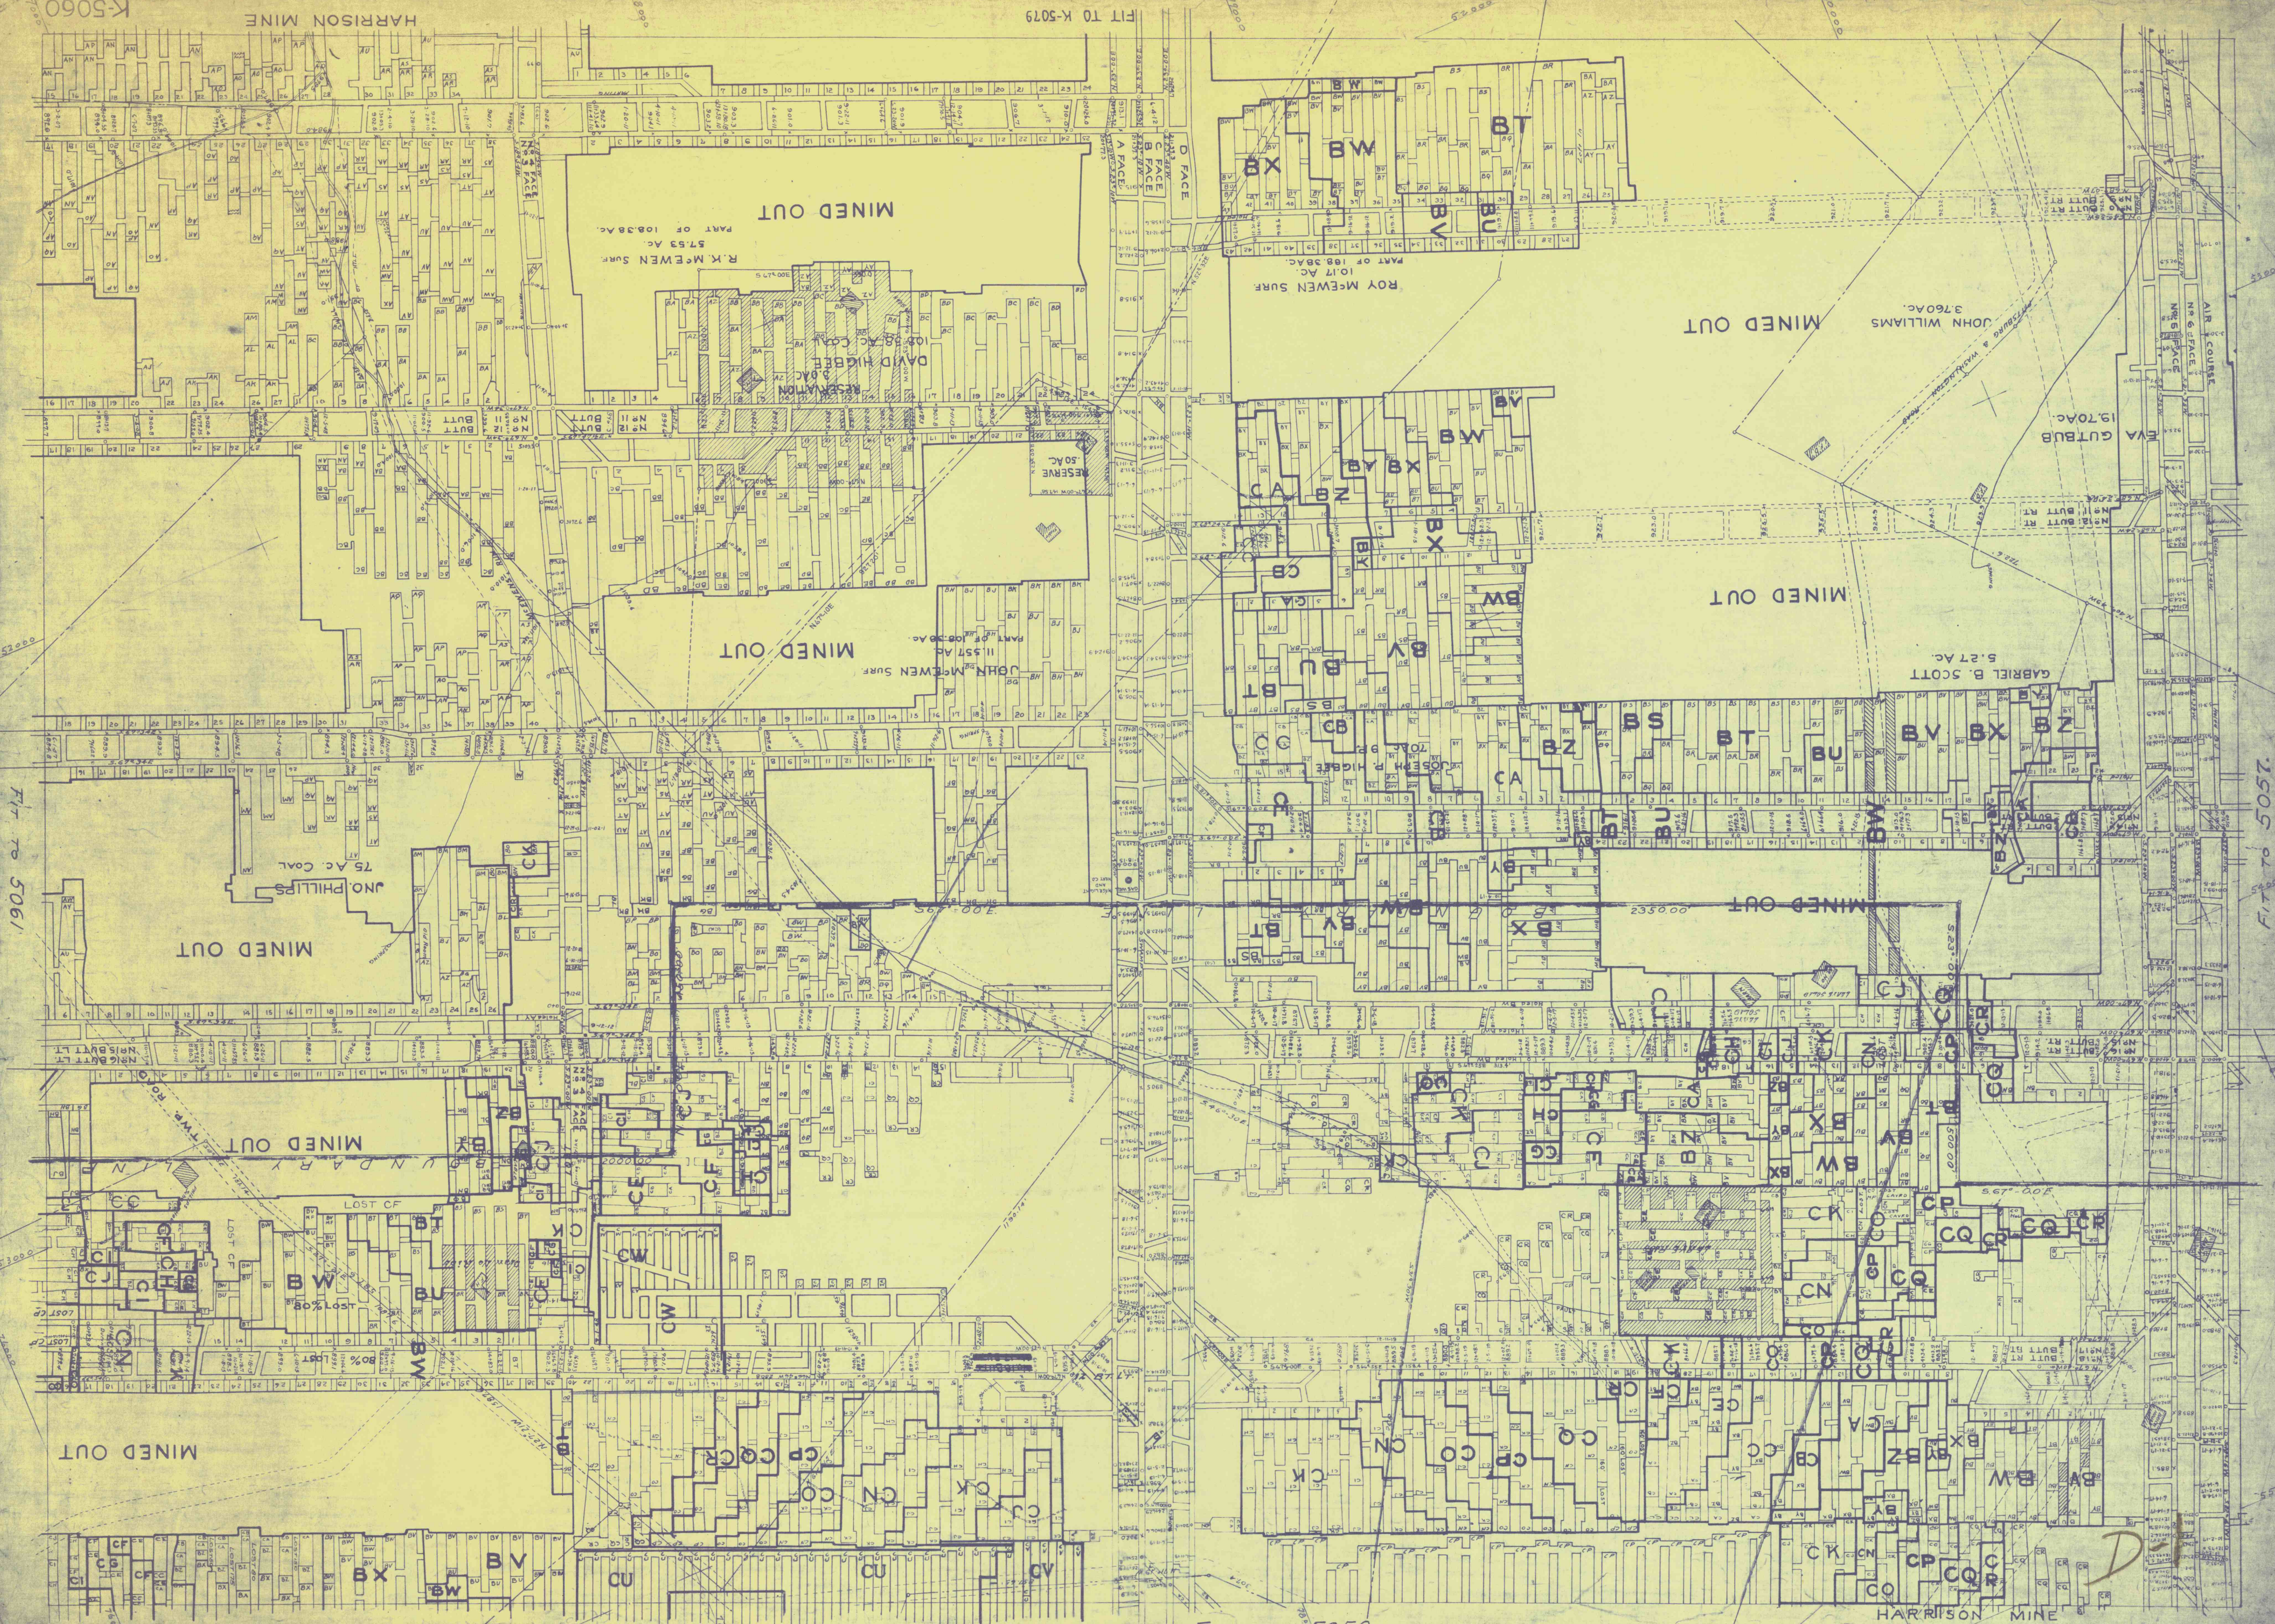

FIT TO 5061

FIT TO 5057

FIT TO 5059

HARRISON MINE

K-5060