


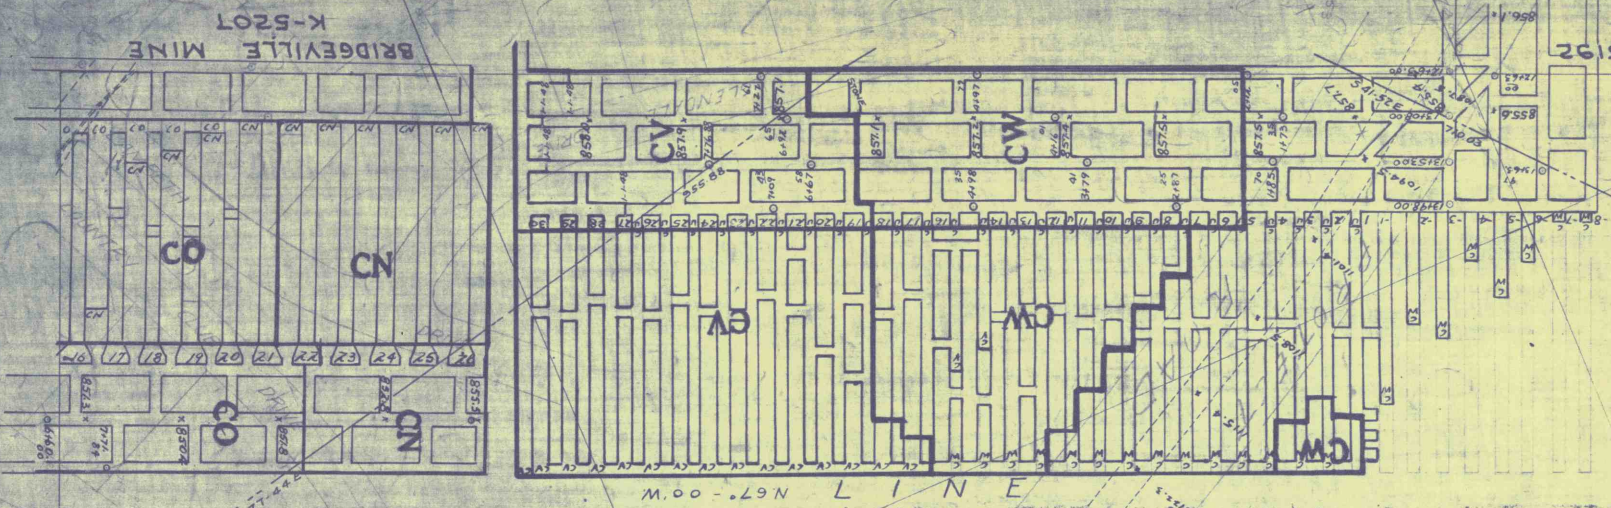

JOHN FIFE
55.74A.

NATHANIEL FIFE
72.63 A.

WILLIAM T. FIFE
210.917 A. COAL

EXCHANGE LINE BETWEEN FIFE & CO. AND F.C. CO.
S 23° 00' W 3501.45

FIT TO K-5457

BRIDGEVILLE MINE
K-5207