



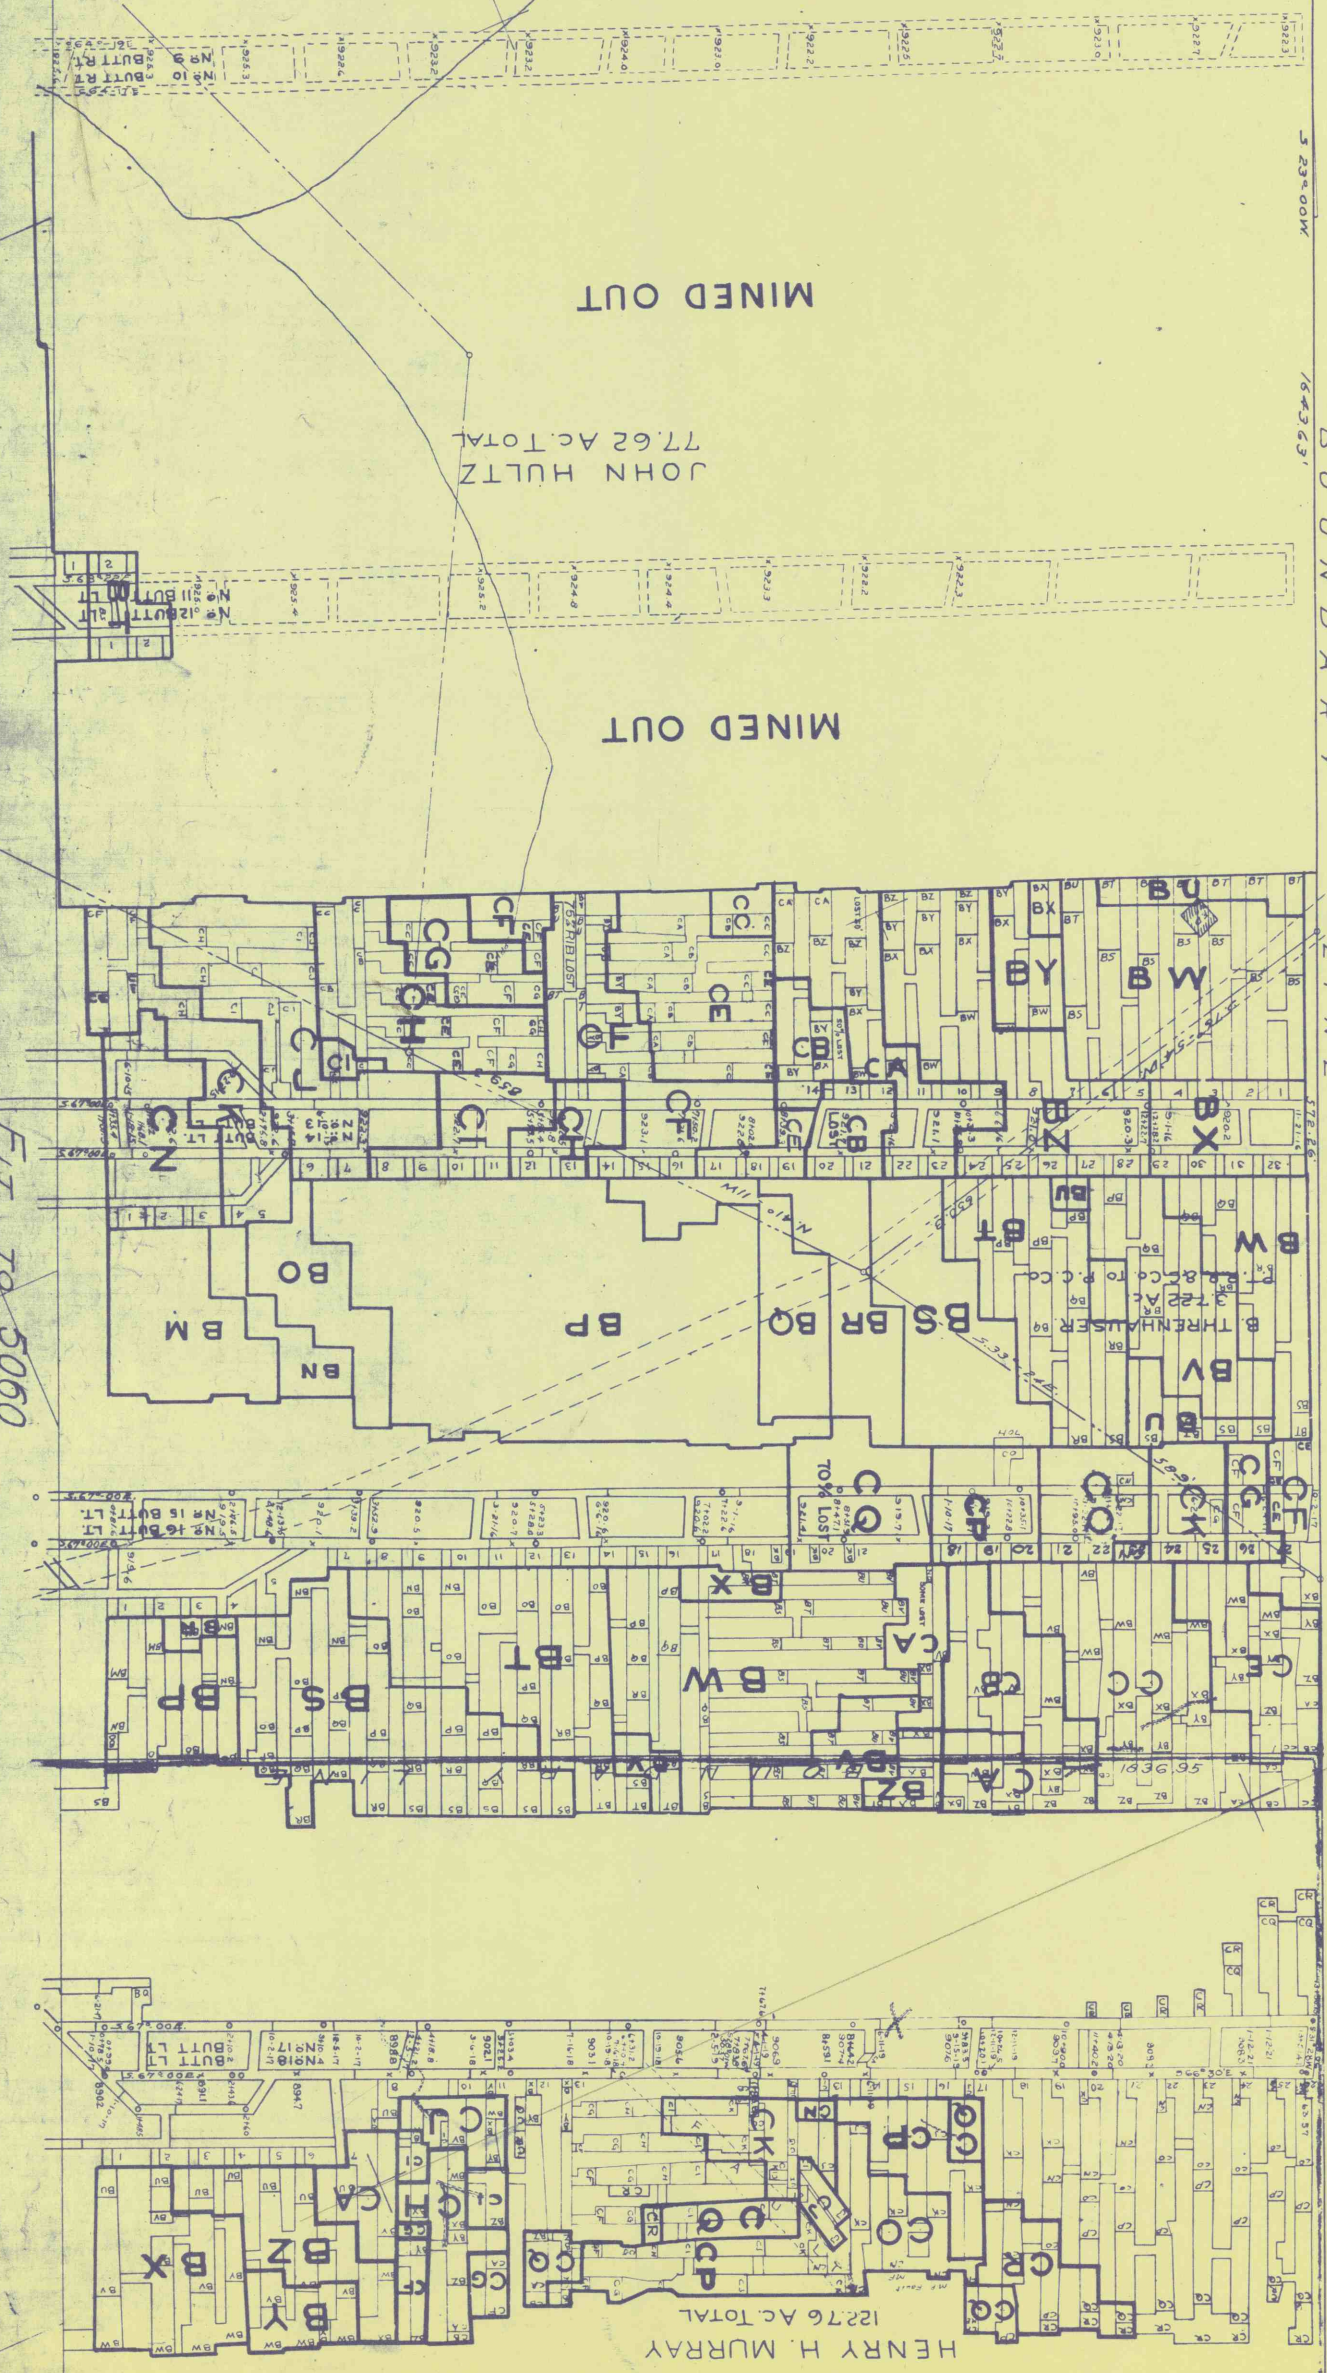

P.T.R.R. & C. Co.

MINE No. 3

BOUNDARY LINE

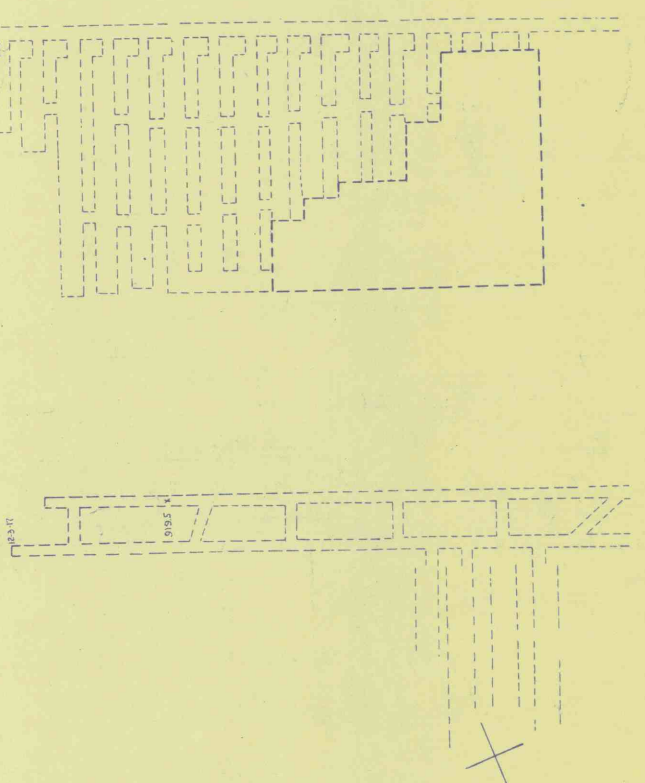

FIT TO 5060

FIT TO 5058