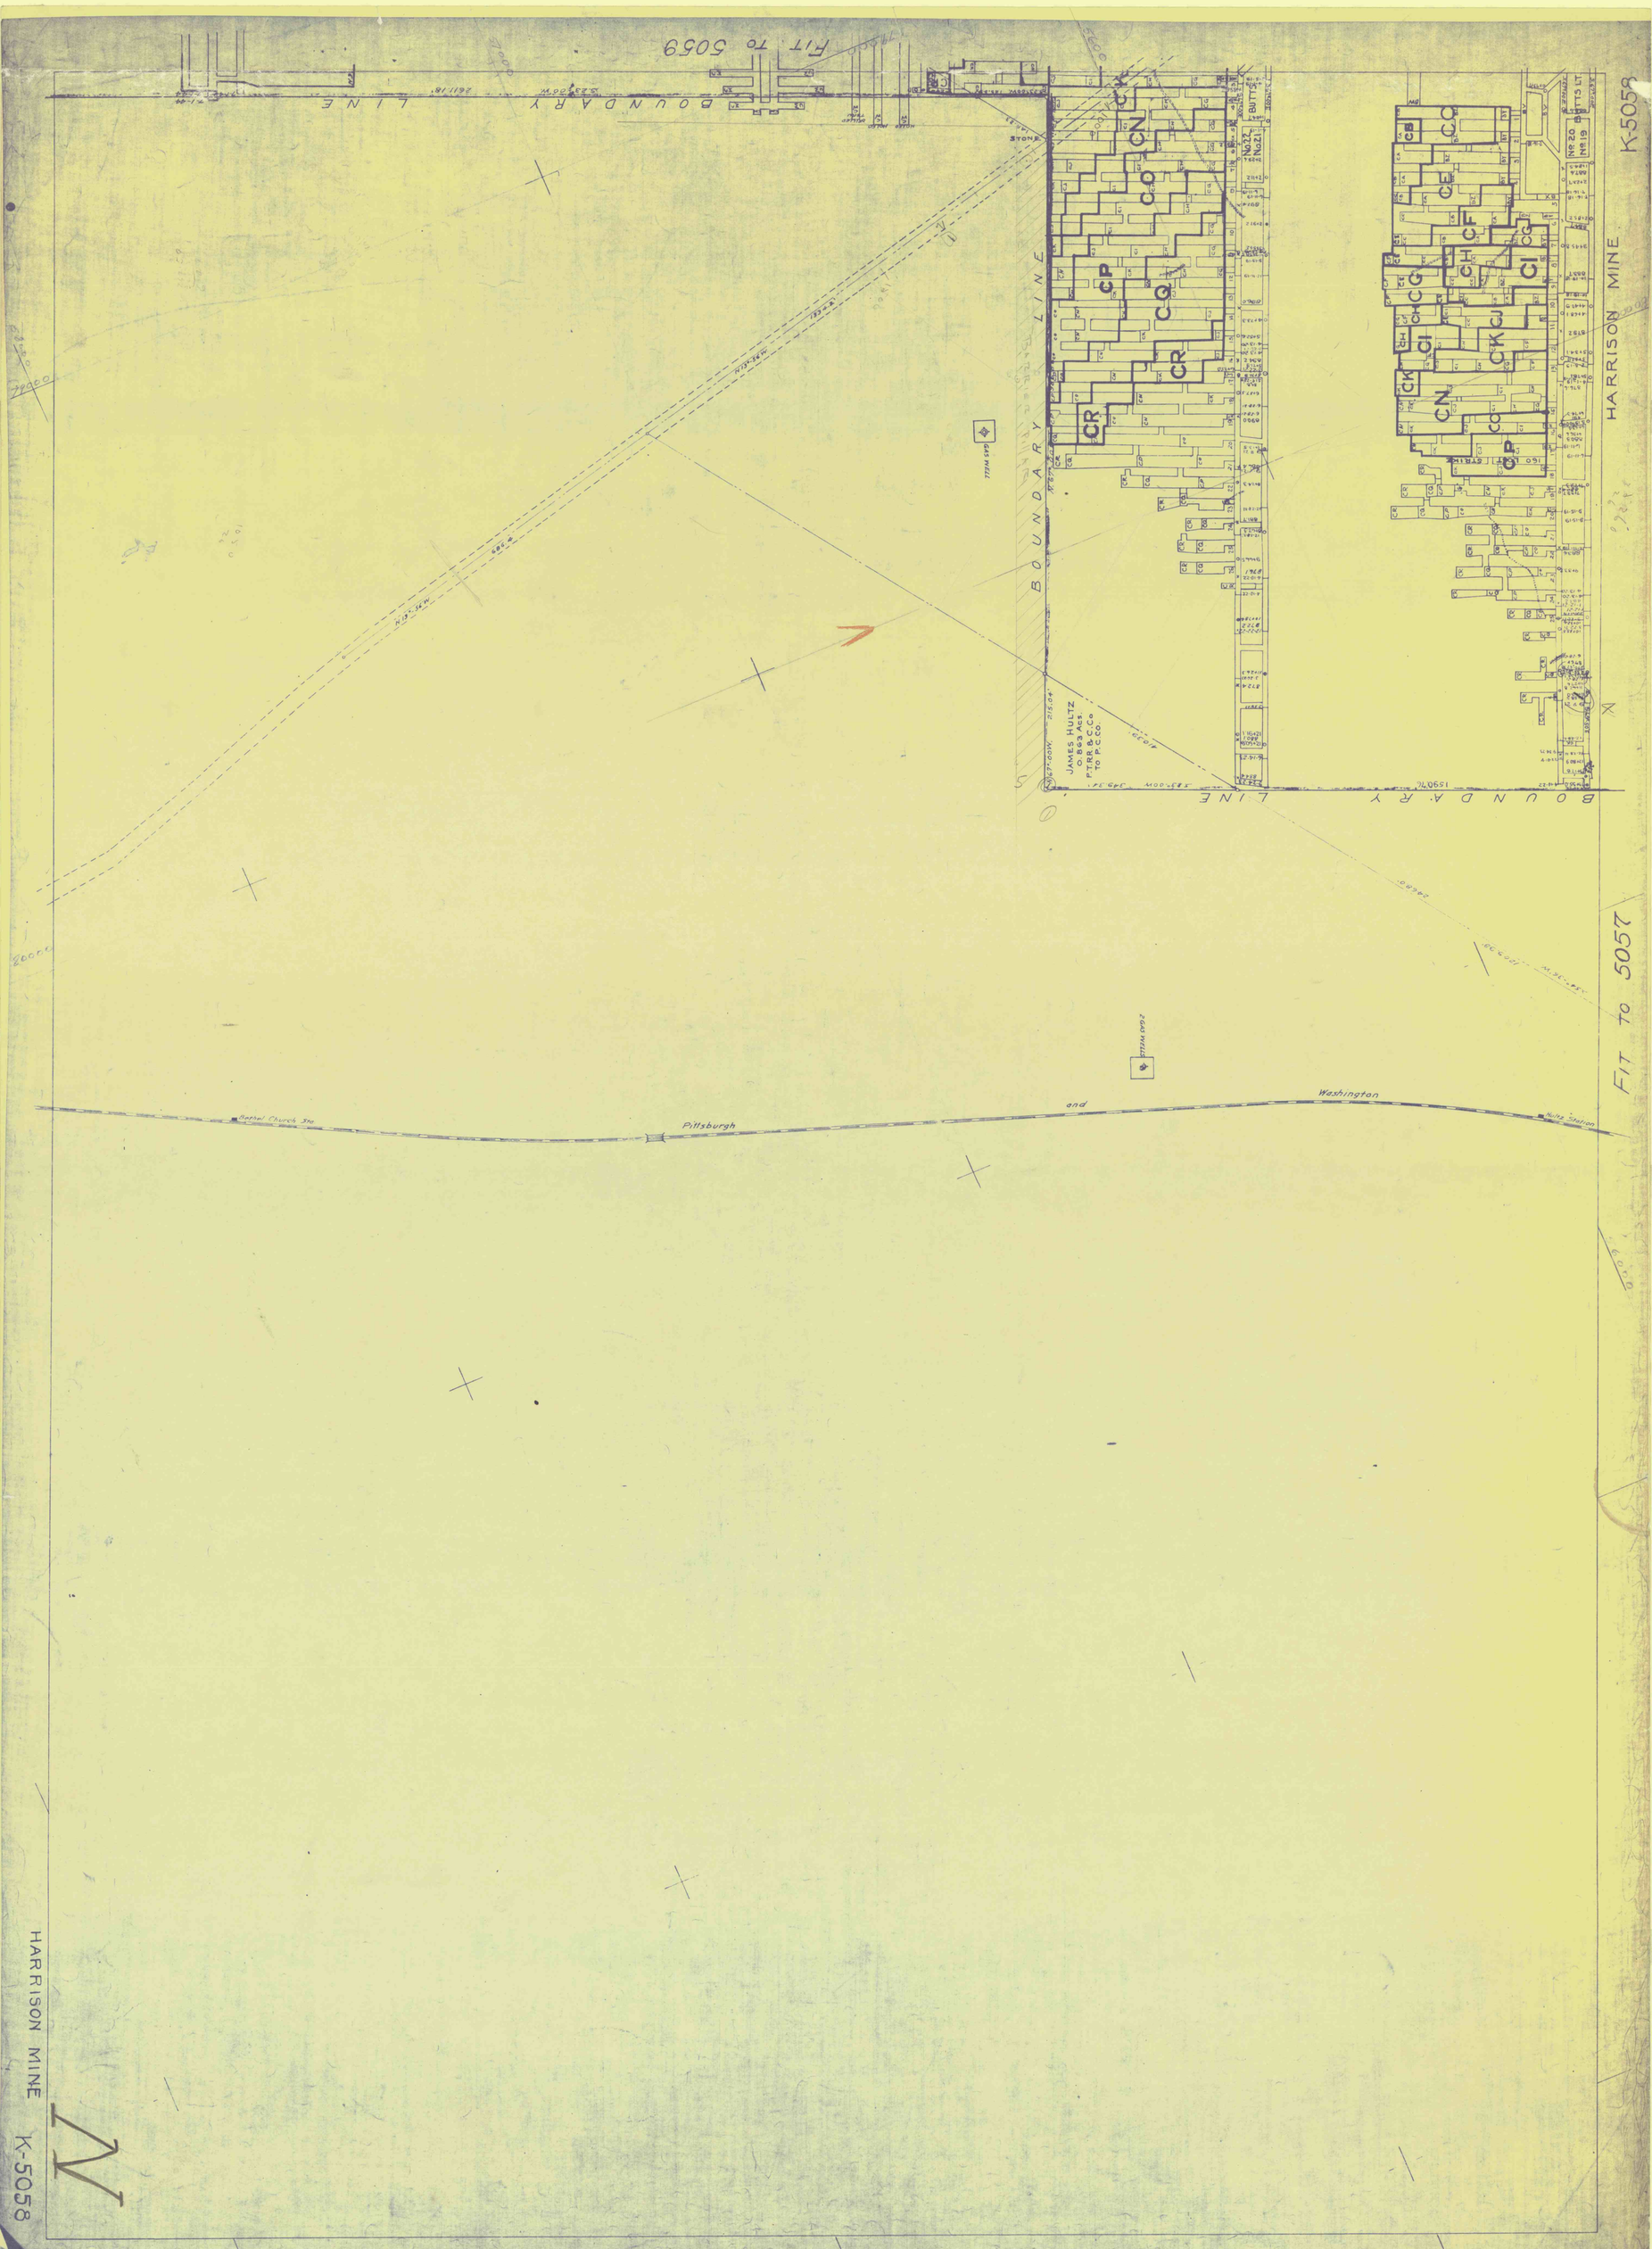

HARRISON MINE
K-5058