


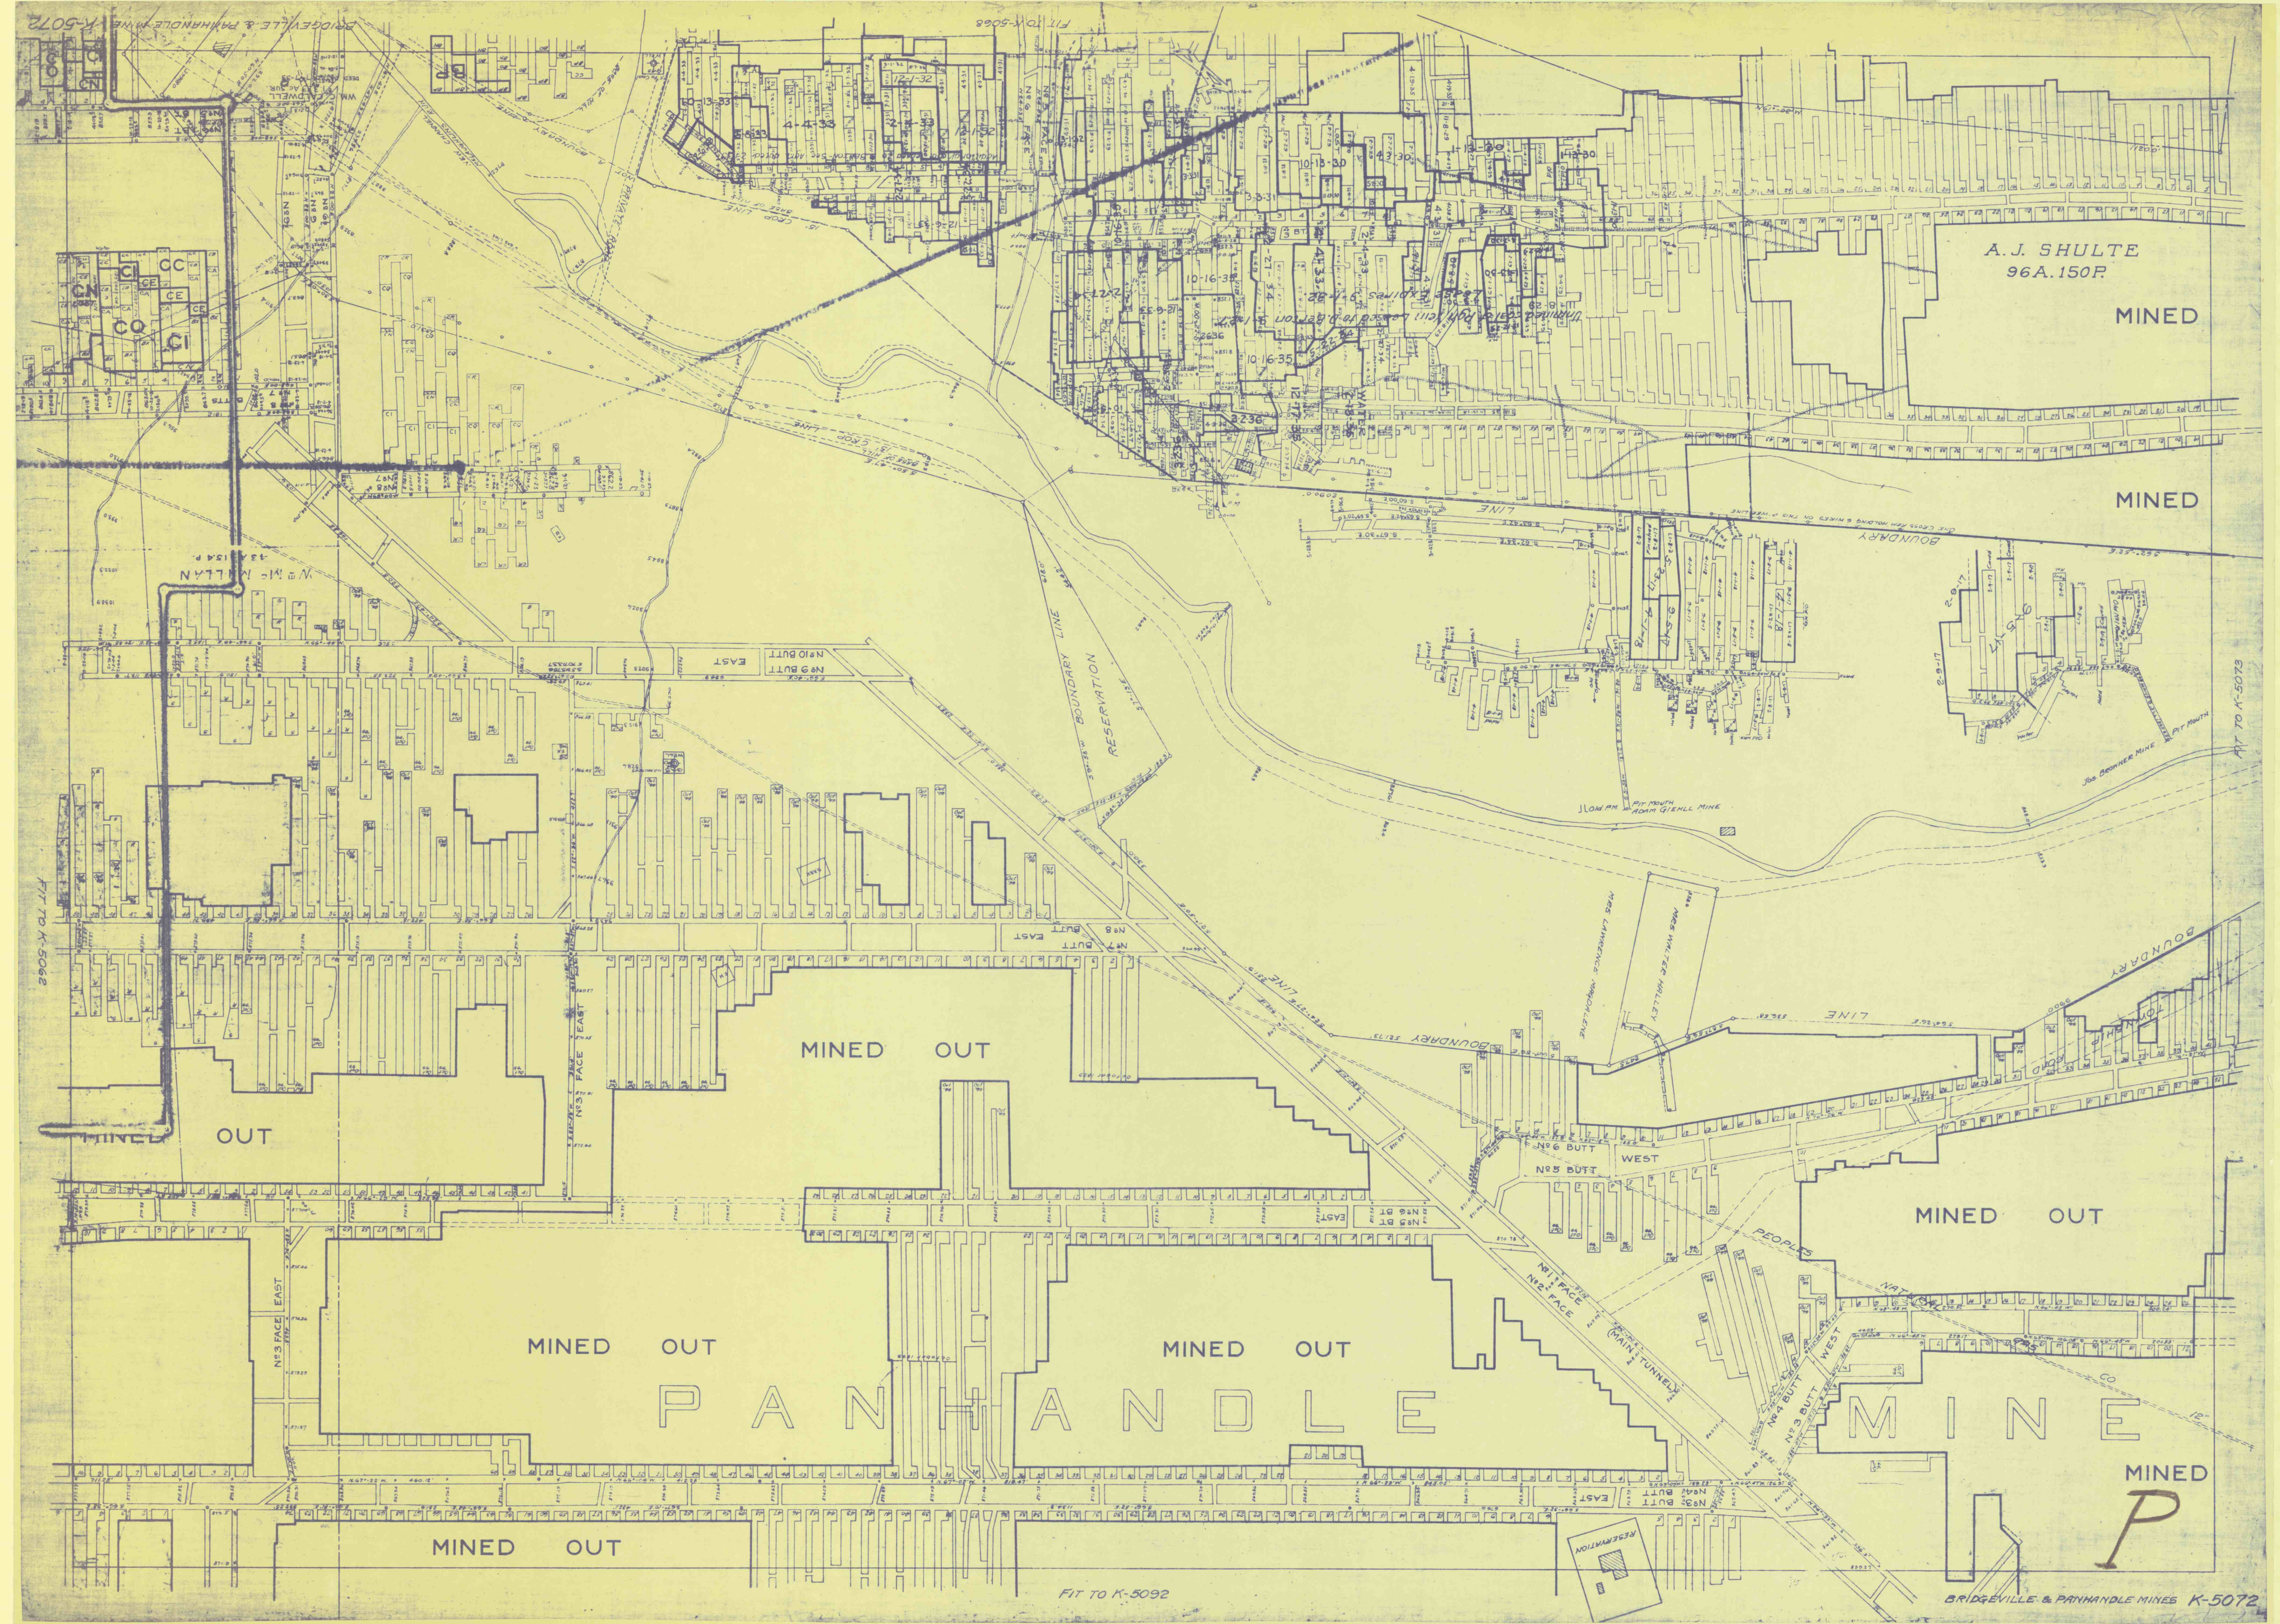

A.J. SHULTE
96A.150P

MINED

MINED

MINED OUT

MINED OUT

MINED OUT

MINED OUT

PANTHANDLE

PEOPLES

MINED

P