


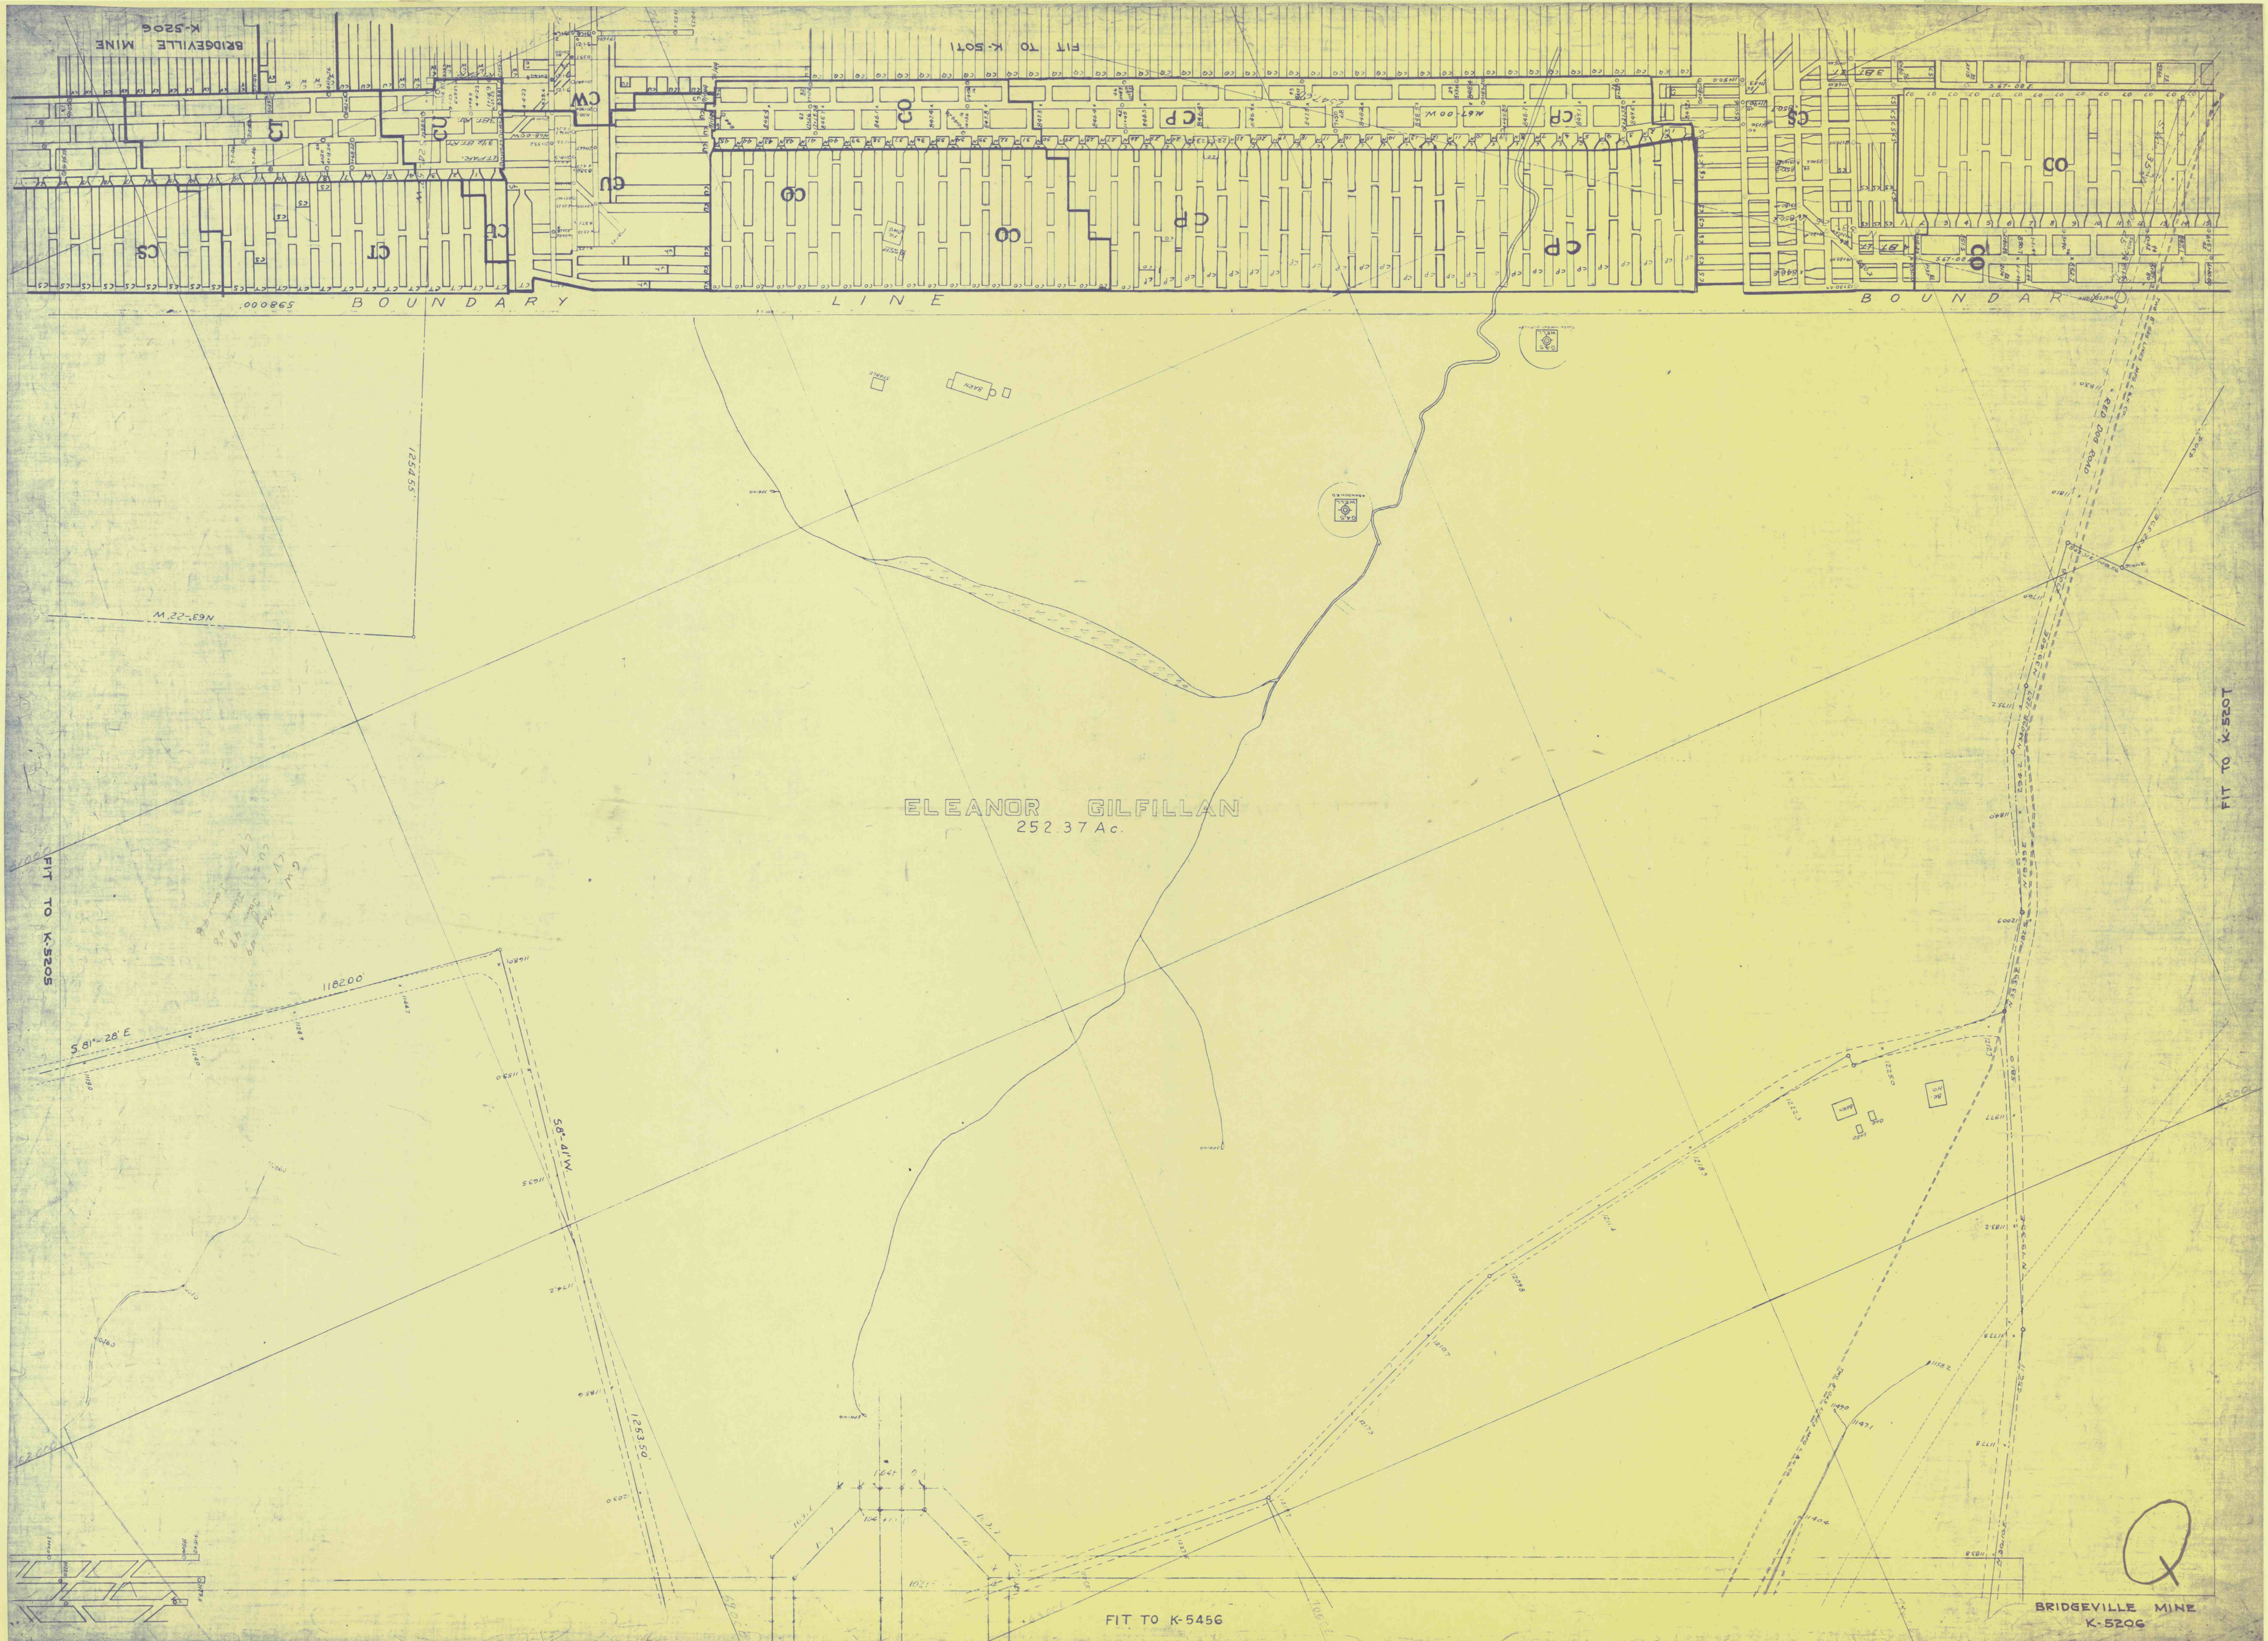

ELEANOR GILFILLAN
252.37 Ac.

BRIDGEVILLE MINE
K-5206

FIT TO K-5205

FIT TO K-5207

FIT TO K-5456

BRIDGEVILLE MINE
K-5206