


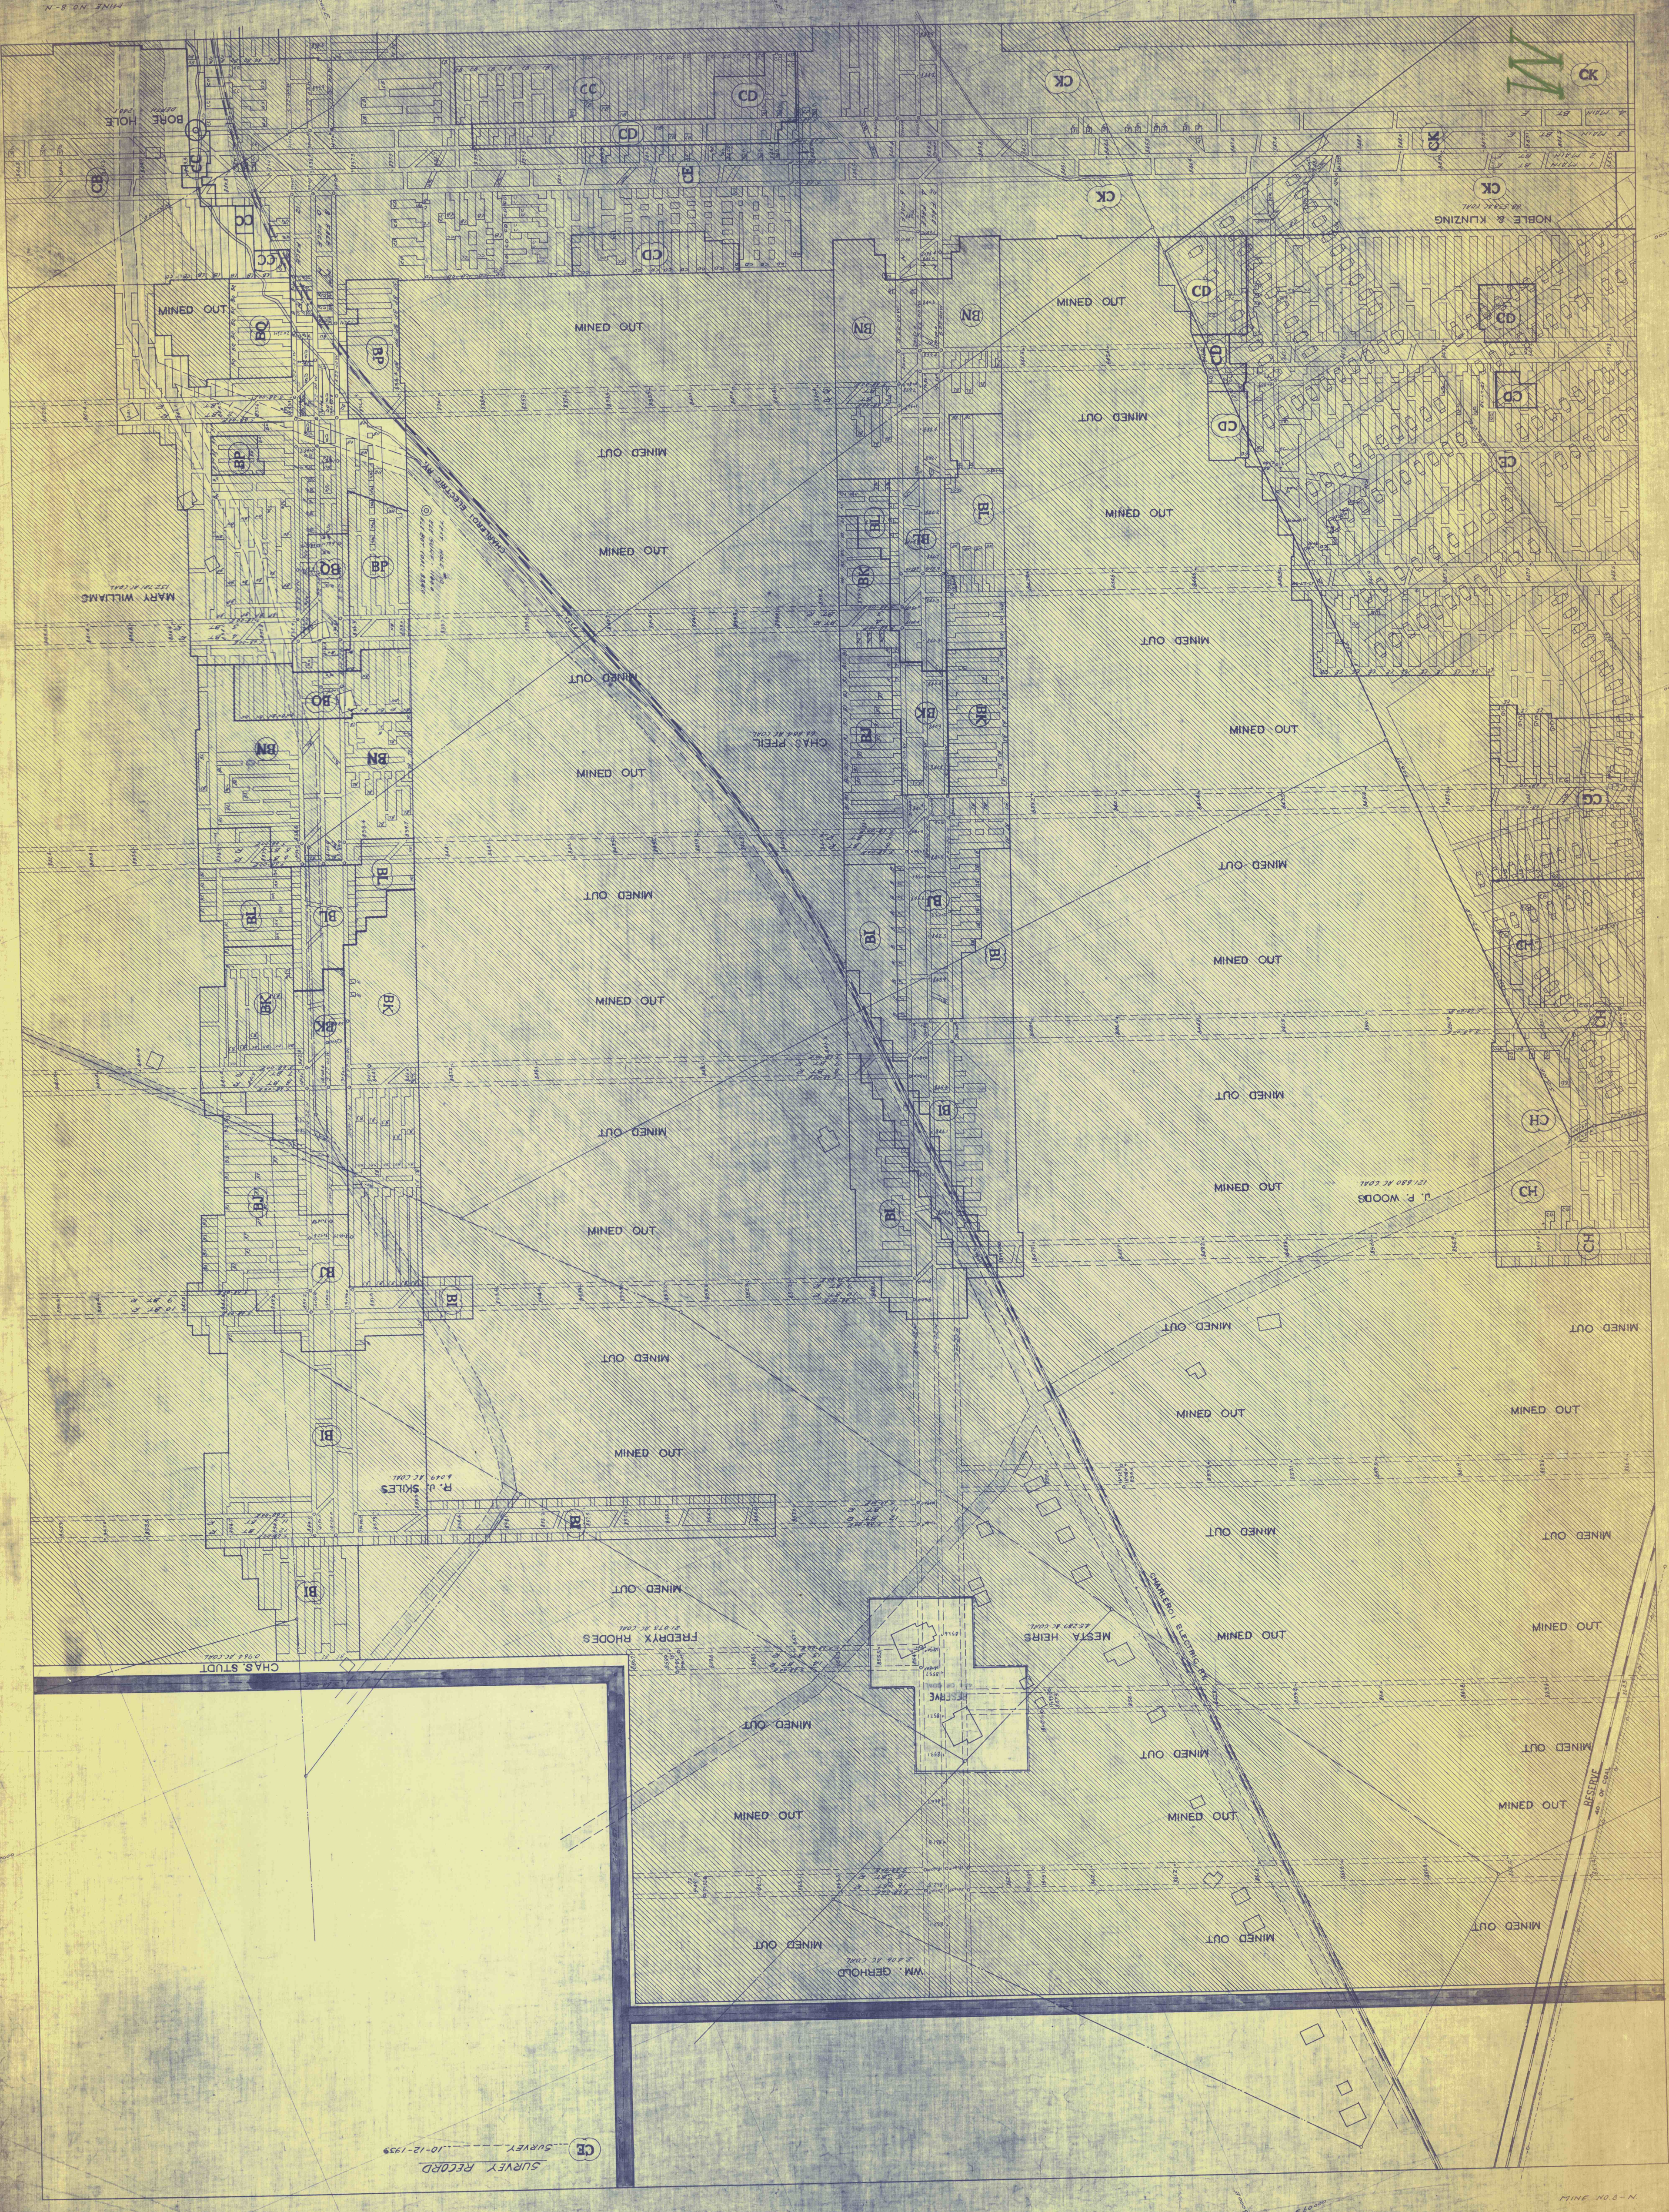

CE SURVEY RECORD
SURVEYED 10-12-1939