


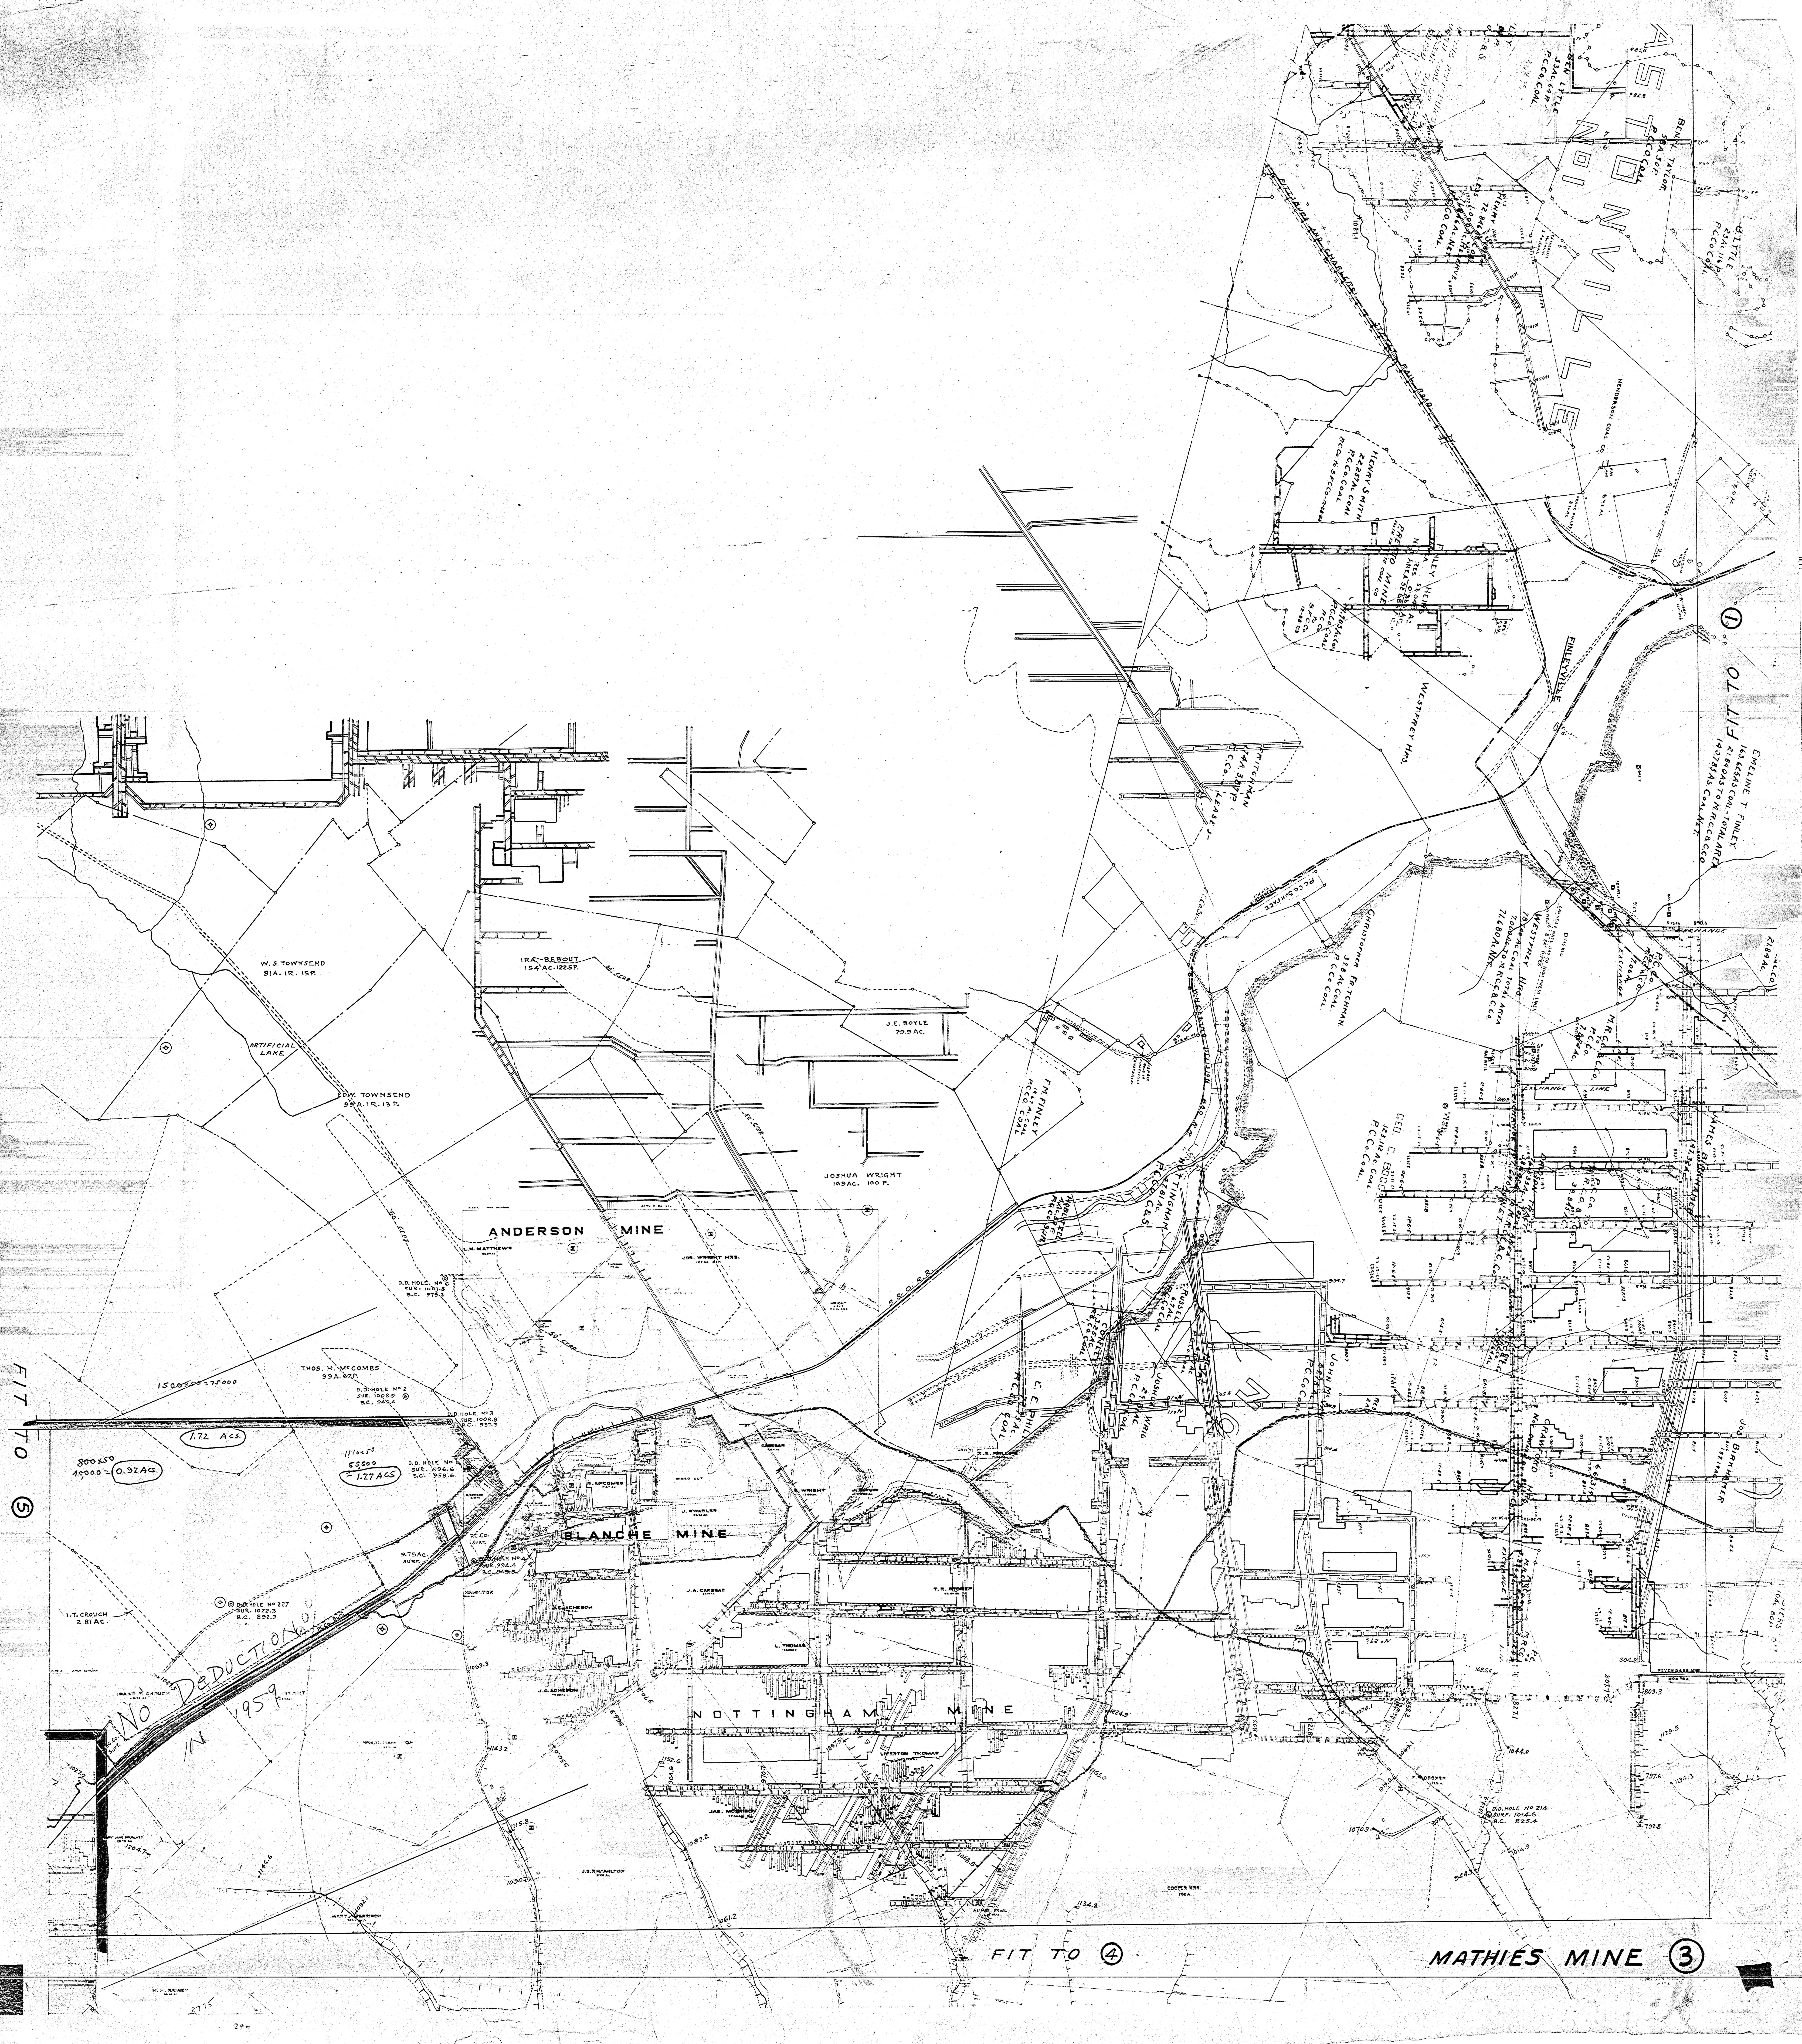

FIT TO ⑤

FIT TO ④

MATHIES MINE ③

ENCLINE T. FINLEY
13,454 AC. TOTAL AREA
14,078 AC. COAL AREA

No Deduction
N 1959