


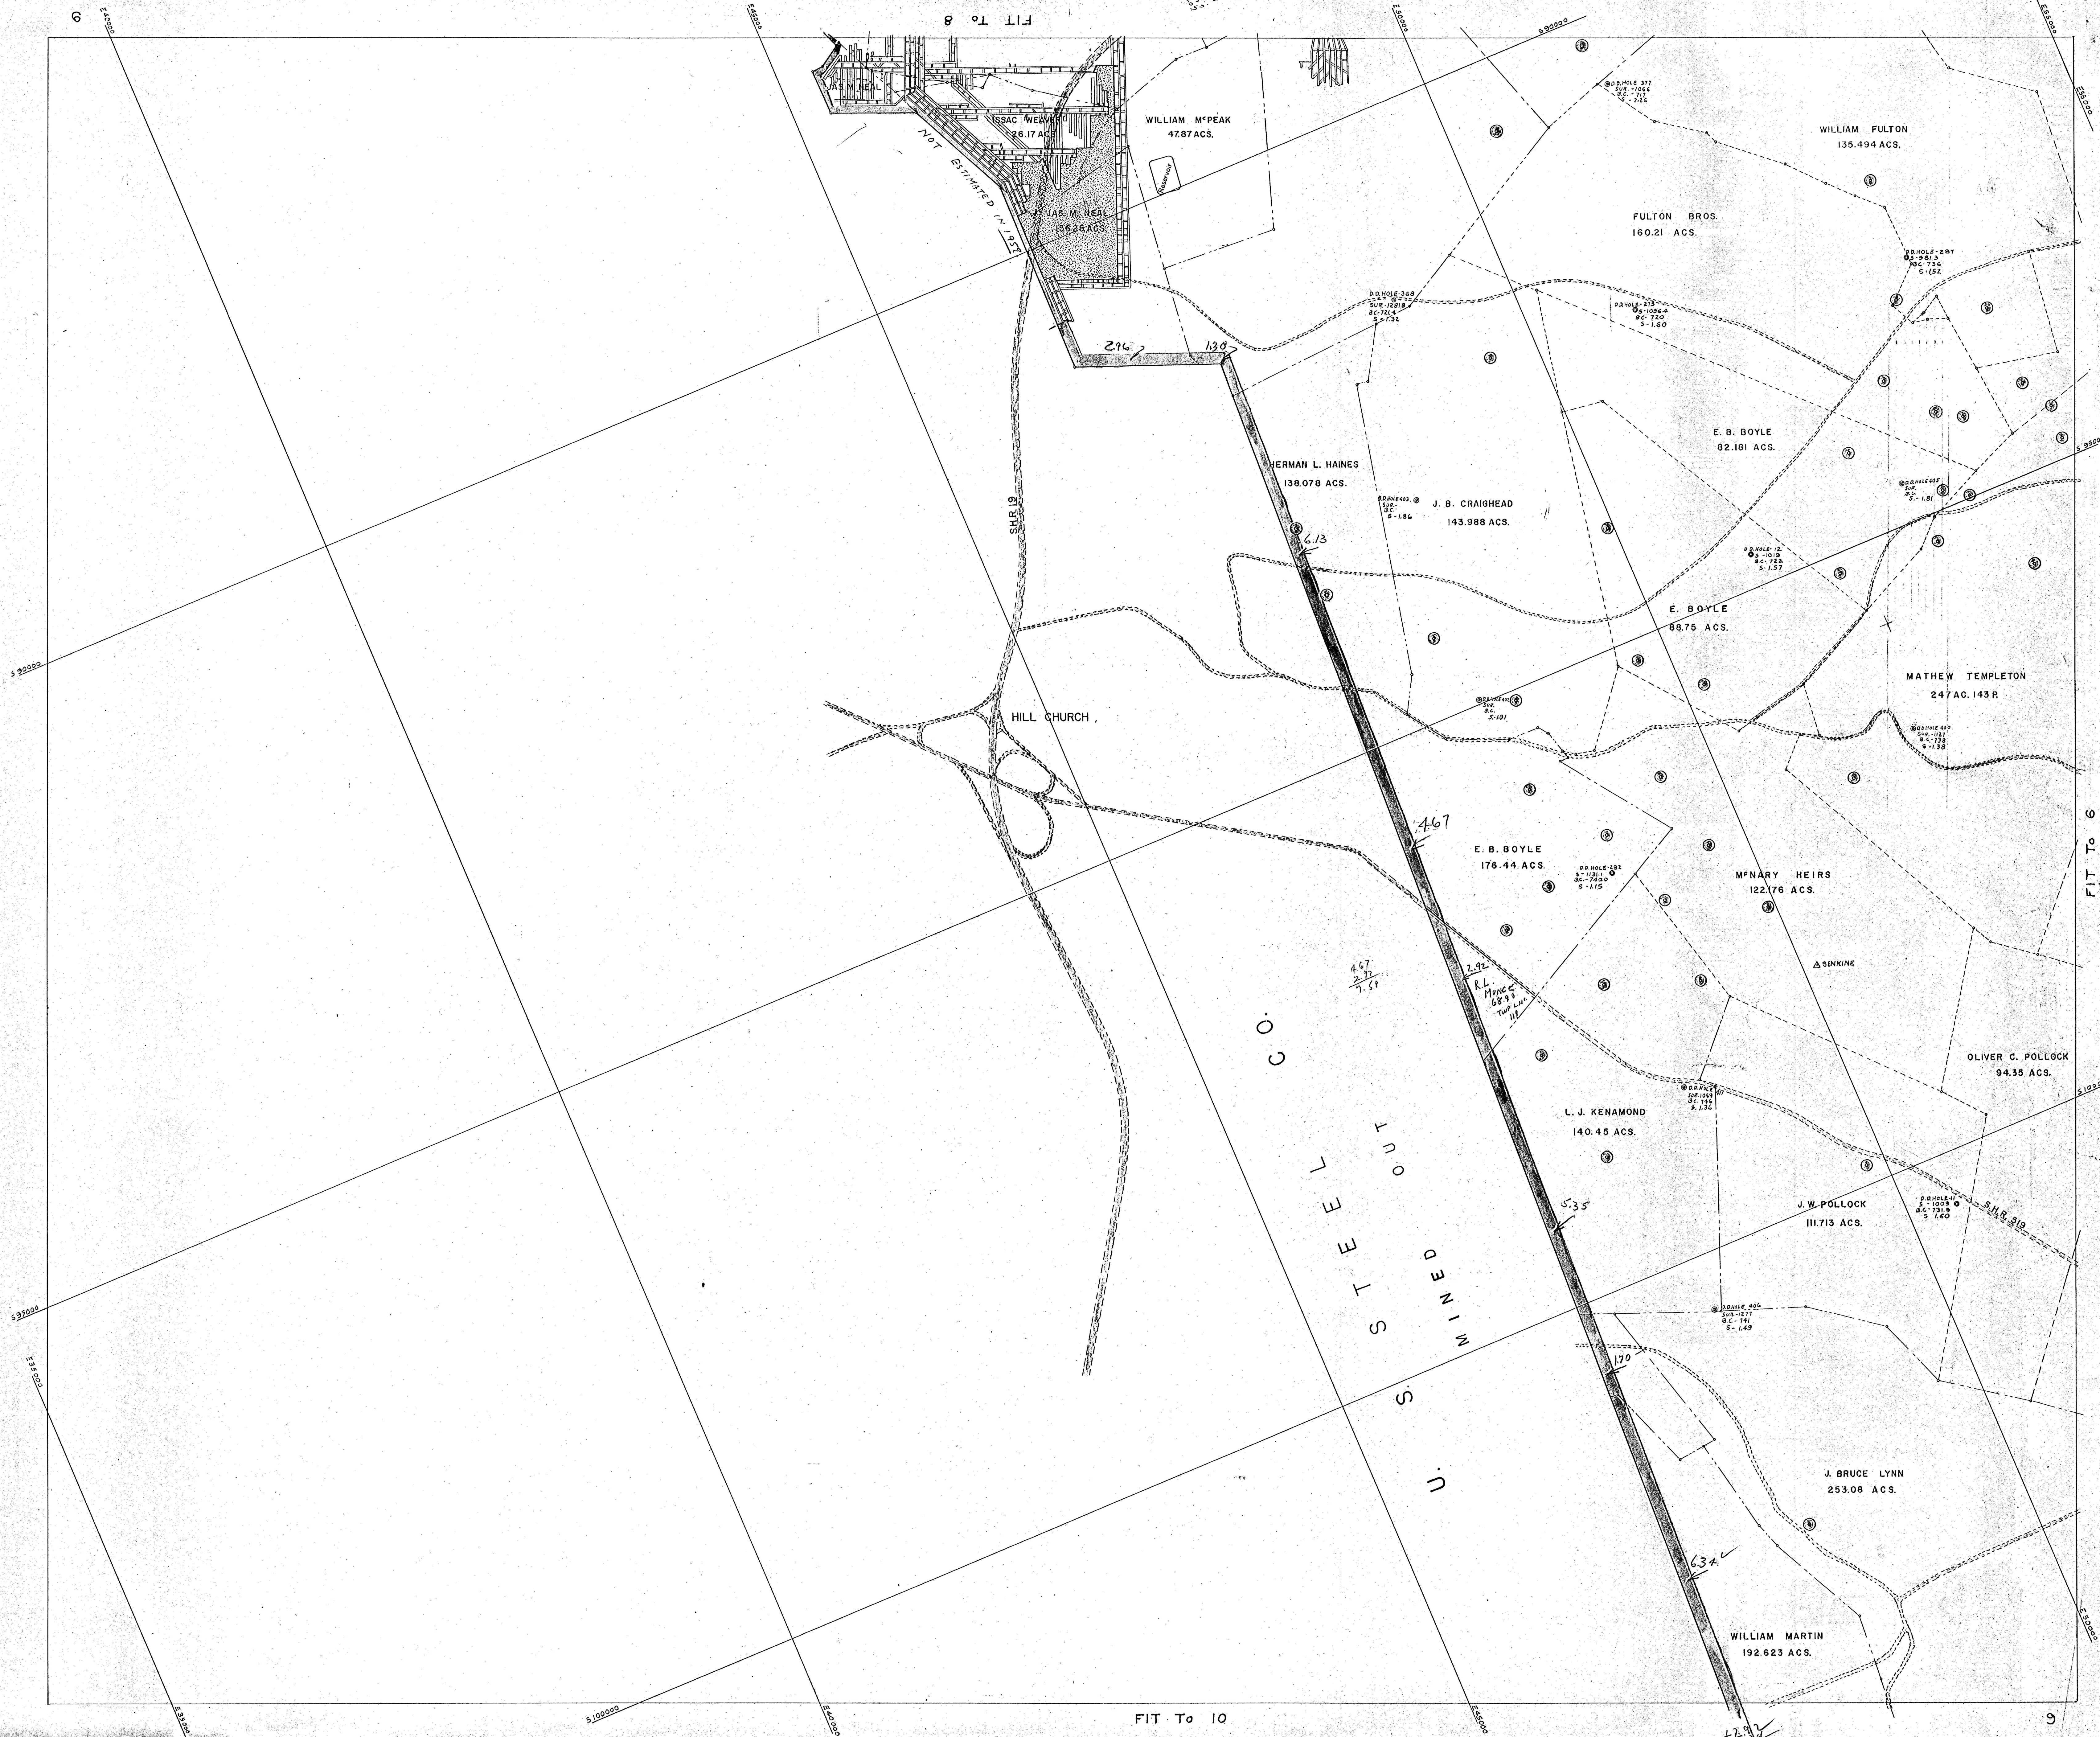

ISAC WEAVER
26.17 ACS.

WILLIAM M'PEAK
47.87 ACS.

IAS. M. NEAL
86.28 ACS.

NOT ESTIMATED IN 1851

WILLIAM FULTON
135.494 ACS.

FULTON BROS.
160.21 ACS.

HERMAN L. HAINES
138.078 ACS.

J. B. CRAIGHEAD
143.988 ACS.

E. B. BOYLE
82.181 ACS.

E. BOYLE
88.75 ACS.

MATHEW TEMPLETON
247 AC. 143 R.

E. B. BOYLE
176.44 ACS.

M'NARY HEIRS
122.76 ACS.

OLIVER C. POLLOCK
94.35 ACS.

L. J. KENAMOND
140.45 ACS.

J. W. POLLOCK
111.713 ACS.

J. BRUCE LYNN
253.08 ACS.

WILLIAM MARTIN
192.823 ACS.

FIT To 10

9