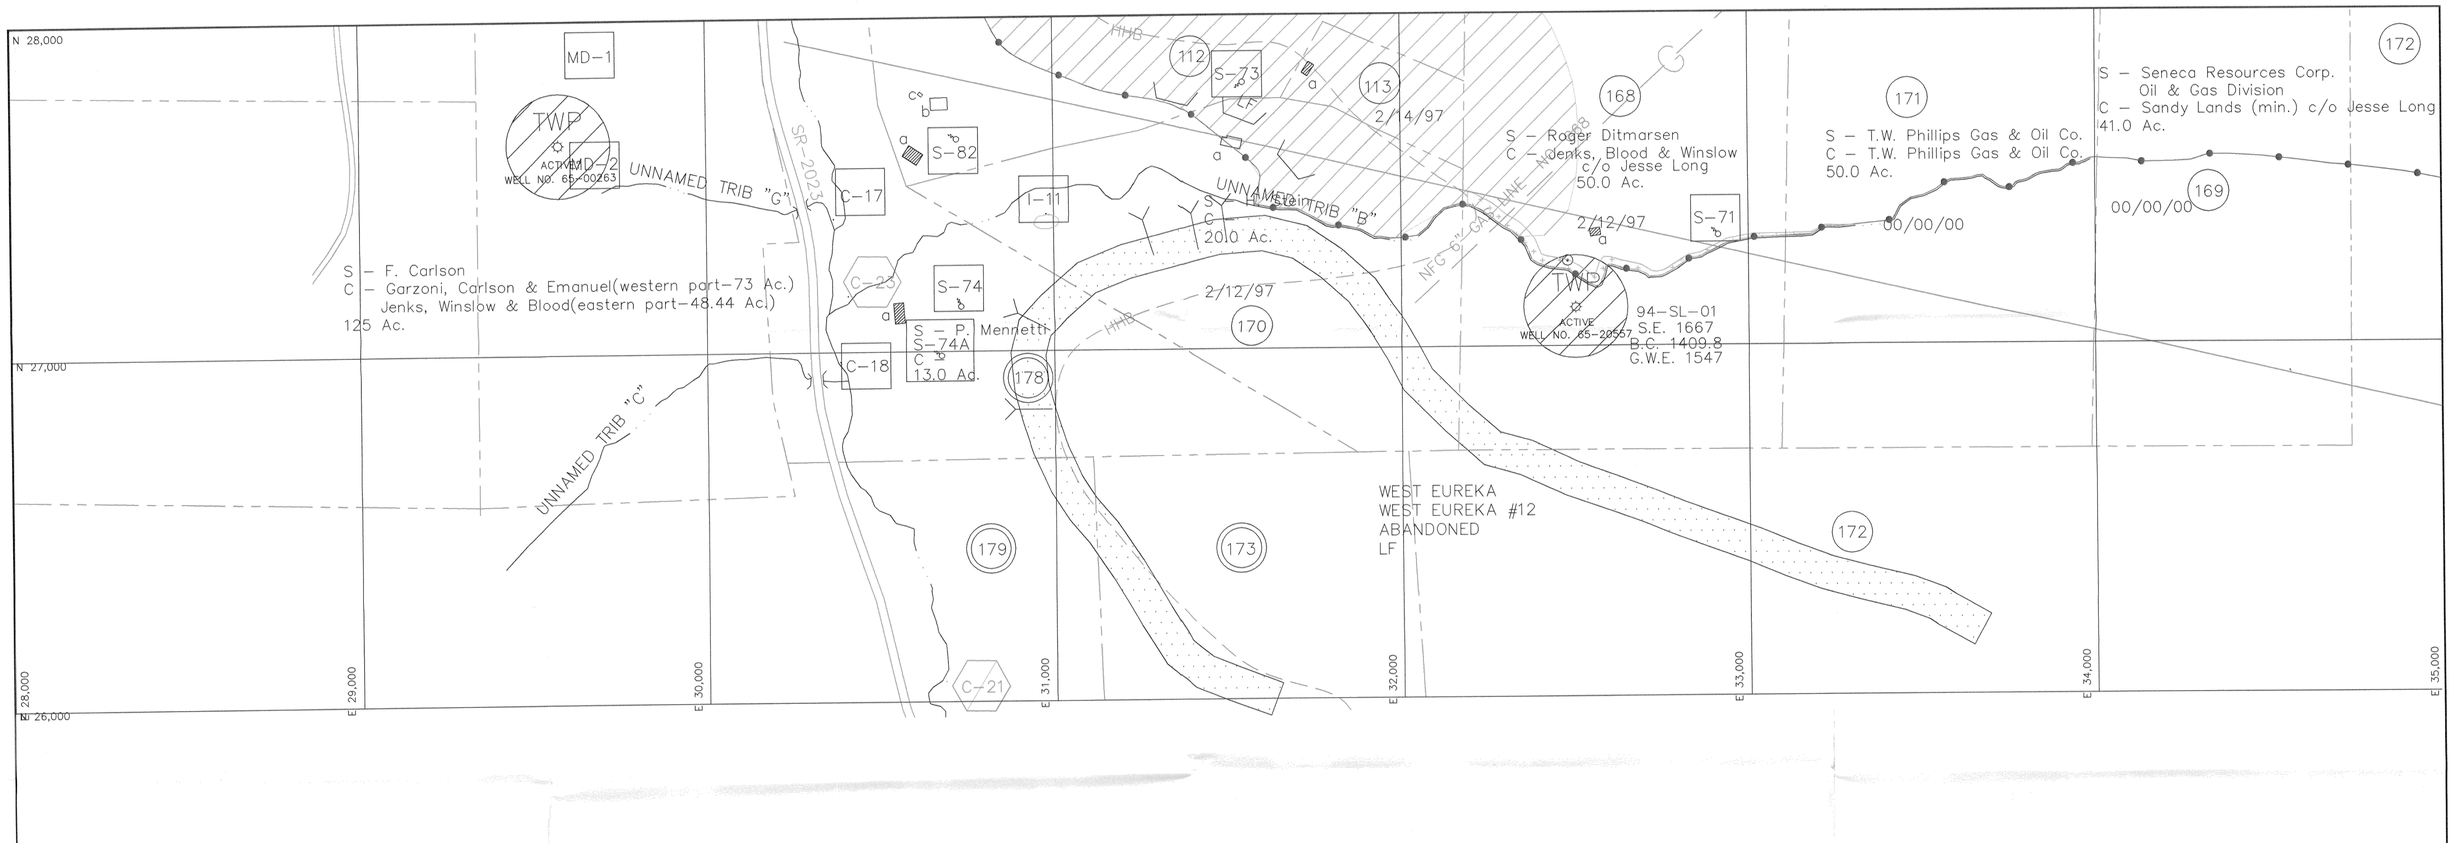

LEGEND

- UNDERGROUND/SUBSIDENCE PERMIT BOUNDARY
- DWELLING, STRUCTURE
- INVENTORIED BUILDING-SEE MODULE 18.1
- COMMERCIAL BUILDING
- PROTECTED ACT 54 STRUCTURE
- MIDDLE KITTANNING COAL CONTOUR
- MIDDLE KITTANNING COAL CROPLINE
- STREAM
- HYDRAULIC HEAD BARRIER
- 100' COVER LINE
- SURFACE ACTIVITY SITE
- ELECTRIC & TELEPHONE LINES
- PROJECTED COAL MINING
- PIEZOMETER
- MINE PORTAL
- LINEAR
- 6 MONTH MINING LINES (2/1/01 - 8/1/01)
- SUPPORT AREA(No Second Mining)
- PROPERTY LINE (OWNERSHIP KEYED TO MODULE 5)
- PROPERTY WITHIN PERMIT (KEYED TO MODULE 5)
- CONTIGUOUS PROPERTY (KEYED TO MODULE 5)
- ZONE OF POTENTIAL INFLUENCE
- CEM CEMETERY
- NO MINING/HYDRAULIC BARRIER ZONE
- MINING FORCAST
- COAL MINED

SHEET INDEX

1	2
3	4
5	6
7	8

- ABANDONED WELL — AS SHOWN ON T.W.PHILLIPS MAP NOT FOUND IN FIELD-DIGITIZED
- ACTIVE WELL — FIELD SURVEYED
- PLUGGED WELL — FIELD SURVEYED
- DRY WELL — AS SHOWN ON T.W.PHILLIPS MAP NOT FOUND IN FIELD-DIGITIZED
- GAS WELL MARK ON USGS QUAD. — NOT FOUND IN FIELD-DIGITIZED
- GAS WELL MARK FROM A DEEP MINE MAP SUPPLIED FROM W.D. MOHNEY & ASSOCIATES. — NOT FOUND IN FIELD-DIGITIZED

NOTE: ORIGINAL MAPPING BY DOVERSPIKE BROS. COAL CO.
ALL UNDERGROUND SURVEYING DONE BY
APPLEGATE SERVICES Inc. ELDERTON, PA.

PROPOSED MINING TO BE CONDUCTED ON THE MIDDLE KITTANNING COAL SEAM

*SEE SHEET 1 FOR PROPERTY ID LIST

Laurel Energy, L.P.
One Energy Place
Suite 7500
Latrobe, PA 15650-9628

CONTRACTOR:
ANITA MINING COMPANY
RR #3, BOX 248
REYNOLDSVILLE, PA 15851

CME ENGINEERING
Civil Mining Environmental Engineering, Inc.
165 E. Union St., Suite 100, Somerset, PA 15501
814-443-3344 FAX: 814-444-0365 E-MAIL: info@cmeeinc.com

Sandylands Mine
McCalmont Twp., Jefferson Co.
CMAP: No. 33961302

Module 22.6
FINAL MAP

CHECKED BY:	DATE:	SHEET NO:
JEF	12/11/01	SHEET 7 OF 8
DRAWING BY: TWM	SCALE: 1"=200'	REVISED: 3/8/02