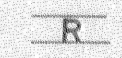
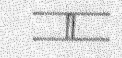
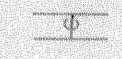
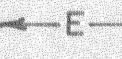




LEGEND

- Regulator 
- Proposed Air Flows 
- Intake Air 
- Return Air 
- Belt Air 
- Belt Line 
- Permanent Stopping 
- Check Curtain 
- Proposed Stopping 
- Doors 
- Equipment Doors 
- Seals 
- Survey Station 
- Permit Boundary 
- Property Line 
- Public Road 
- Stream 
- Mining Completed Area 
- Contemplated Mining Area 
- Projected Mining TO 
- Projection No. 
- Survey Date 11-1-00

ESCAPEWAYS

- Primary Escapeway 
- Secondary Escapeway 

FAN DATA
Simmons-Rand
Model -AMF 1600-70-3-A
Blade Setting - Fixed
5' Low Pressure
1180 rpm
50 hp
480volts
Water Gauge

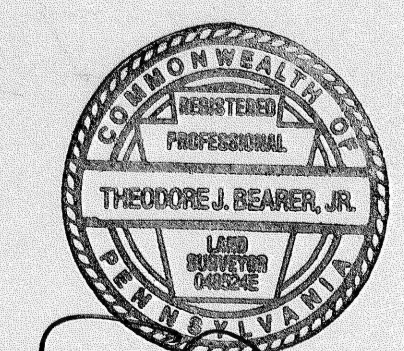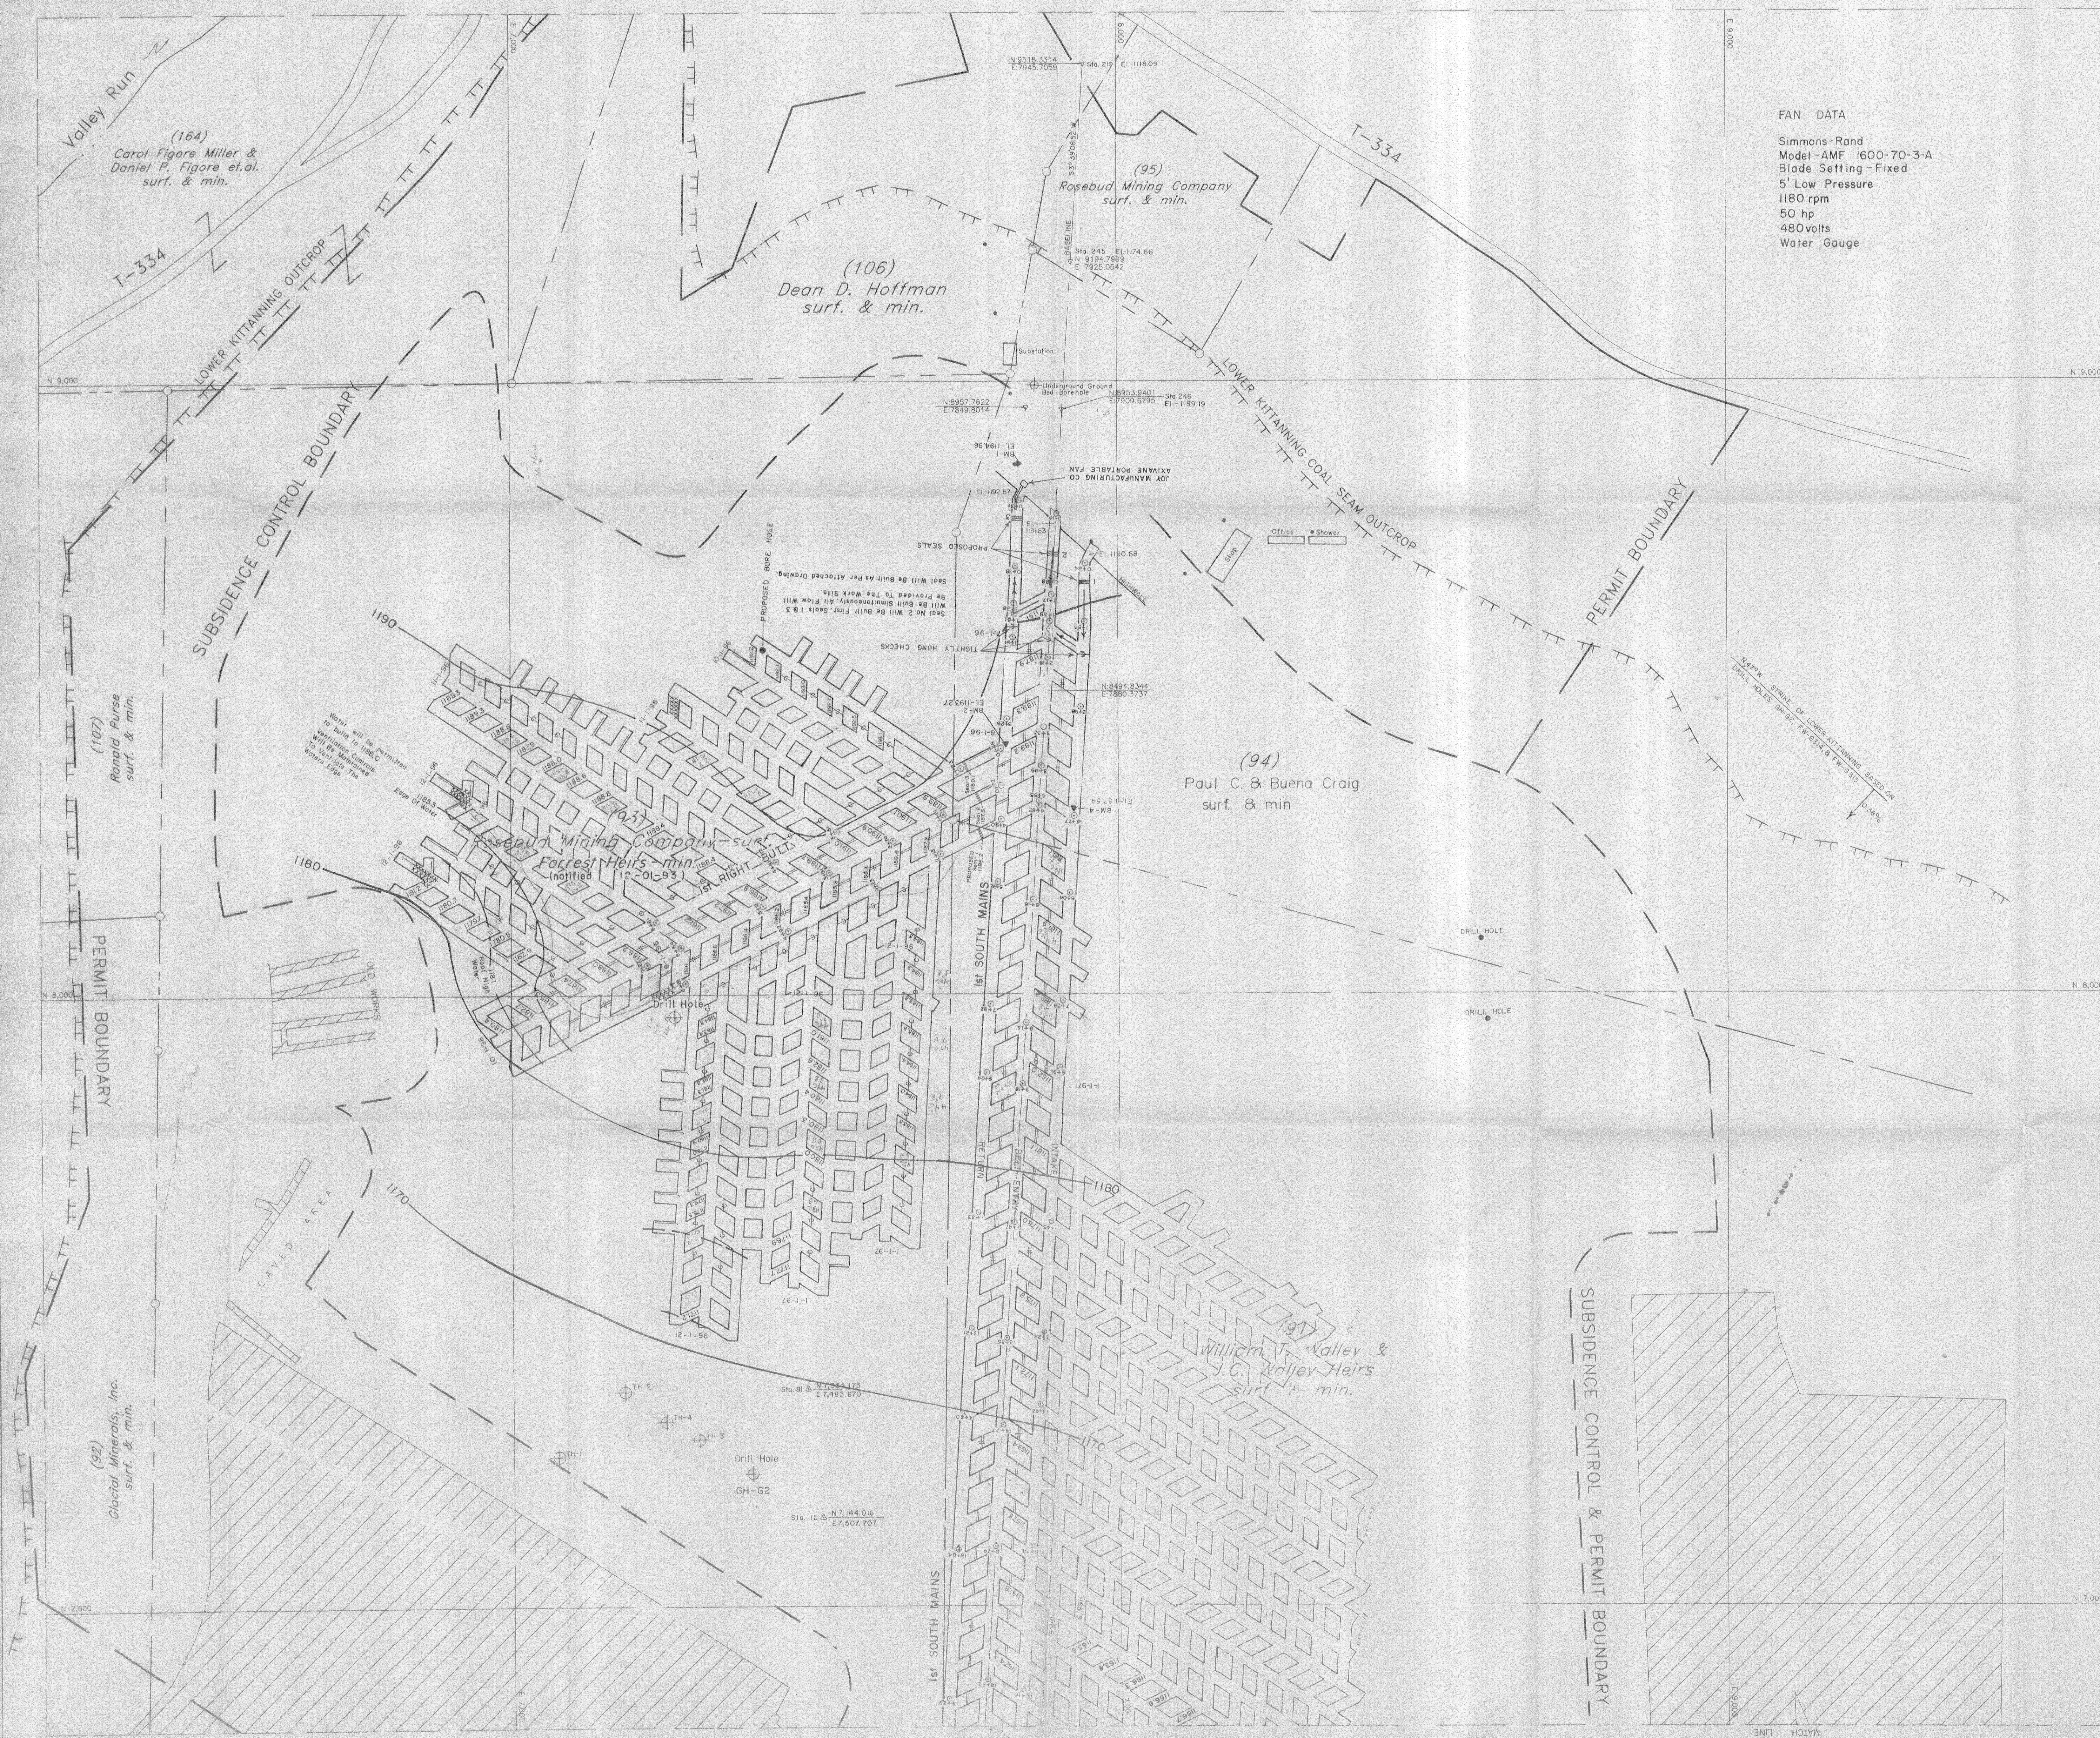

FINAL MAP
MAP 75.372 & 75.1200
ROSEBUD MINING COMPANY
ROSEBUD NO. 2 MINE
SHEET NO. 1
PERRY TWP., ARMSTRONG CO.
LOWER KITTANNING COAL SEAM
SCALE: 1"=100'
I.D. No. 36-0840
Person Responsible For Map: Joe Oberneder DATE: 11-1-00