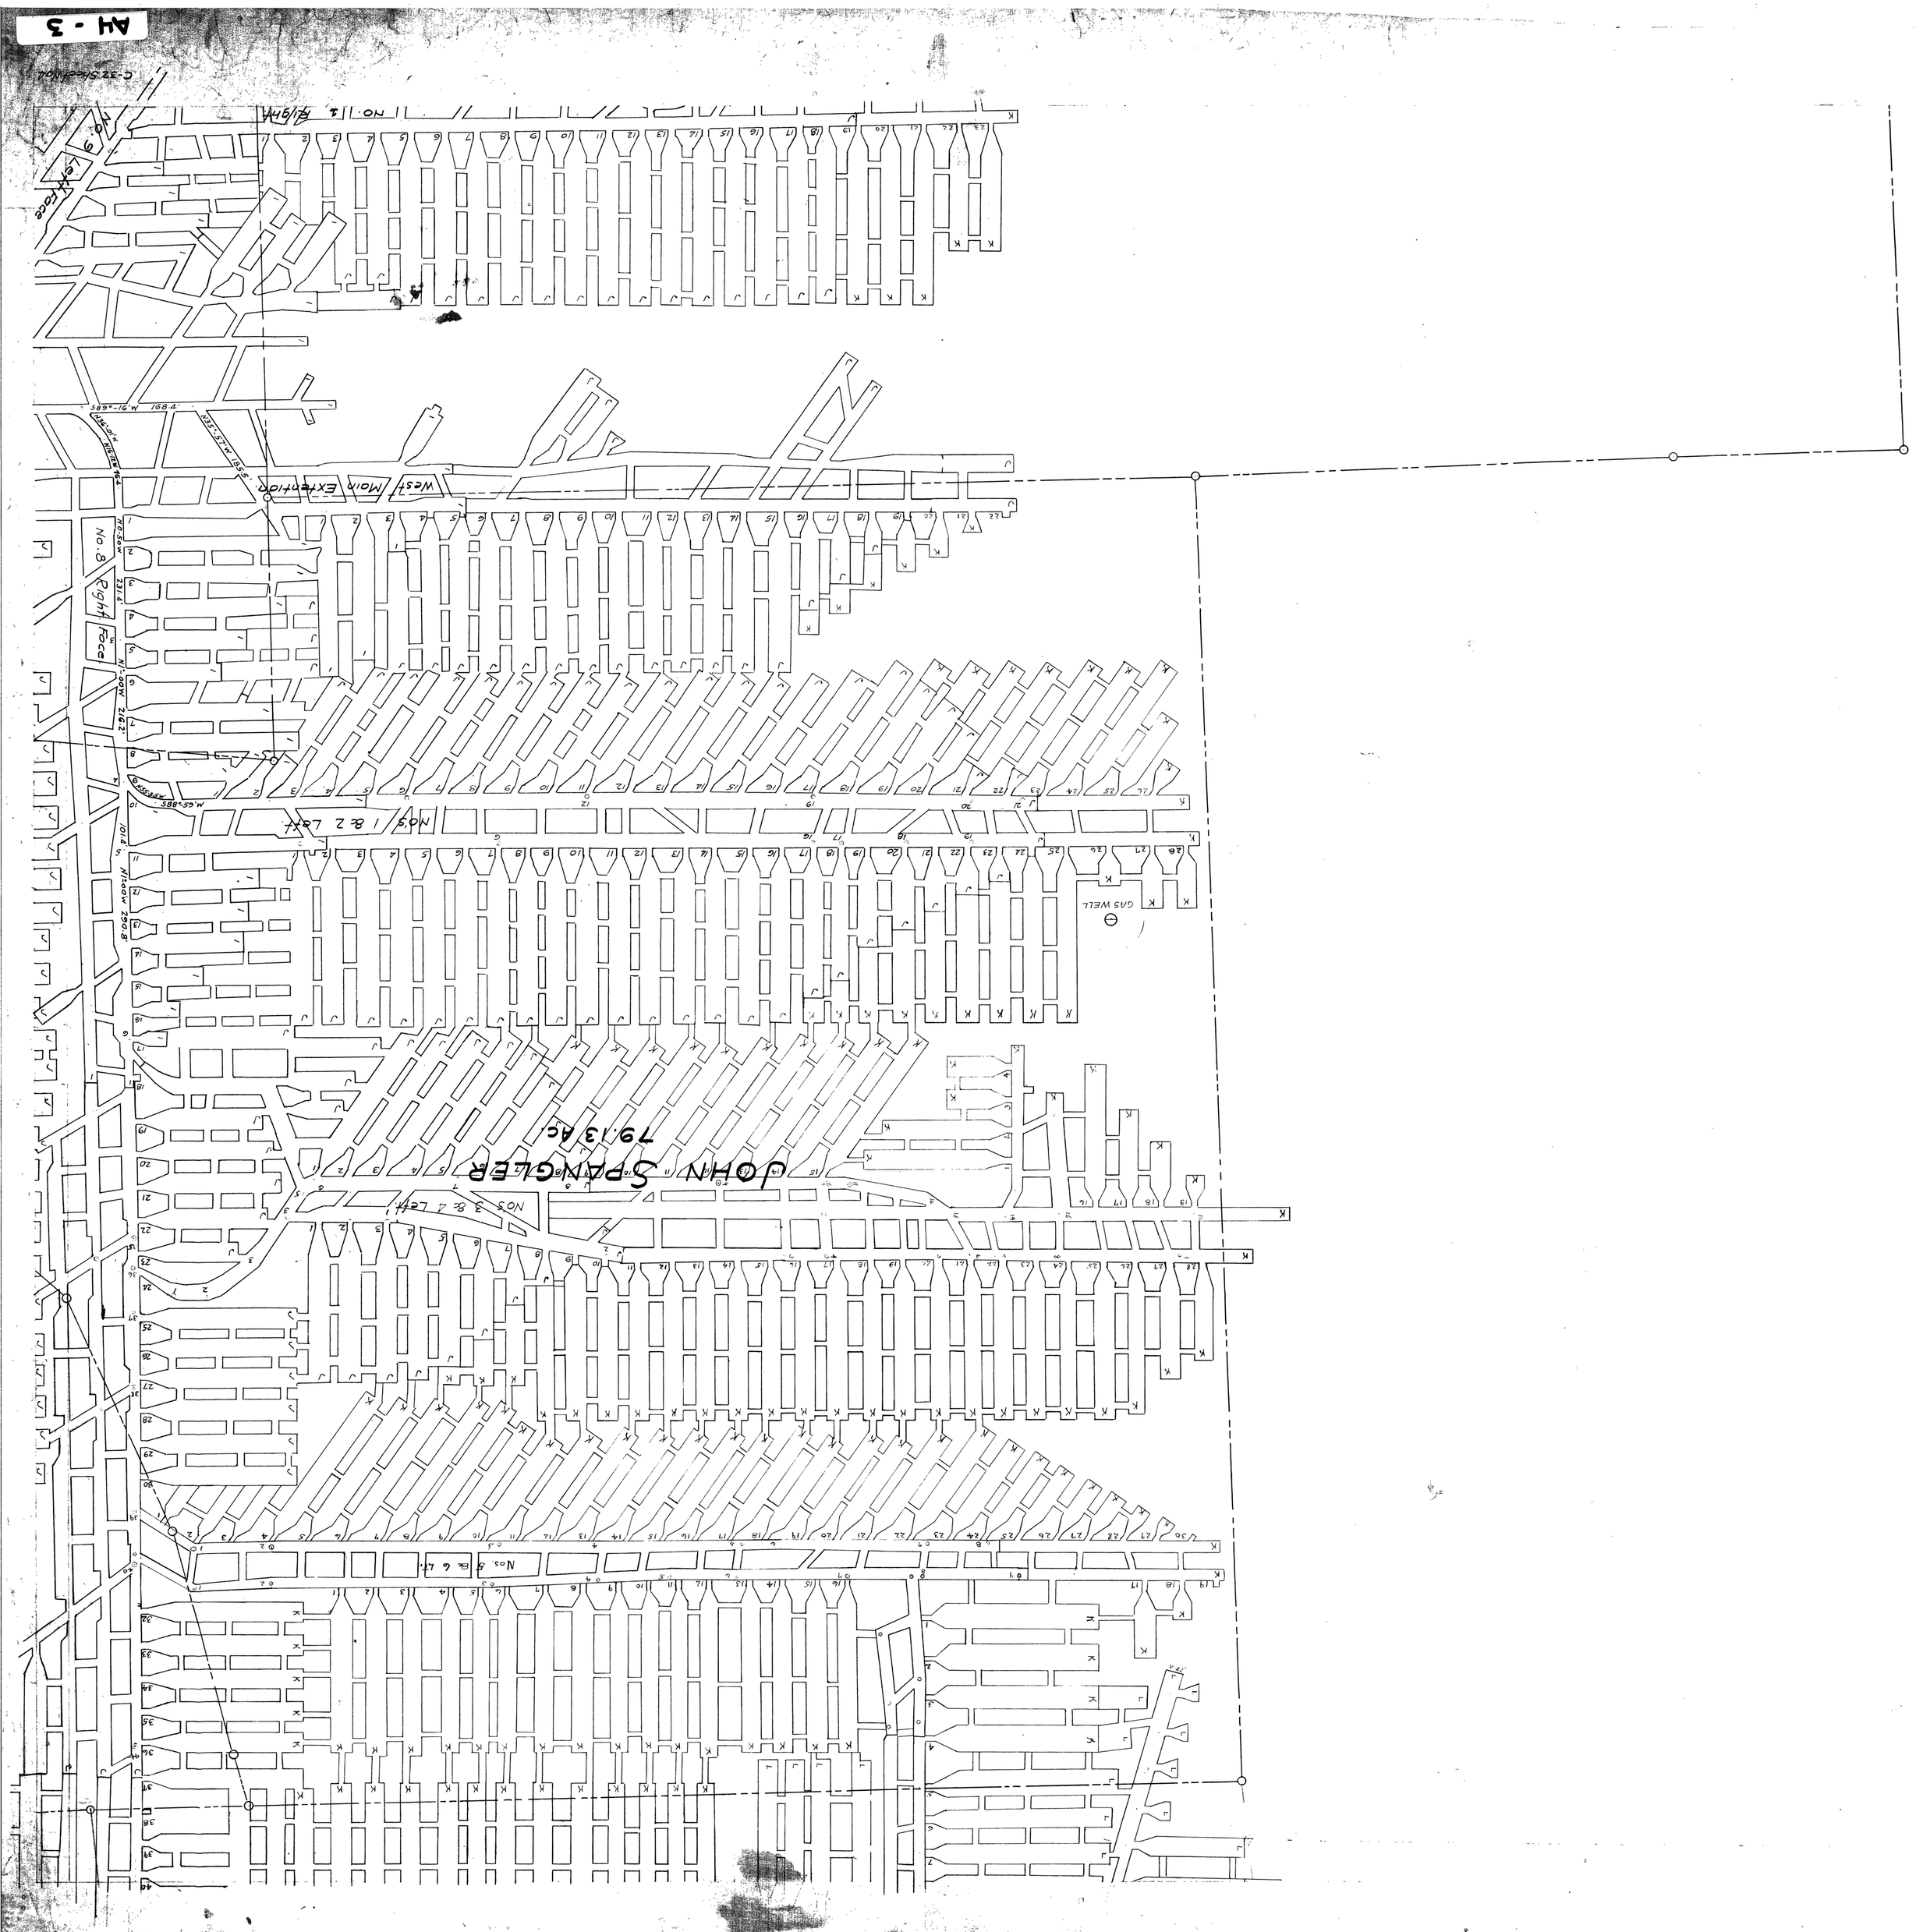
A4 - 3
West Main Extention
No. 8 Right Face
No's 1 & 2 Left
GAS WELL
JOHN SPANGLER
79.13 Ac
No's 3 & 4 Left
No's 5 & 6 Lt.