


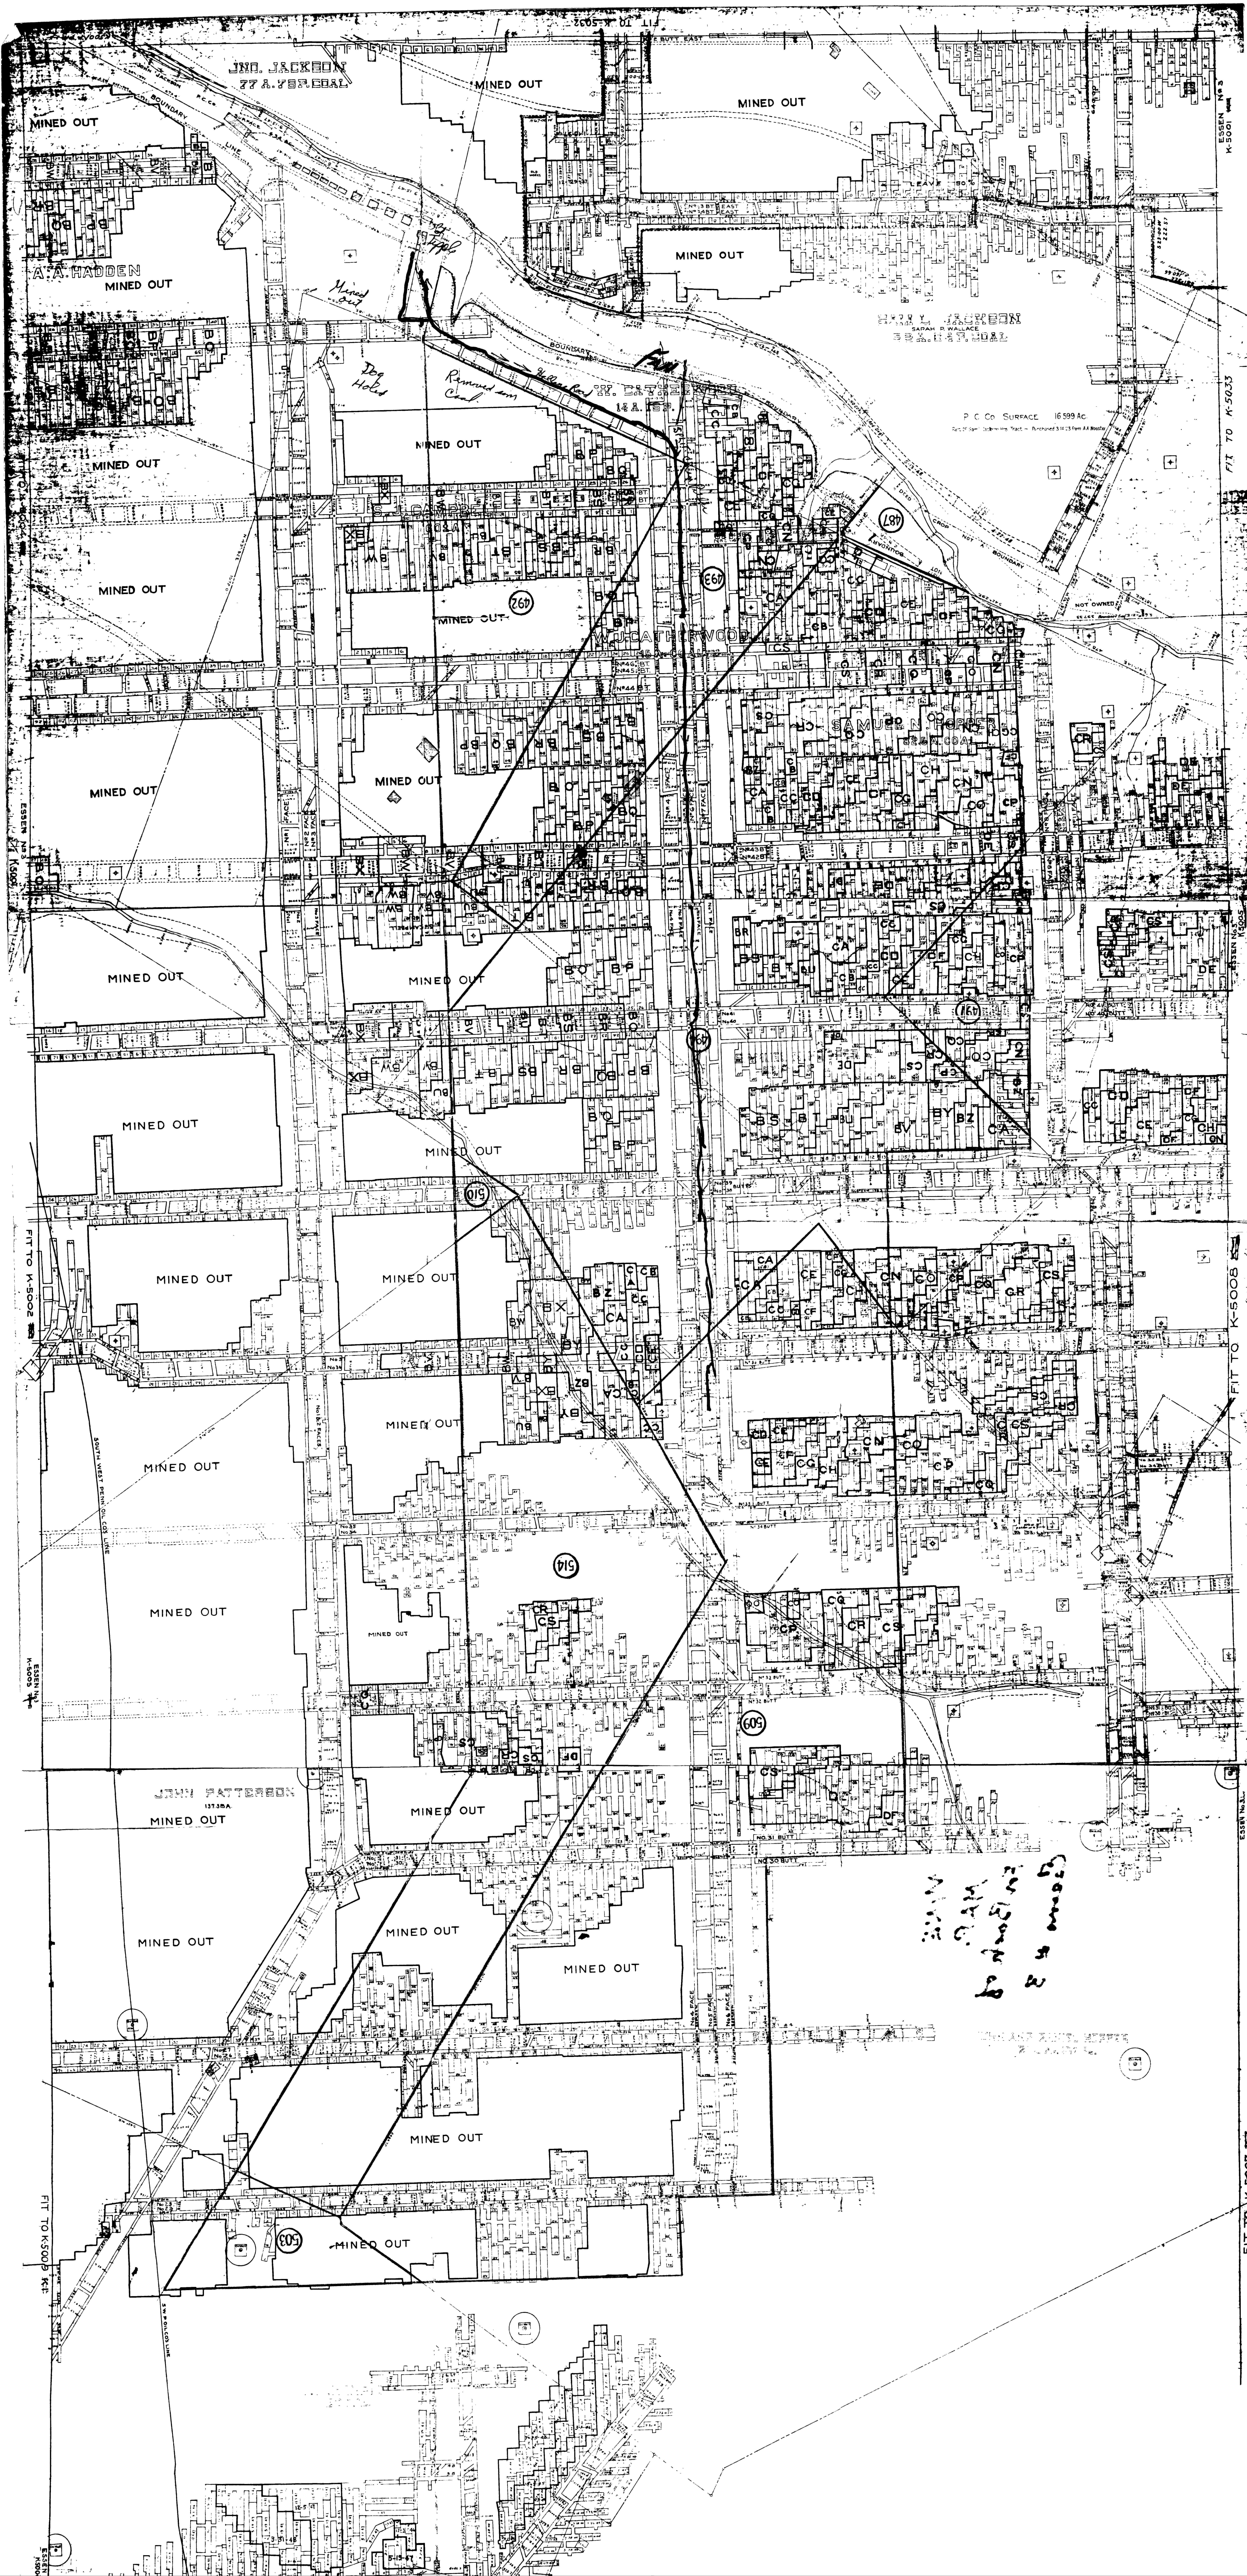

JNO. JACKSON
77 A. 78 P. 30 A. 1

MINED OUT

MINED OUT

MINED OUT

A.A. HADDEN
MINED OUT

P.C. Co. SURFACE 16599 AC

MINED OUT

MINED OUT

MINED OUT

MINED OUT

MINED OUT

MINED OUT

MINED OUT

MINED OUT

MINED OUT

MINED OUT

MINED OUT

MINED OUT

MINED OUT

MINED OUT

MINED OUT

JOHN PATTERSON
13735A
MINED OUT

MINED OUT

MINED OUT

MINED OUT

MINED OUT

MINED OUT

MINED OUT

Handwritten notes:
Mined out
Dog Holes
Remained and Chalk

FIT TO K-5005

FIT TO K-5008

FIT TO K-5007