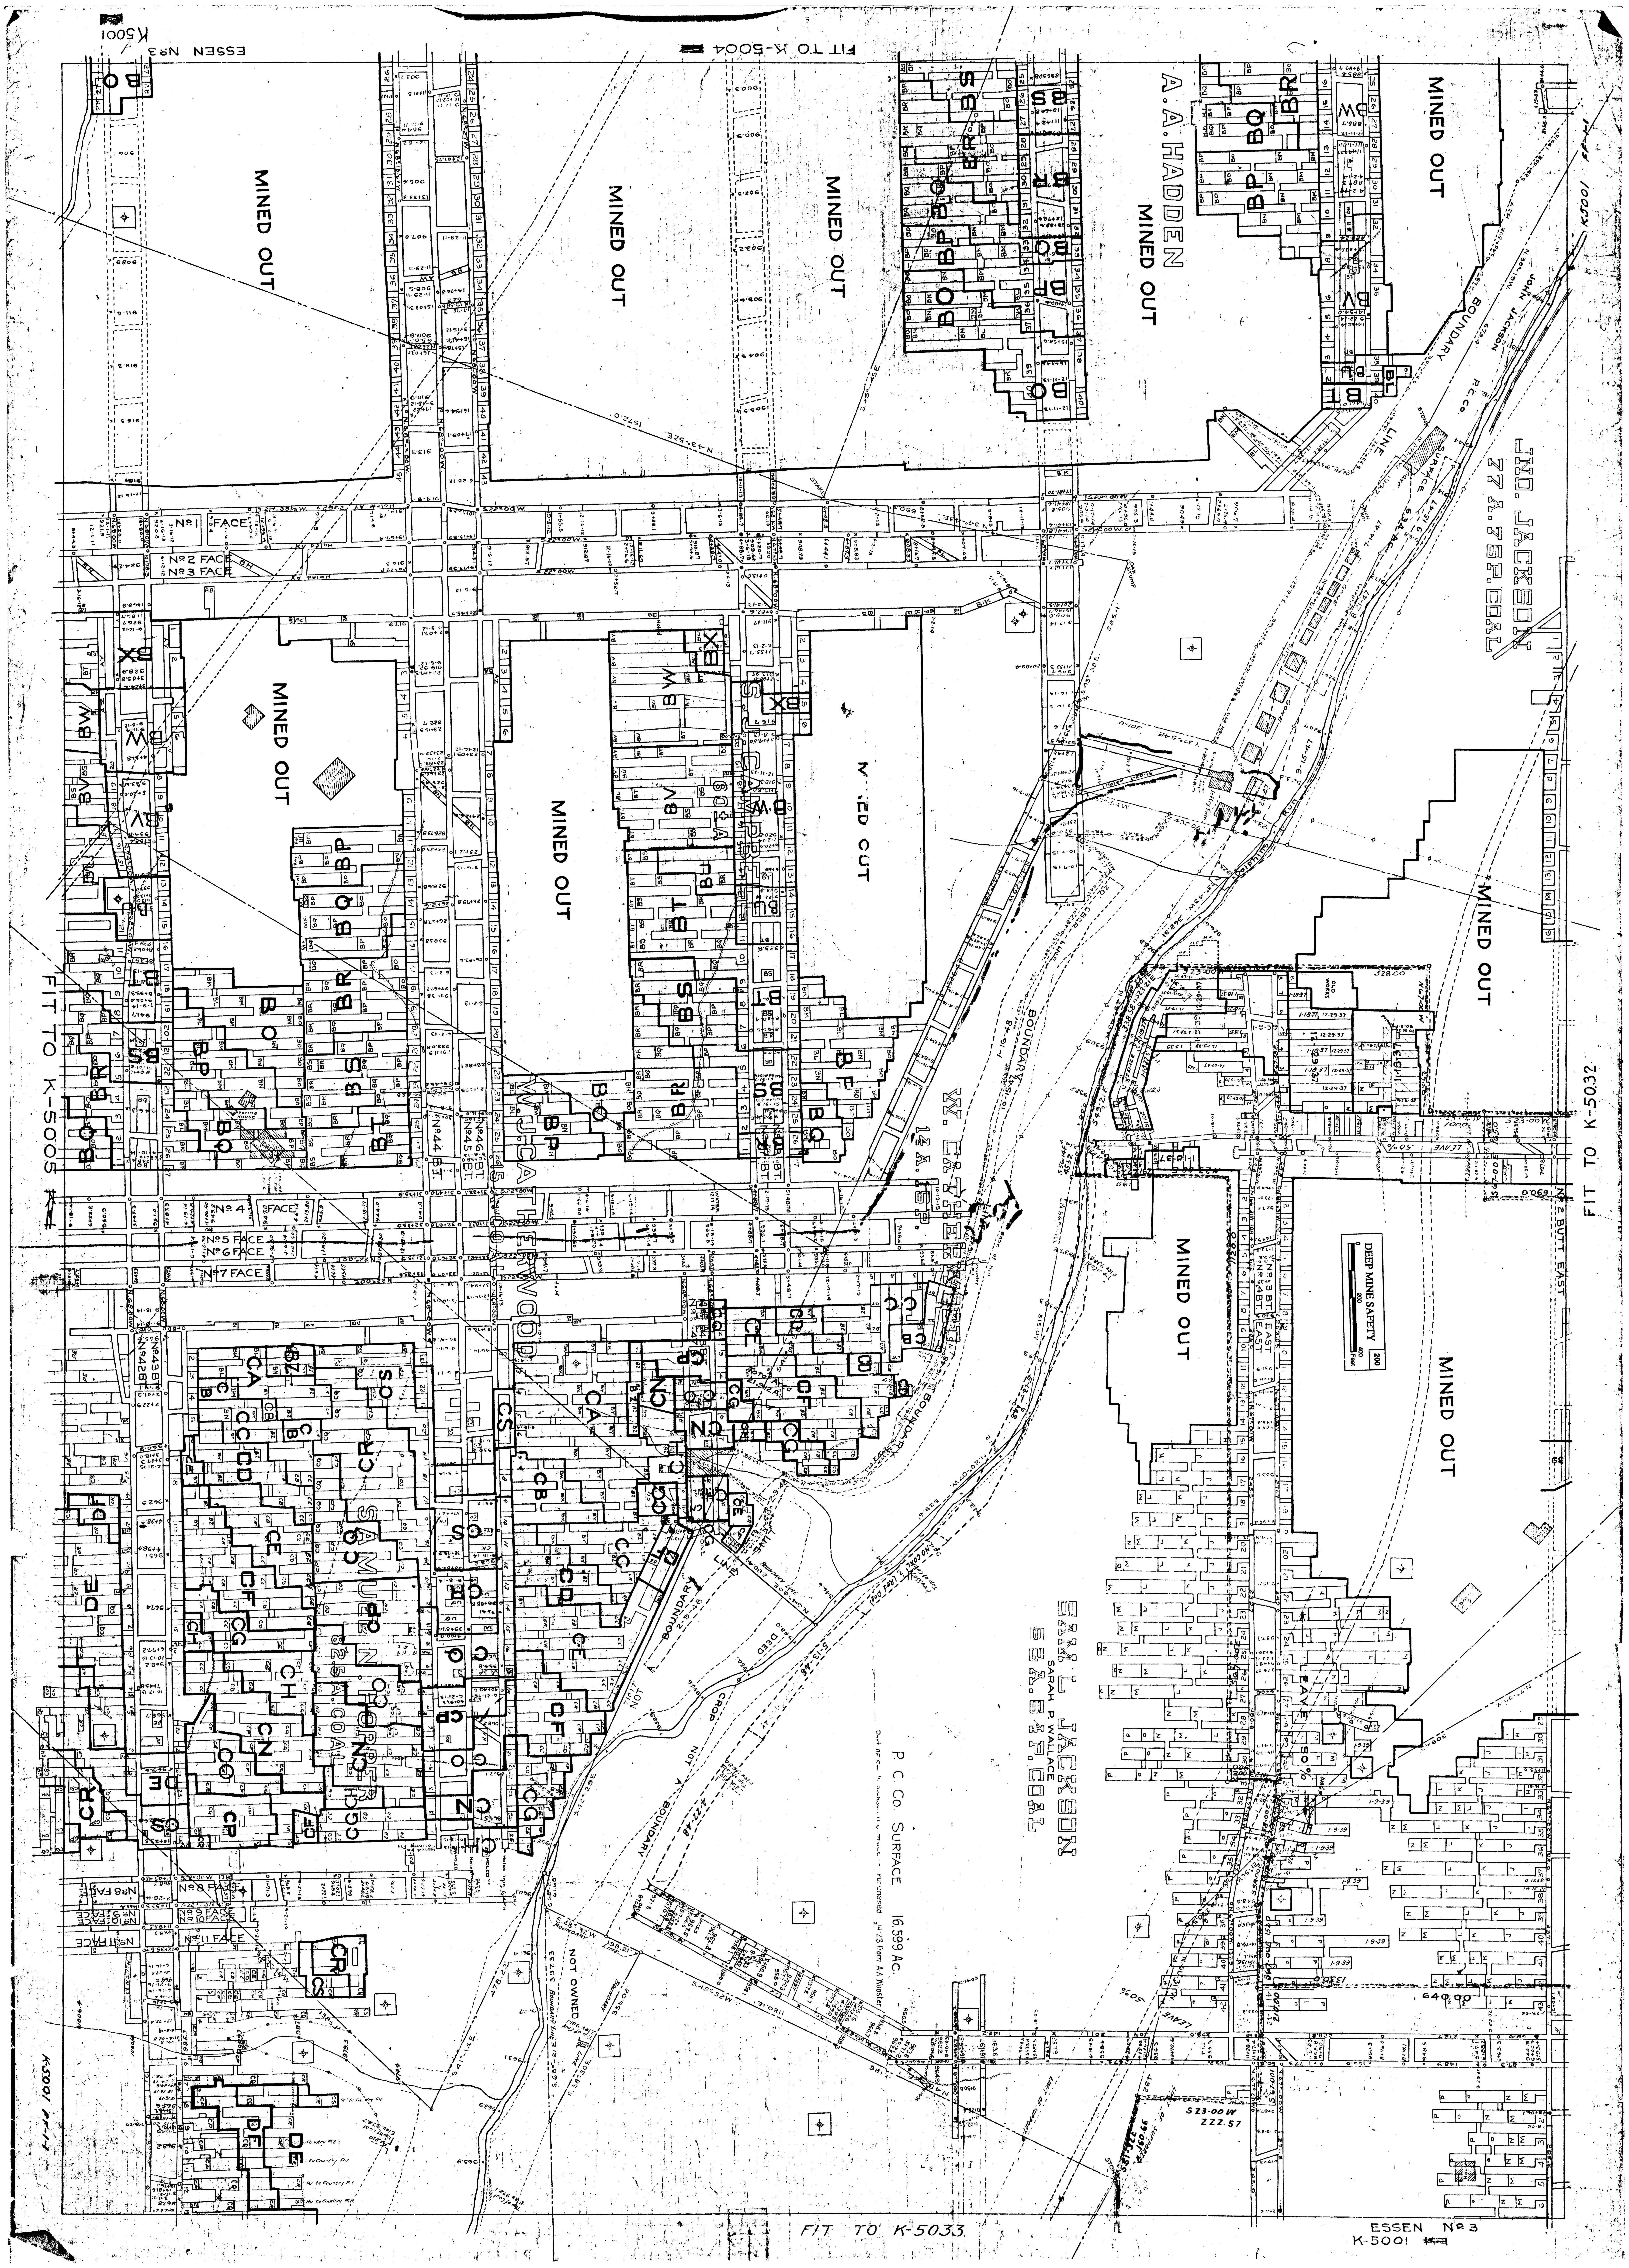
FIT TO K-5004
ESSEN No 3
K5001
MINED OUT
A. A. HADDEN
BOUNDARY LINE
P. C. Co. SURFACE
FIT TO K-5005
FIT TO K-5032
No 2 BUTT EAST
DEEP MINE SAFETY
No 1 FACE
No 2 FACE
No 3 FACE
No 4 FACE
No 5 FACE
No 6 FACE
No 7 FACE
No 8 FACE
No 9 FACE
No 10 FACE
No 11 FACE
P. C. Co. SURFACE 16.599 AC.
SARAH P. WALLACE
BOUNDARY
CROP
NOT OWNED
S23-00 W
222.57
640.00
FIT TO K-5033
ESSEN No 3
K-5001