


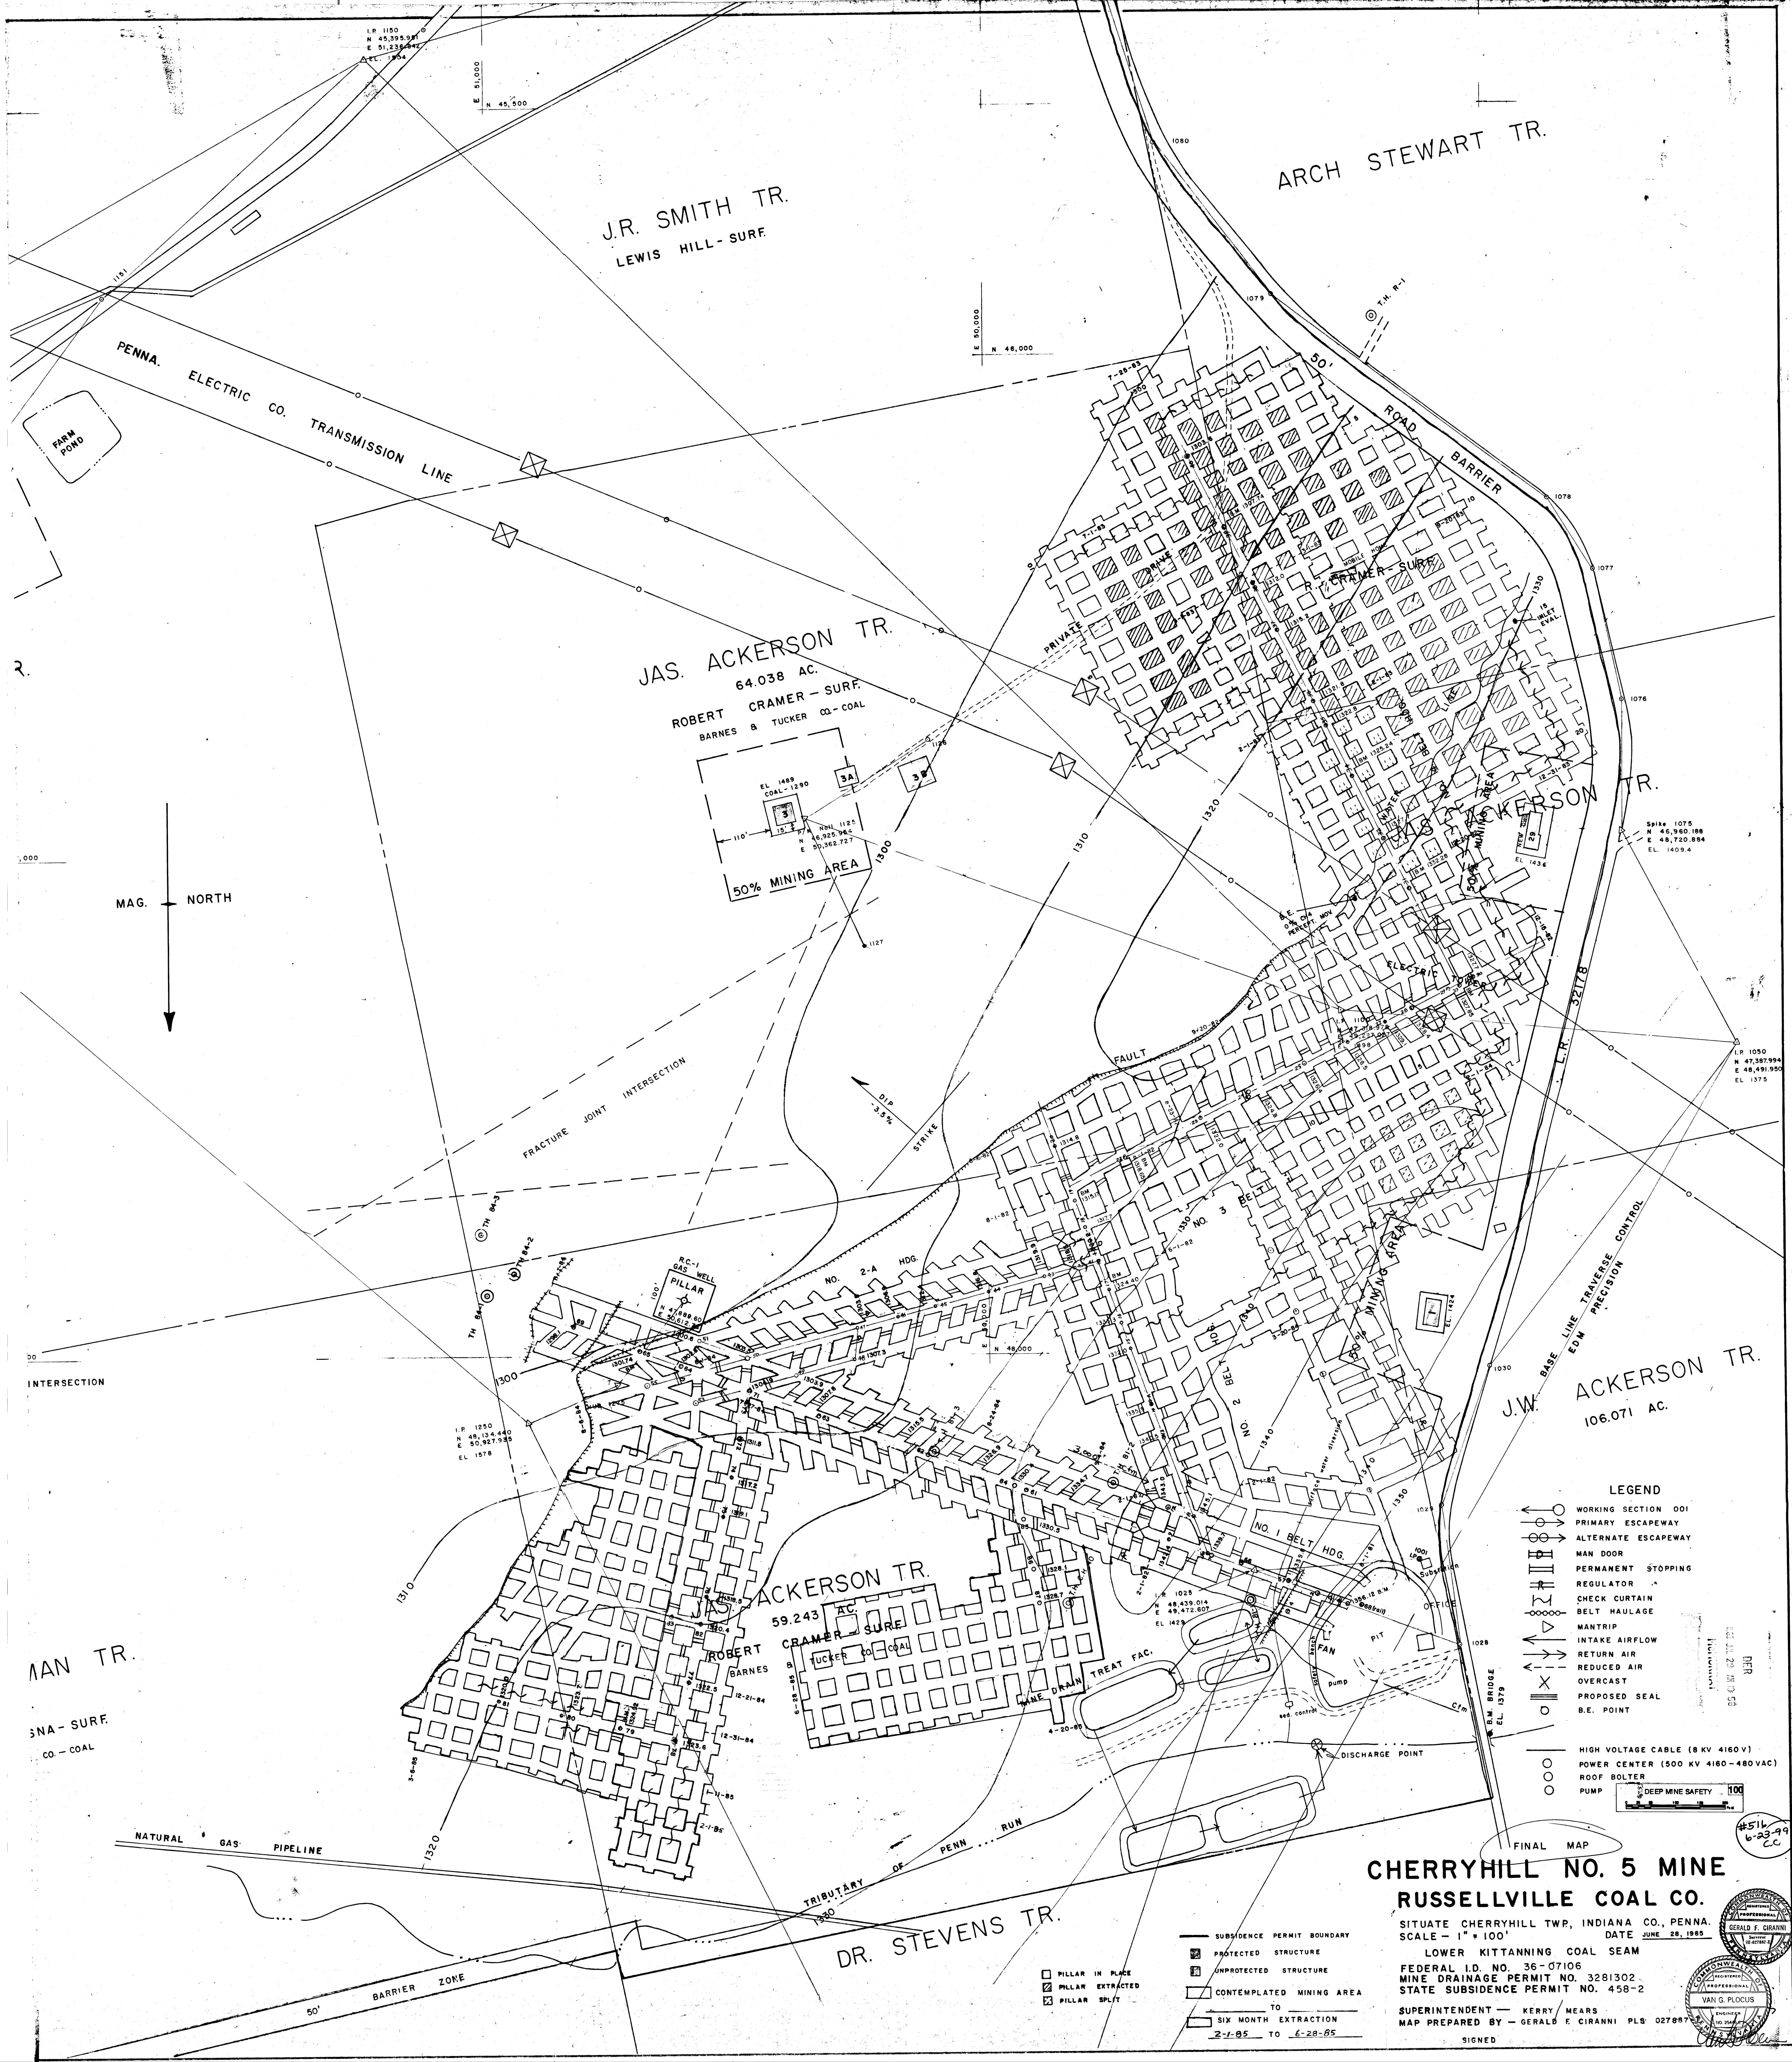

J.R. SMITH TR.
LEWIS HILL - SURF.

ARCH STEWART TR.

PENNA. ELECTRIC CO. TRANSMISSION LINE

JAS. ACKERSON TR.
64.038 AC.
ROBERT CRAMER - SURF.
BARNES & TUCKER CO. - COAL

50% MINING AREA

J.W. ACKERSON TR.

J.W. ACKERSON TR.
106.071 AC.

ACKERSON TR.
59.243 AC.
CRAMER SURF.
BARNES & TUCKER CO. - COAL

DR. STEVENS TR.

LEGEND

- WORKING SECTION 001
- PRIMARY ESCAPEWAY
- ALTERNATE ESCAPEWAY
- MAN DOOR
- PERMANENT STOPPING
- REGULATOR
- CHECK CURTAIN
- BELT HAULAGE
- MANTRIP
- INTAKE AIRFLOW
- RETURN AIR
- REDUCED AIR
- OVERCAST
- PROPOSED SEAL
- B.E. POINT
- HIGH VOLTAGE CABLE (8 KV 4160V)
- POWER CENTER (500 KV 4160-480 VAC)
- ROOF BOLTER
- PUMP
- DEEP MINE SAFETY

CHERRYHILL NO. 5 MINE
RUSSELLVILLE COAL CO.

SITUATE CHERRYHILL TWP, INDIANA CO., PENNA.
SCALE - 1" = 100'

LOWER KITTANNING COAL SEAM

FEDERAL I.D. NO. 36-07106

MINE DRAINAGE PERMIT NO. 3281302

STATE SUBSIDENCE PERMIT NO. 458-2

SUPERINTENDENT - KERRY MEARS

MAP PREPARED BY - GERALD F. CIRANNI PLS 027887

SIGNED

- SUBSIDENCE PERMIT BOUNDARY
- PROTECTED STRUCTURE
- UNPROTECTED STRUCTURE
- CONTEMPLATED MINING AREA
- PILLAR IN PLACE
- PILLAR EXTRACTED
- PILLAR SPLIT
- SIX MONTH EXTRACTION
- 2-1-85 TO 6-28-85