


V. MERCER

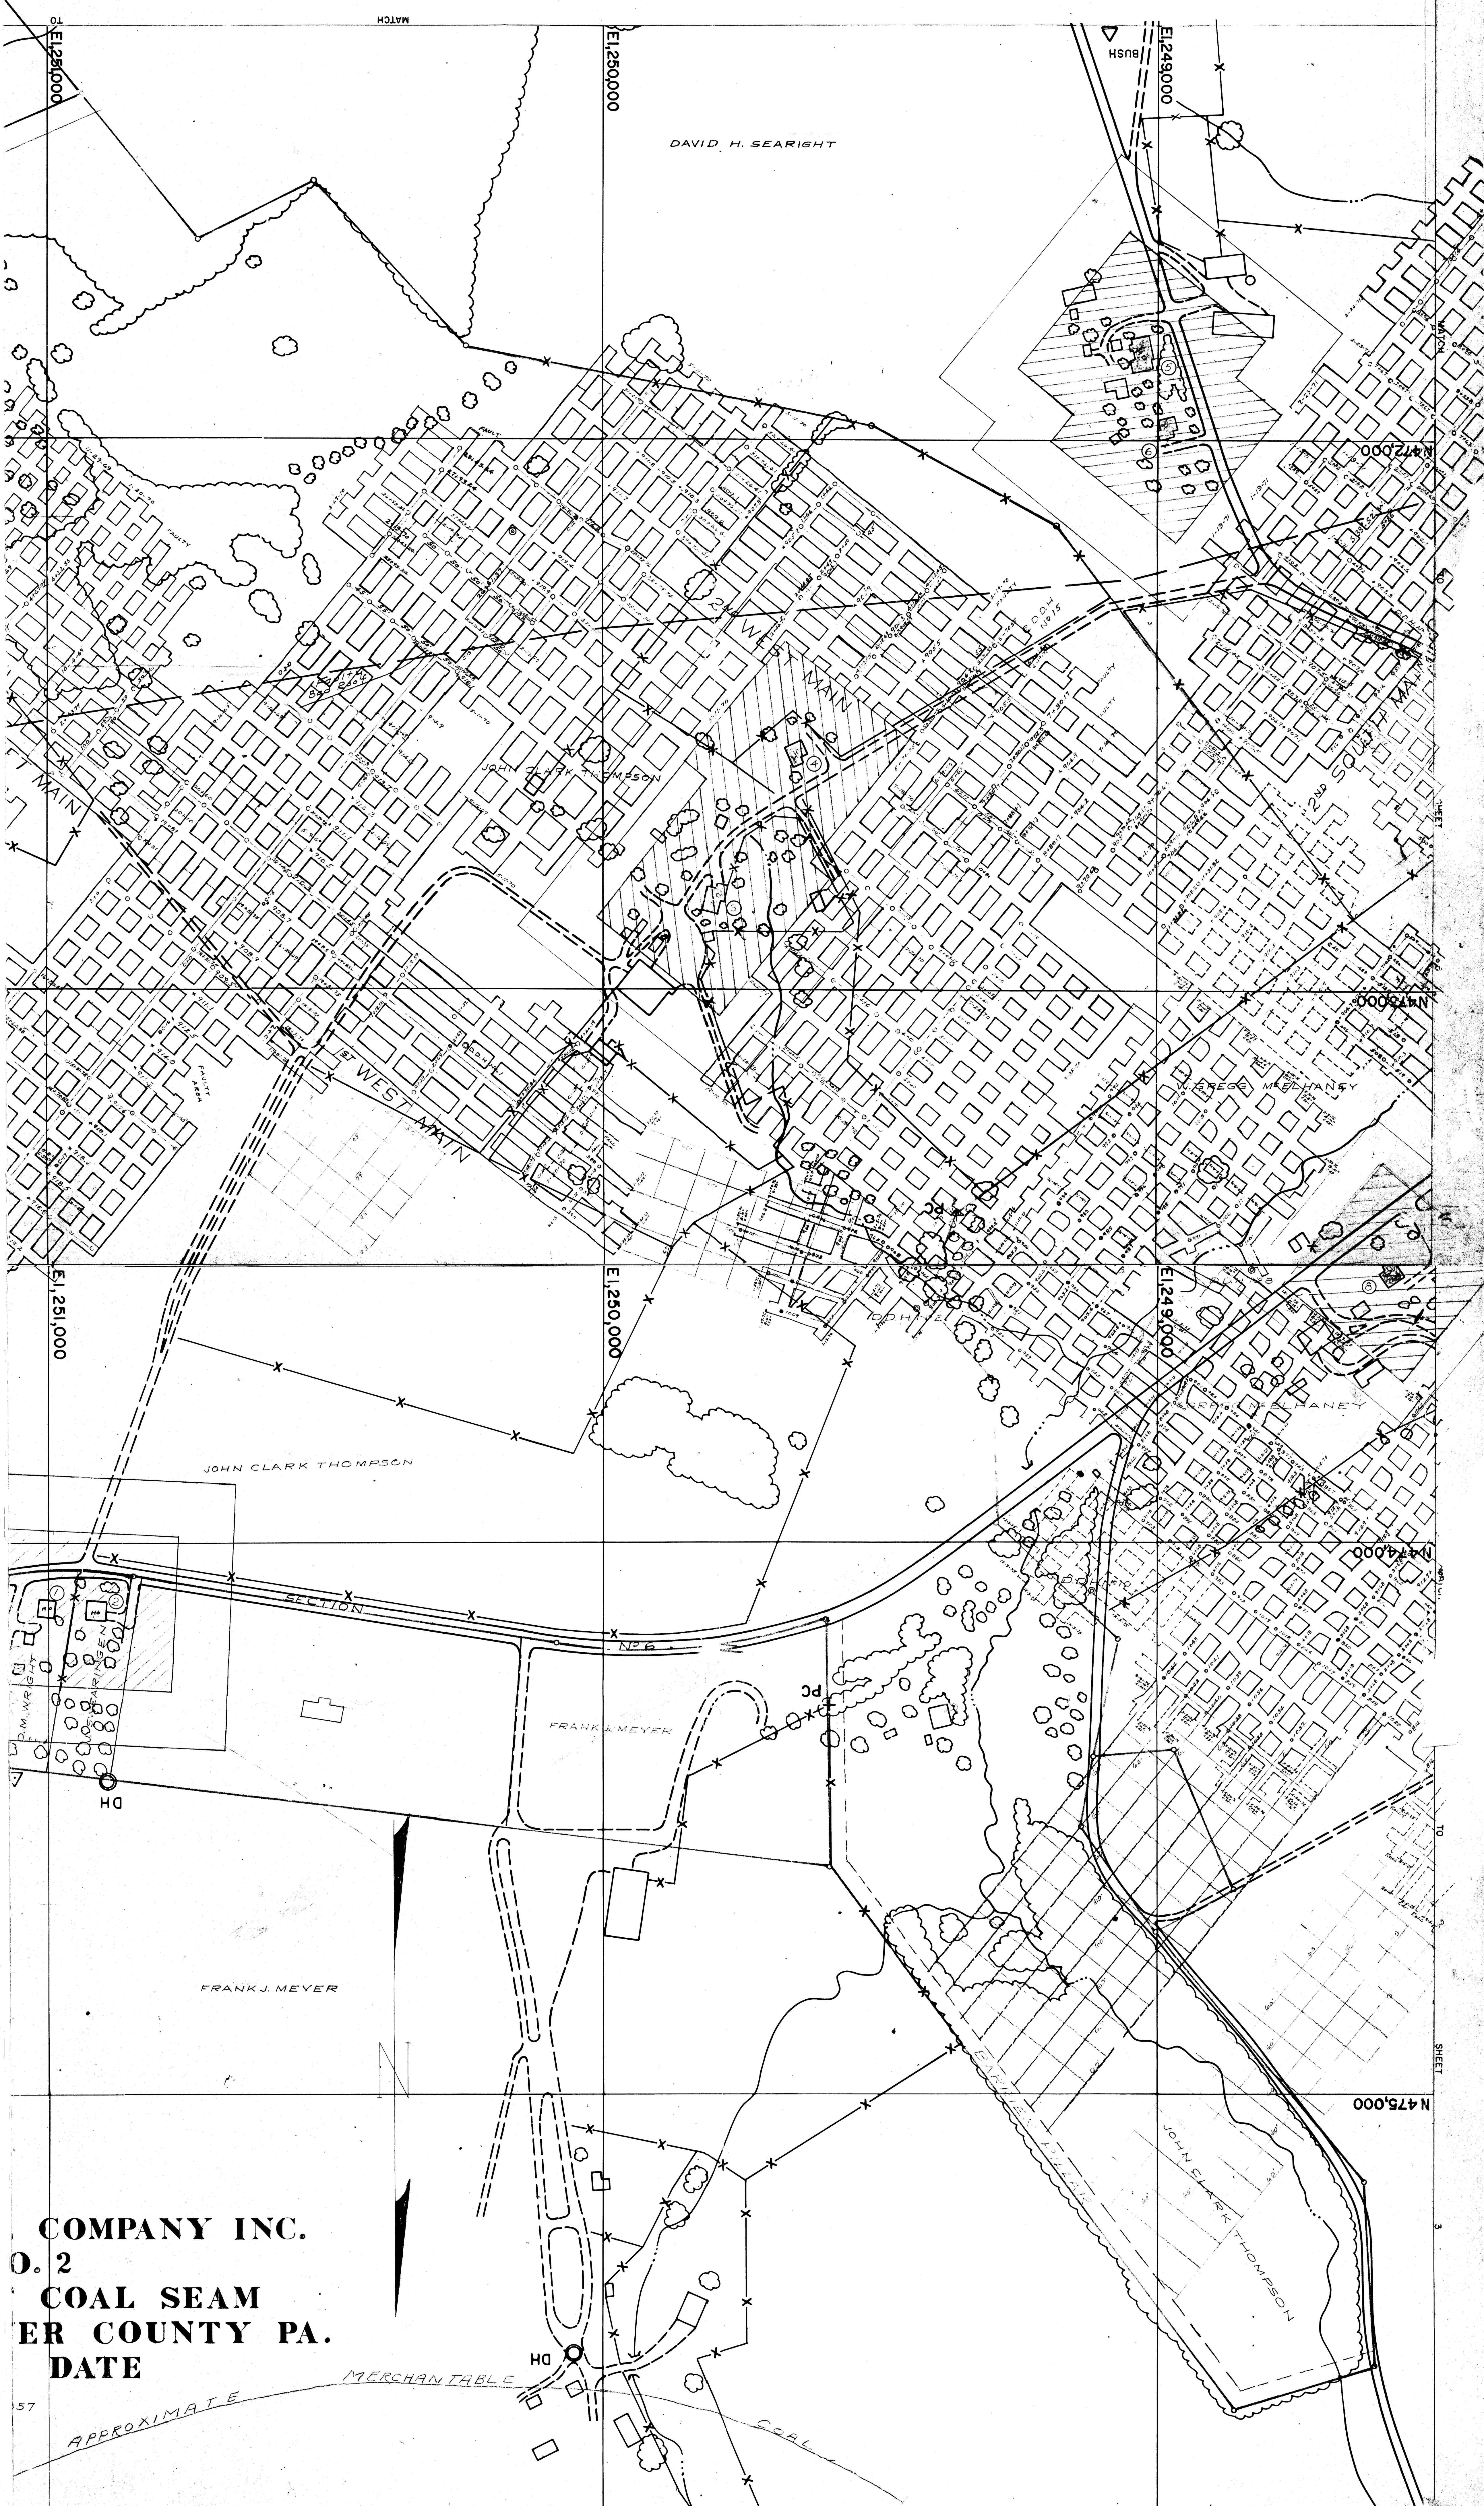

COMPANY INC.
O. 2
COAL SEAM
MERCER COUNTY PA.
DATE