


UNITED STATES
DEPARTMENT OF THE INTERIOR
GEOLOGICAL SURVEY

AMENDED MINING AREA
PEGGS RUN COAL COMPANY INC.
MINE NO. 2
UPPER FREEPORT COAL SEAM
GREENE TWP. BEAVER COUNTY PA.
DATE 5-27-1975

LEGEND

PRESENT MINING AREA
AMENDED AREA

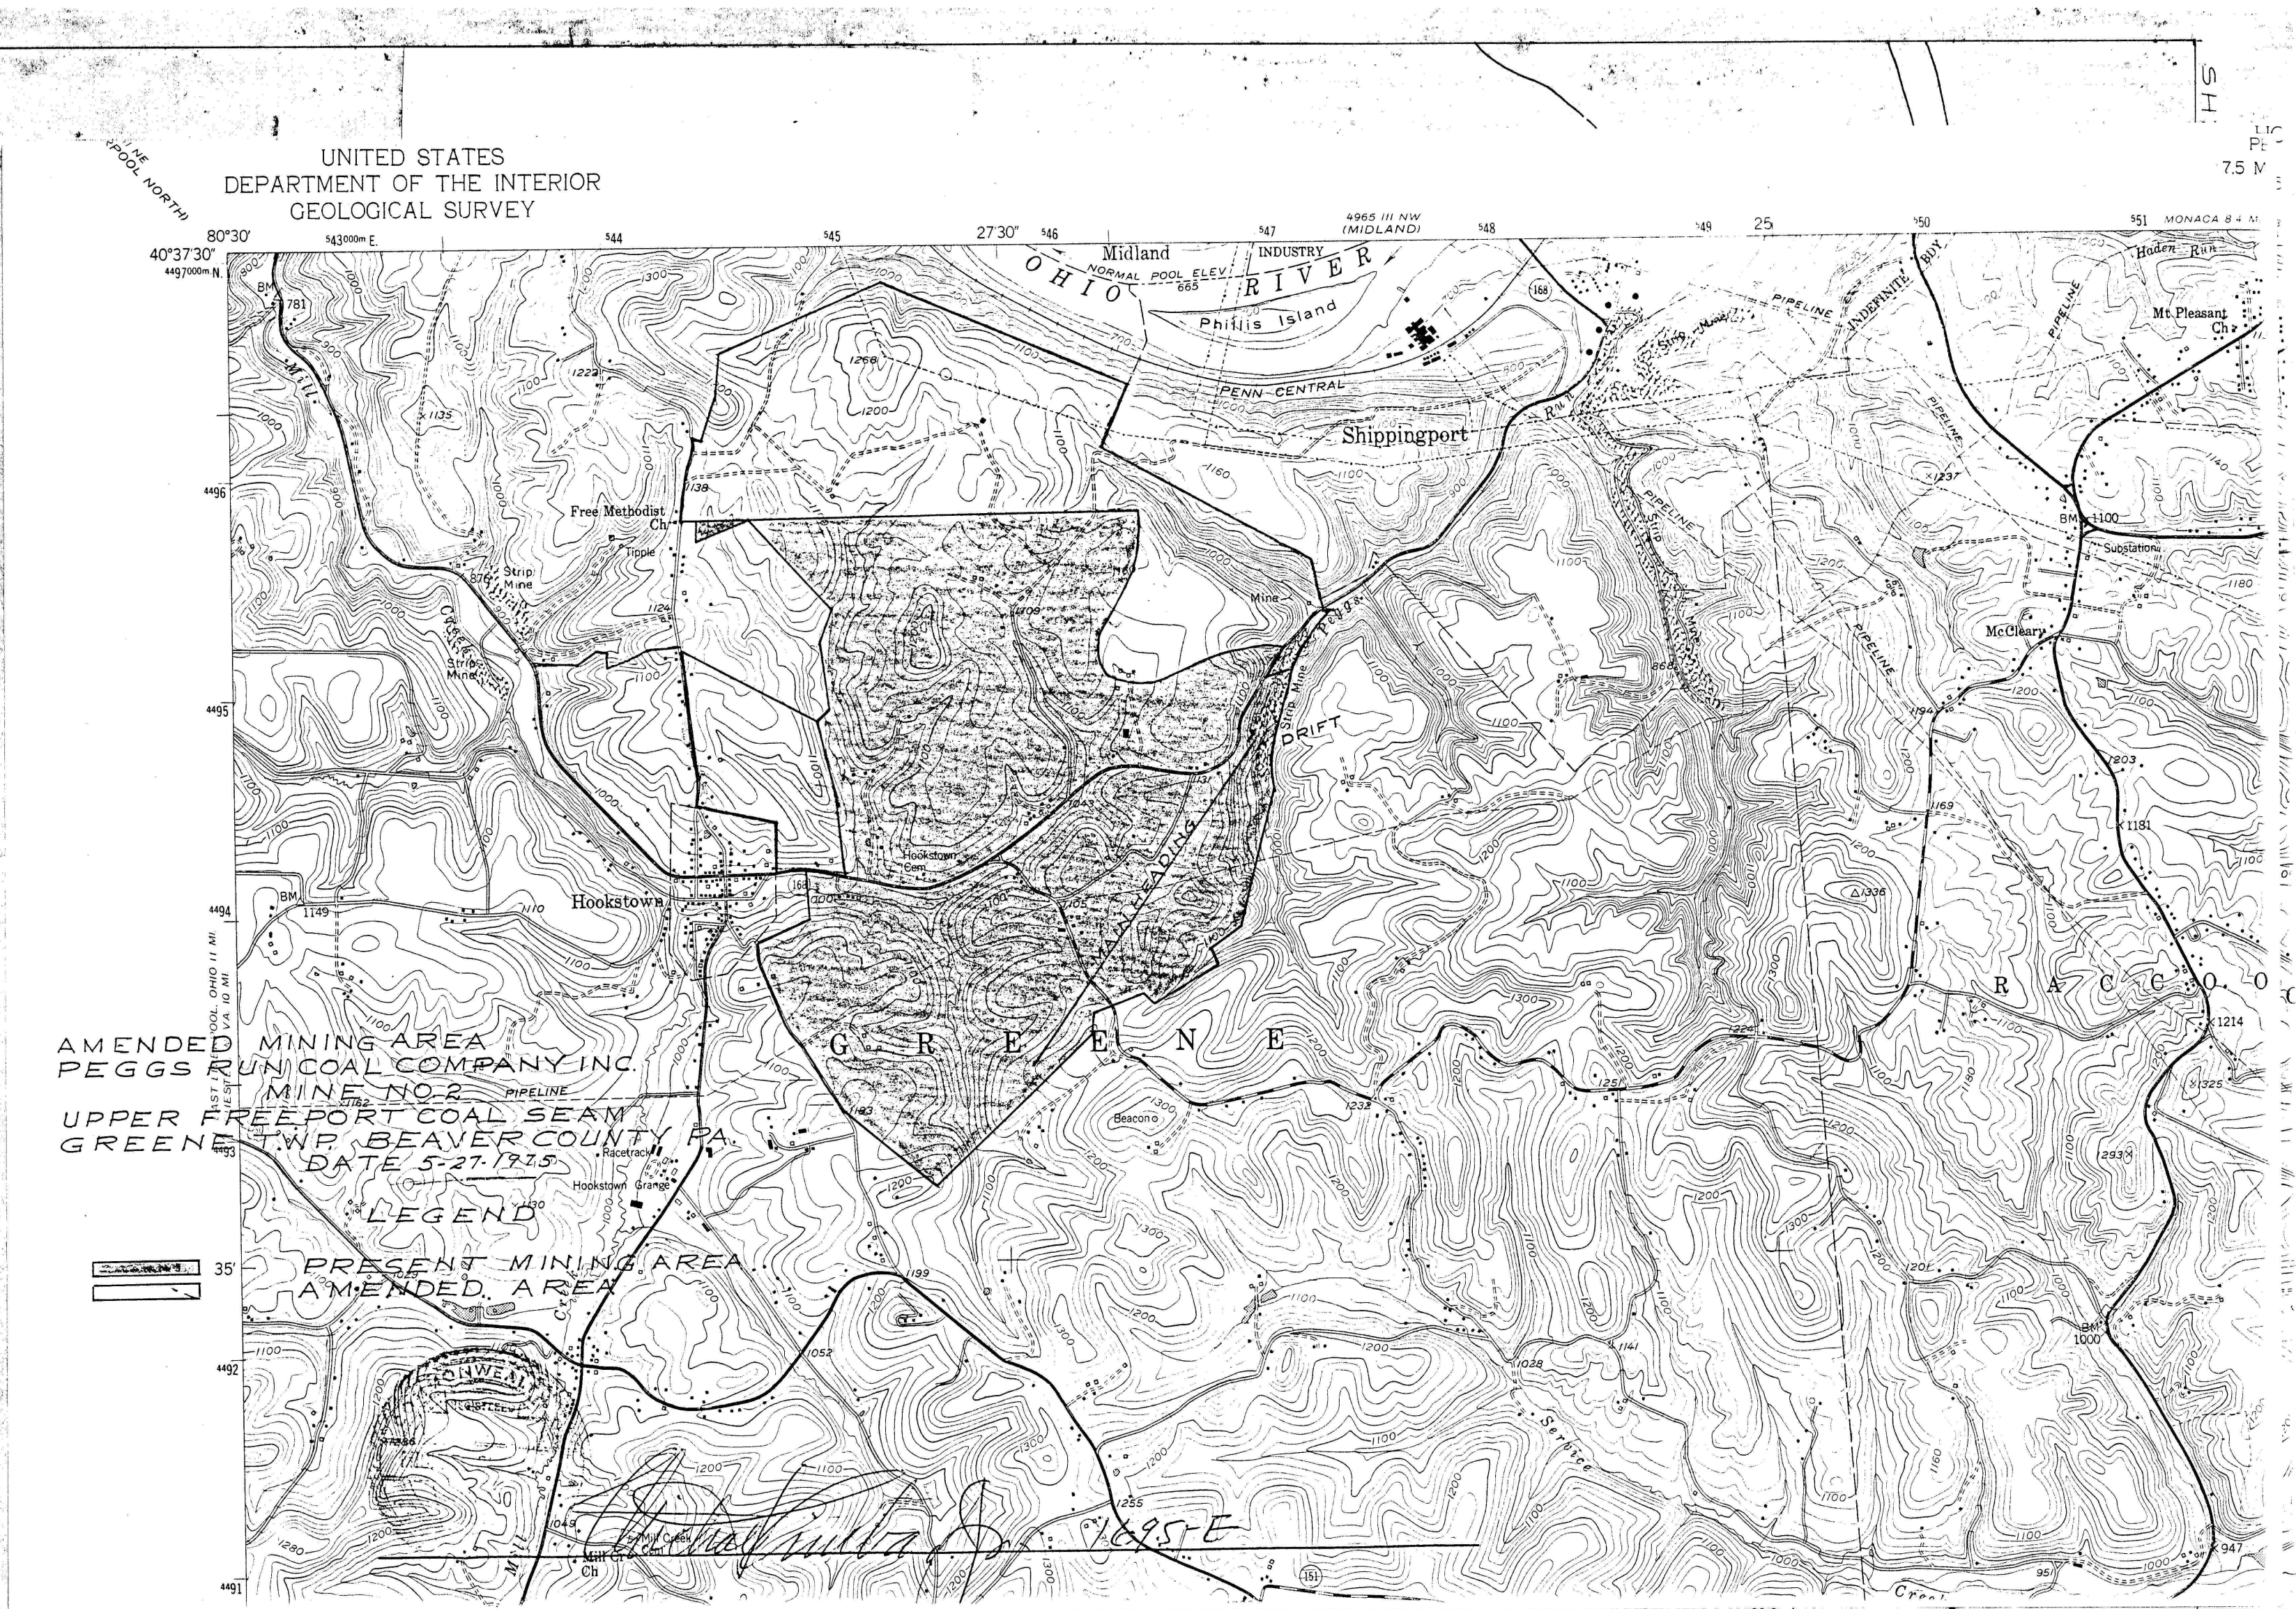

HS
LIC
PL
7.5 M