


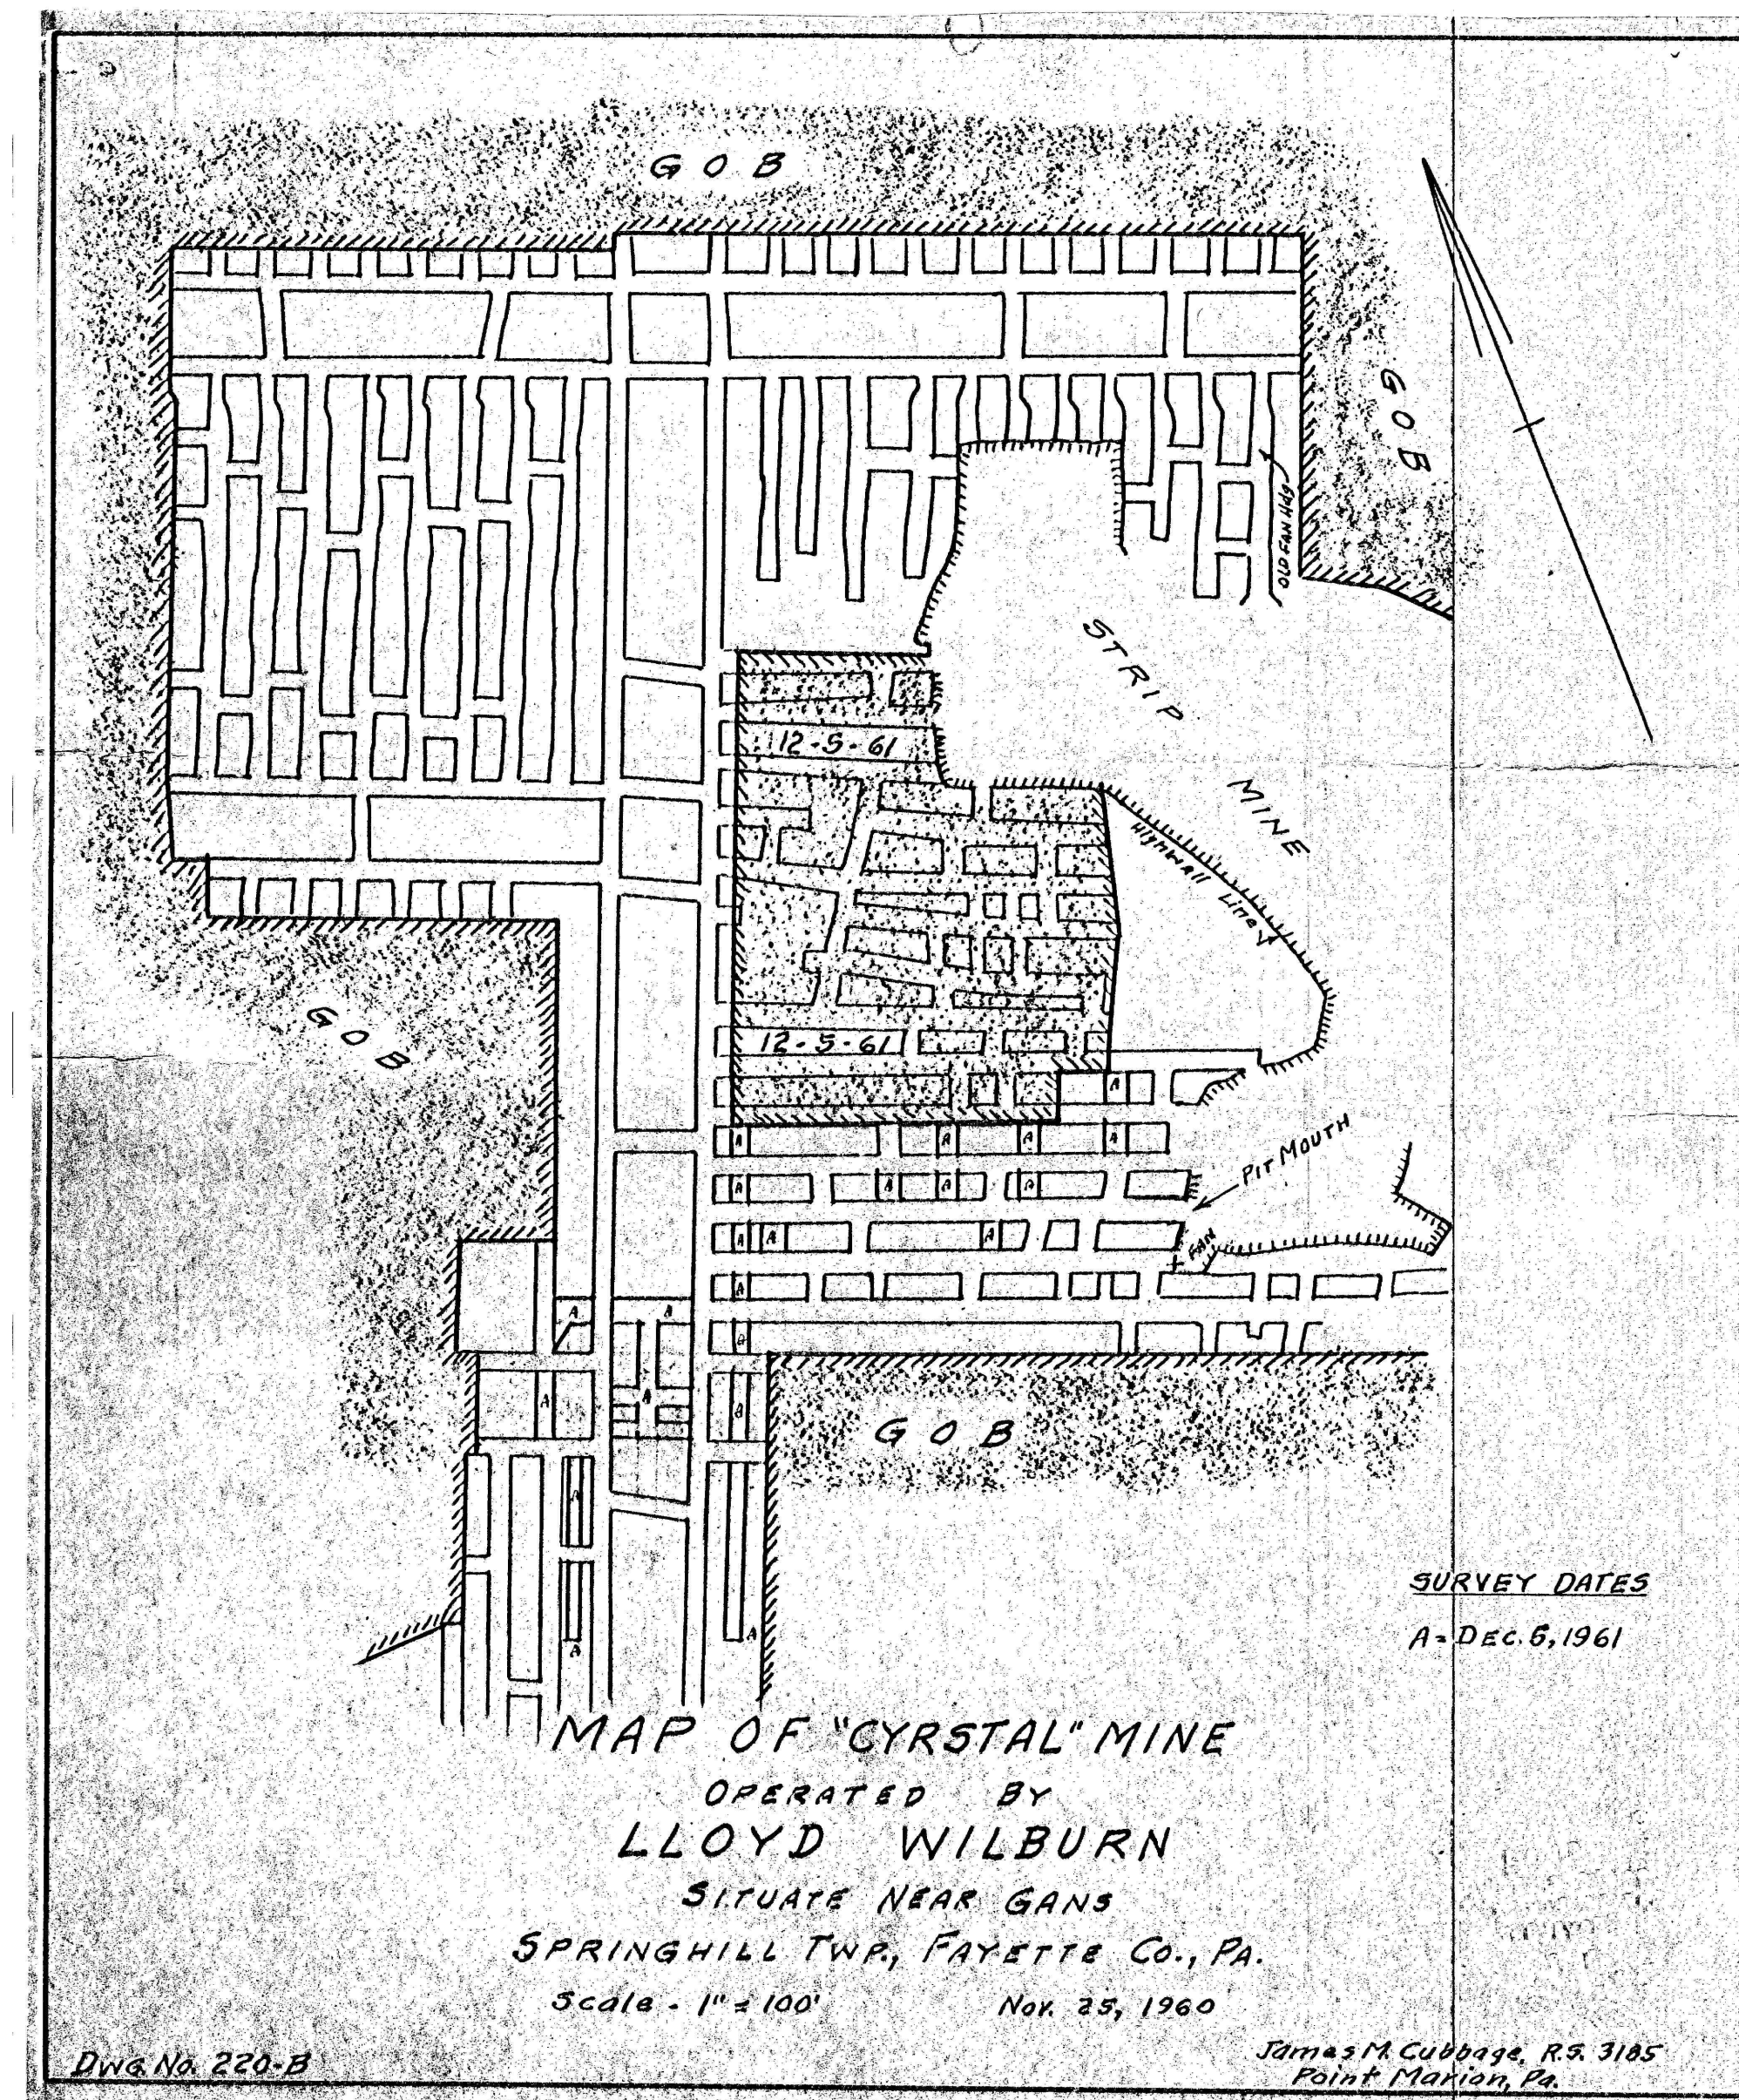

SURVEY DATES
A- Dec. 6, 1961

MAP OF "CRYSTAL" MINE
OPERATED BY
LLOYD WILBURN
SITUATE NEAR GANS
SPRINGHILL TWP., FAYETTE CO., PA.
Scale - 1" = 100' Nov. 23, 1960

DWG. NO. 220-B

James M. Cuddeback, R.S. 3105
Point Marion, Pa.