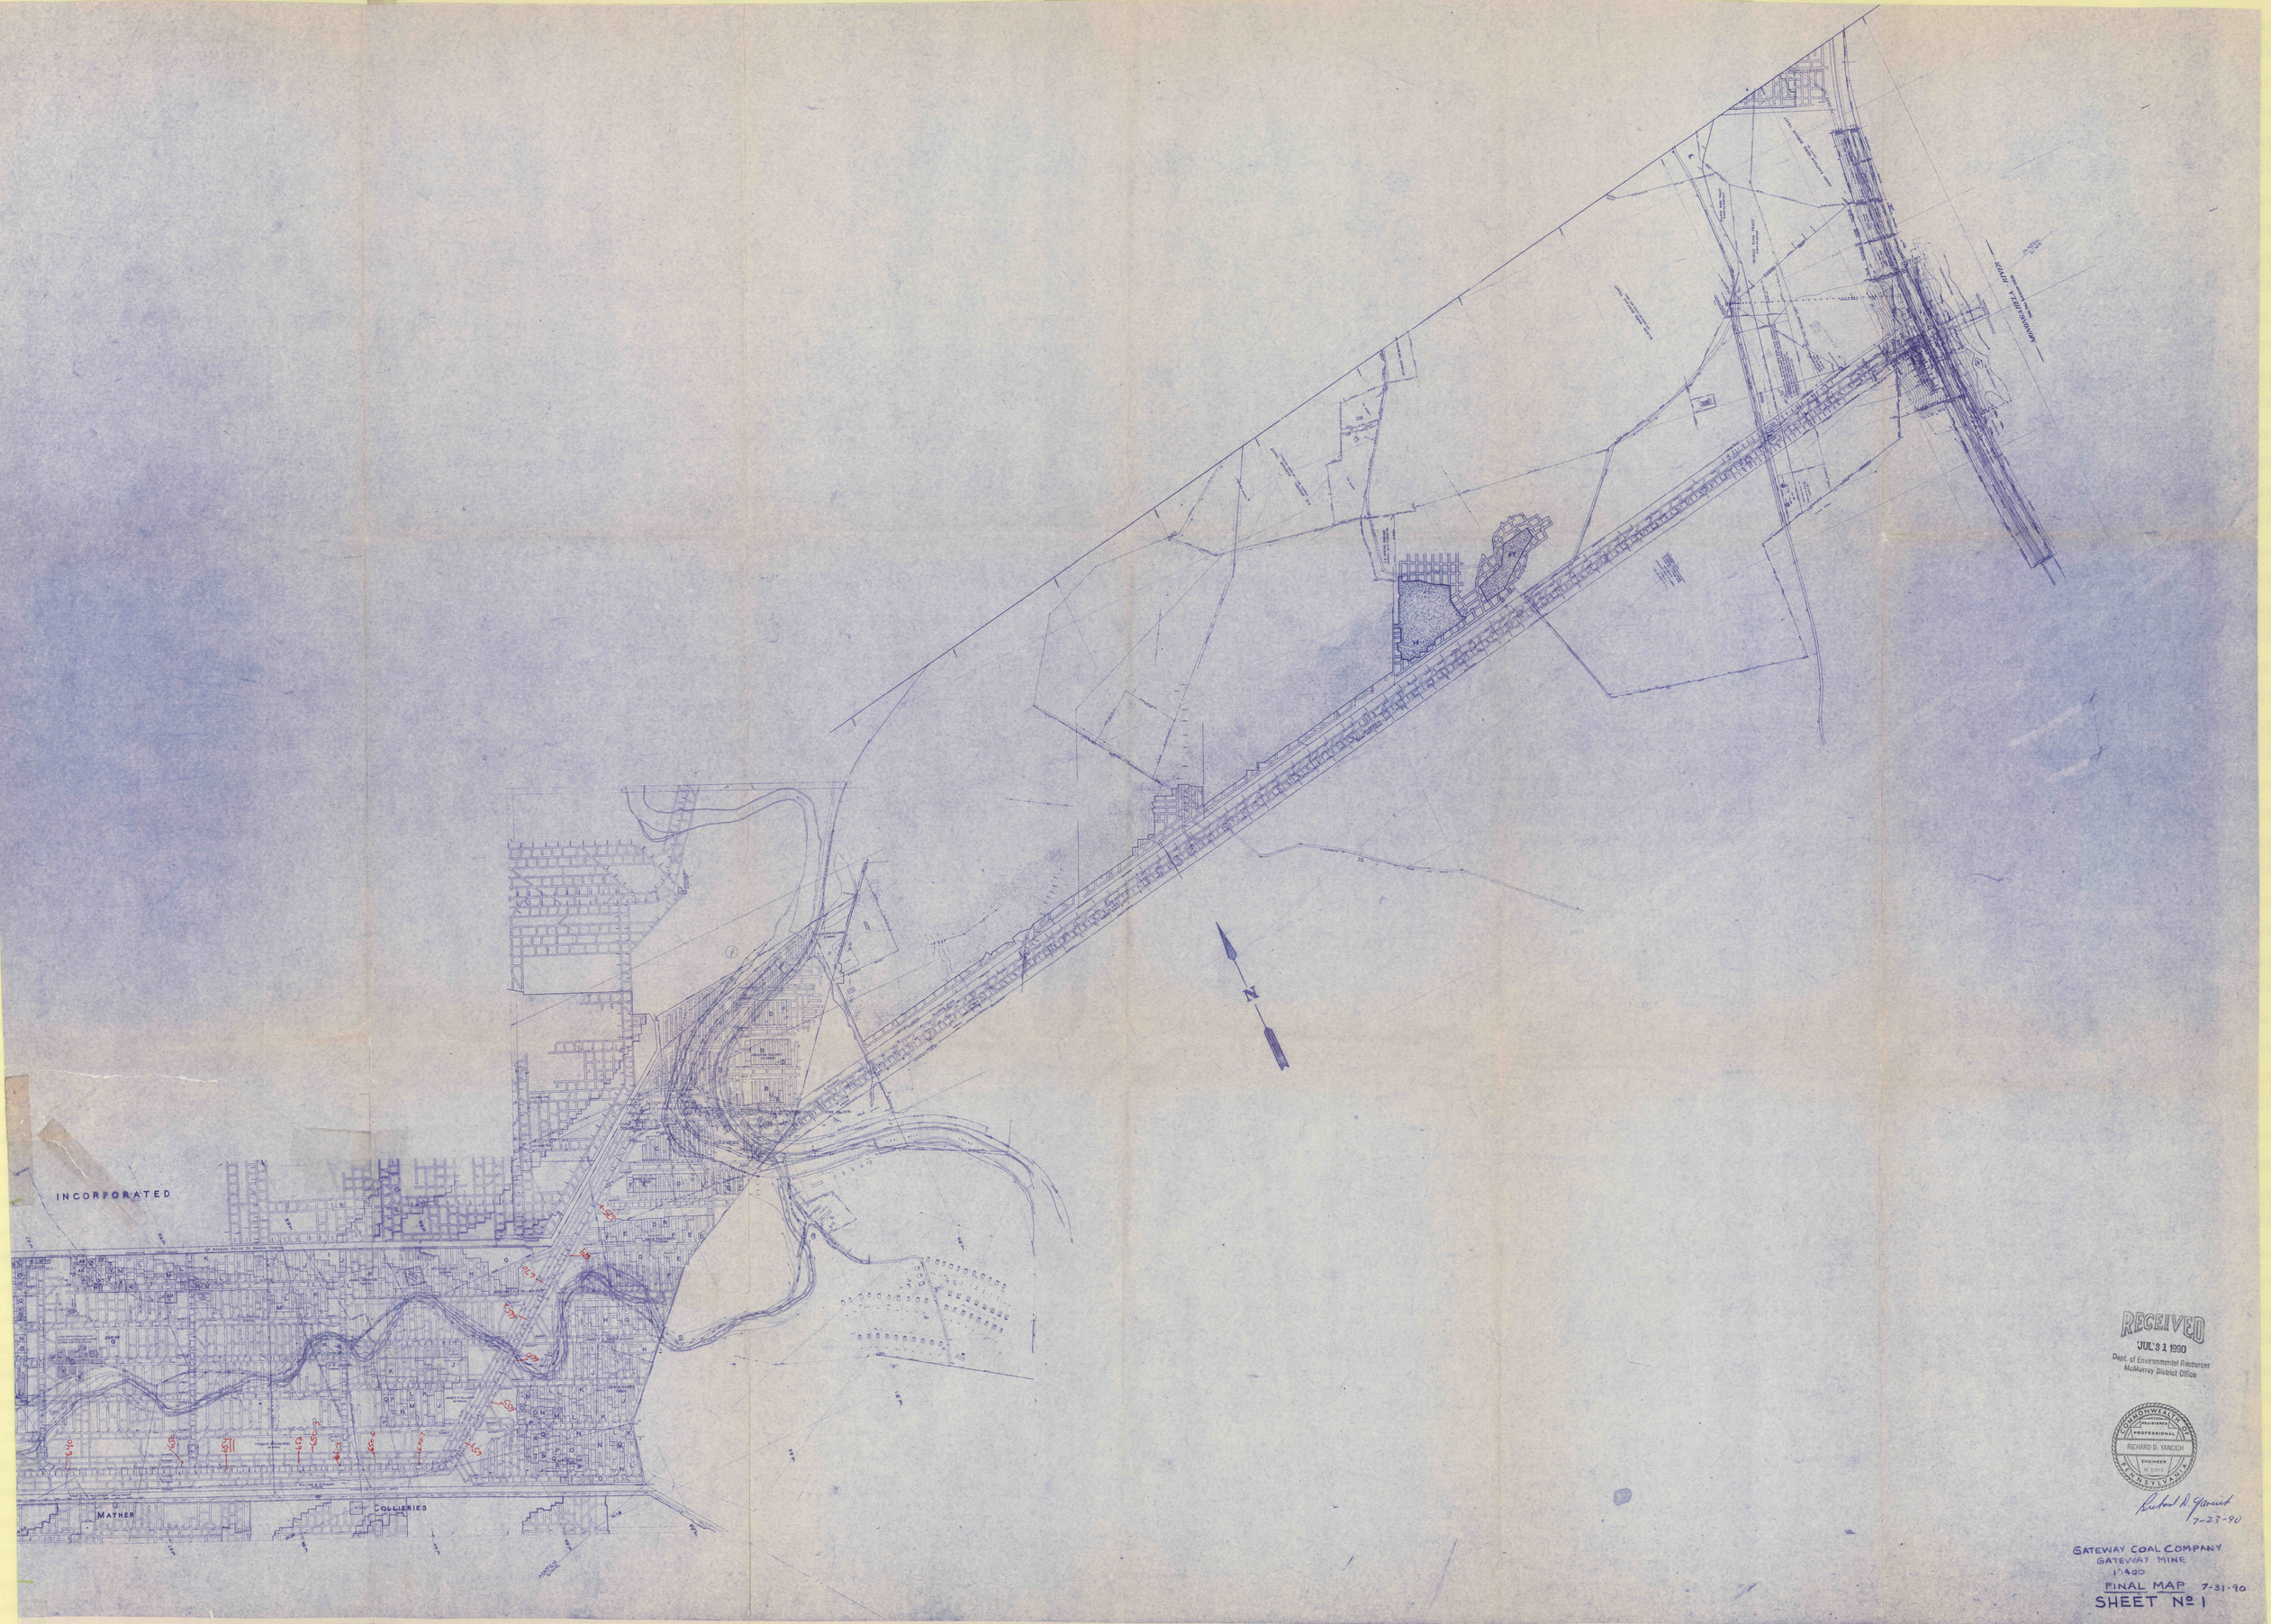

RECEIVED
JUL 31 1990
Dept. of Environmental Resources
McMurray District Office

COMMONWEALTH OF PENNSYLVANIA
REGISTERED PROFESSIONAL
RICHARD D. YANCICH
ENGINEER

Richard D. Yancich 7-23-90

GATEWAY COAL COMPANY
GATEWAY MINE
1"=400'
FINAL MAP 7-31-90
SHEET Nº 1