


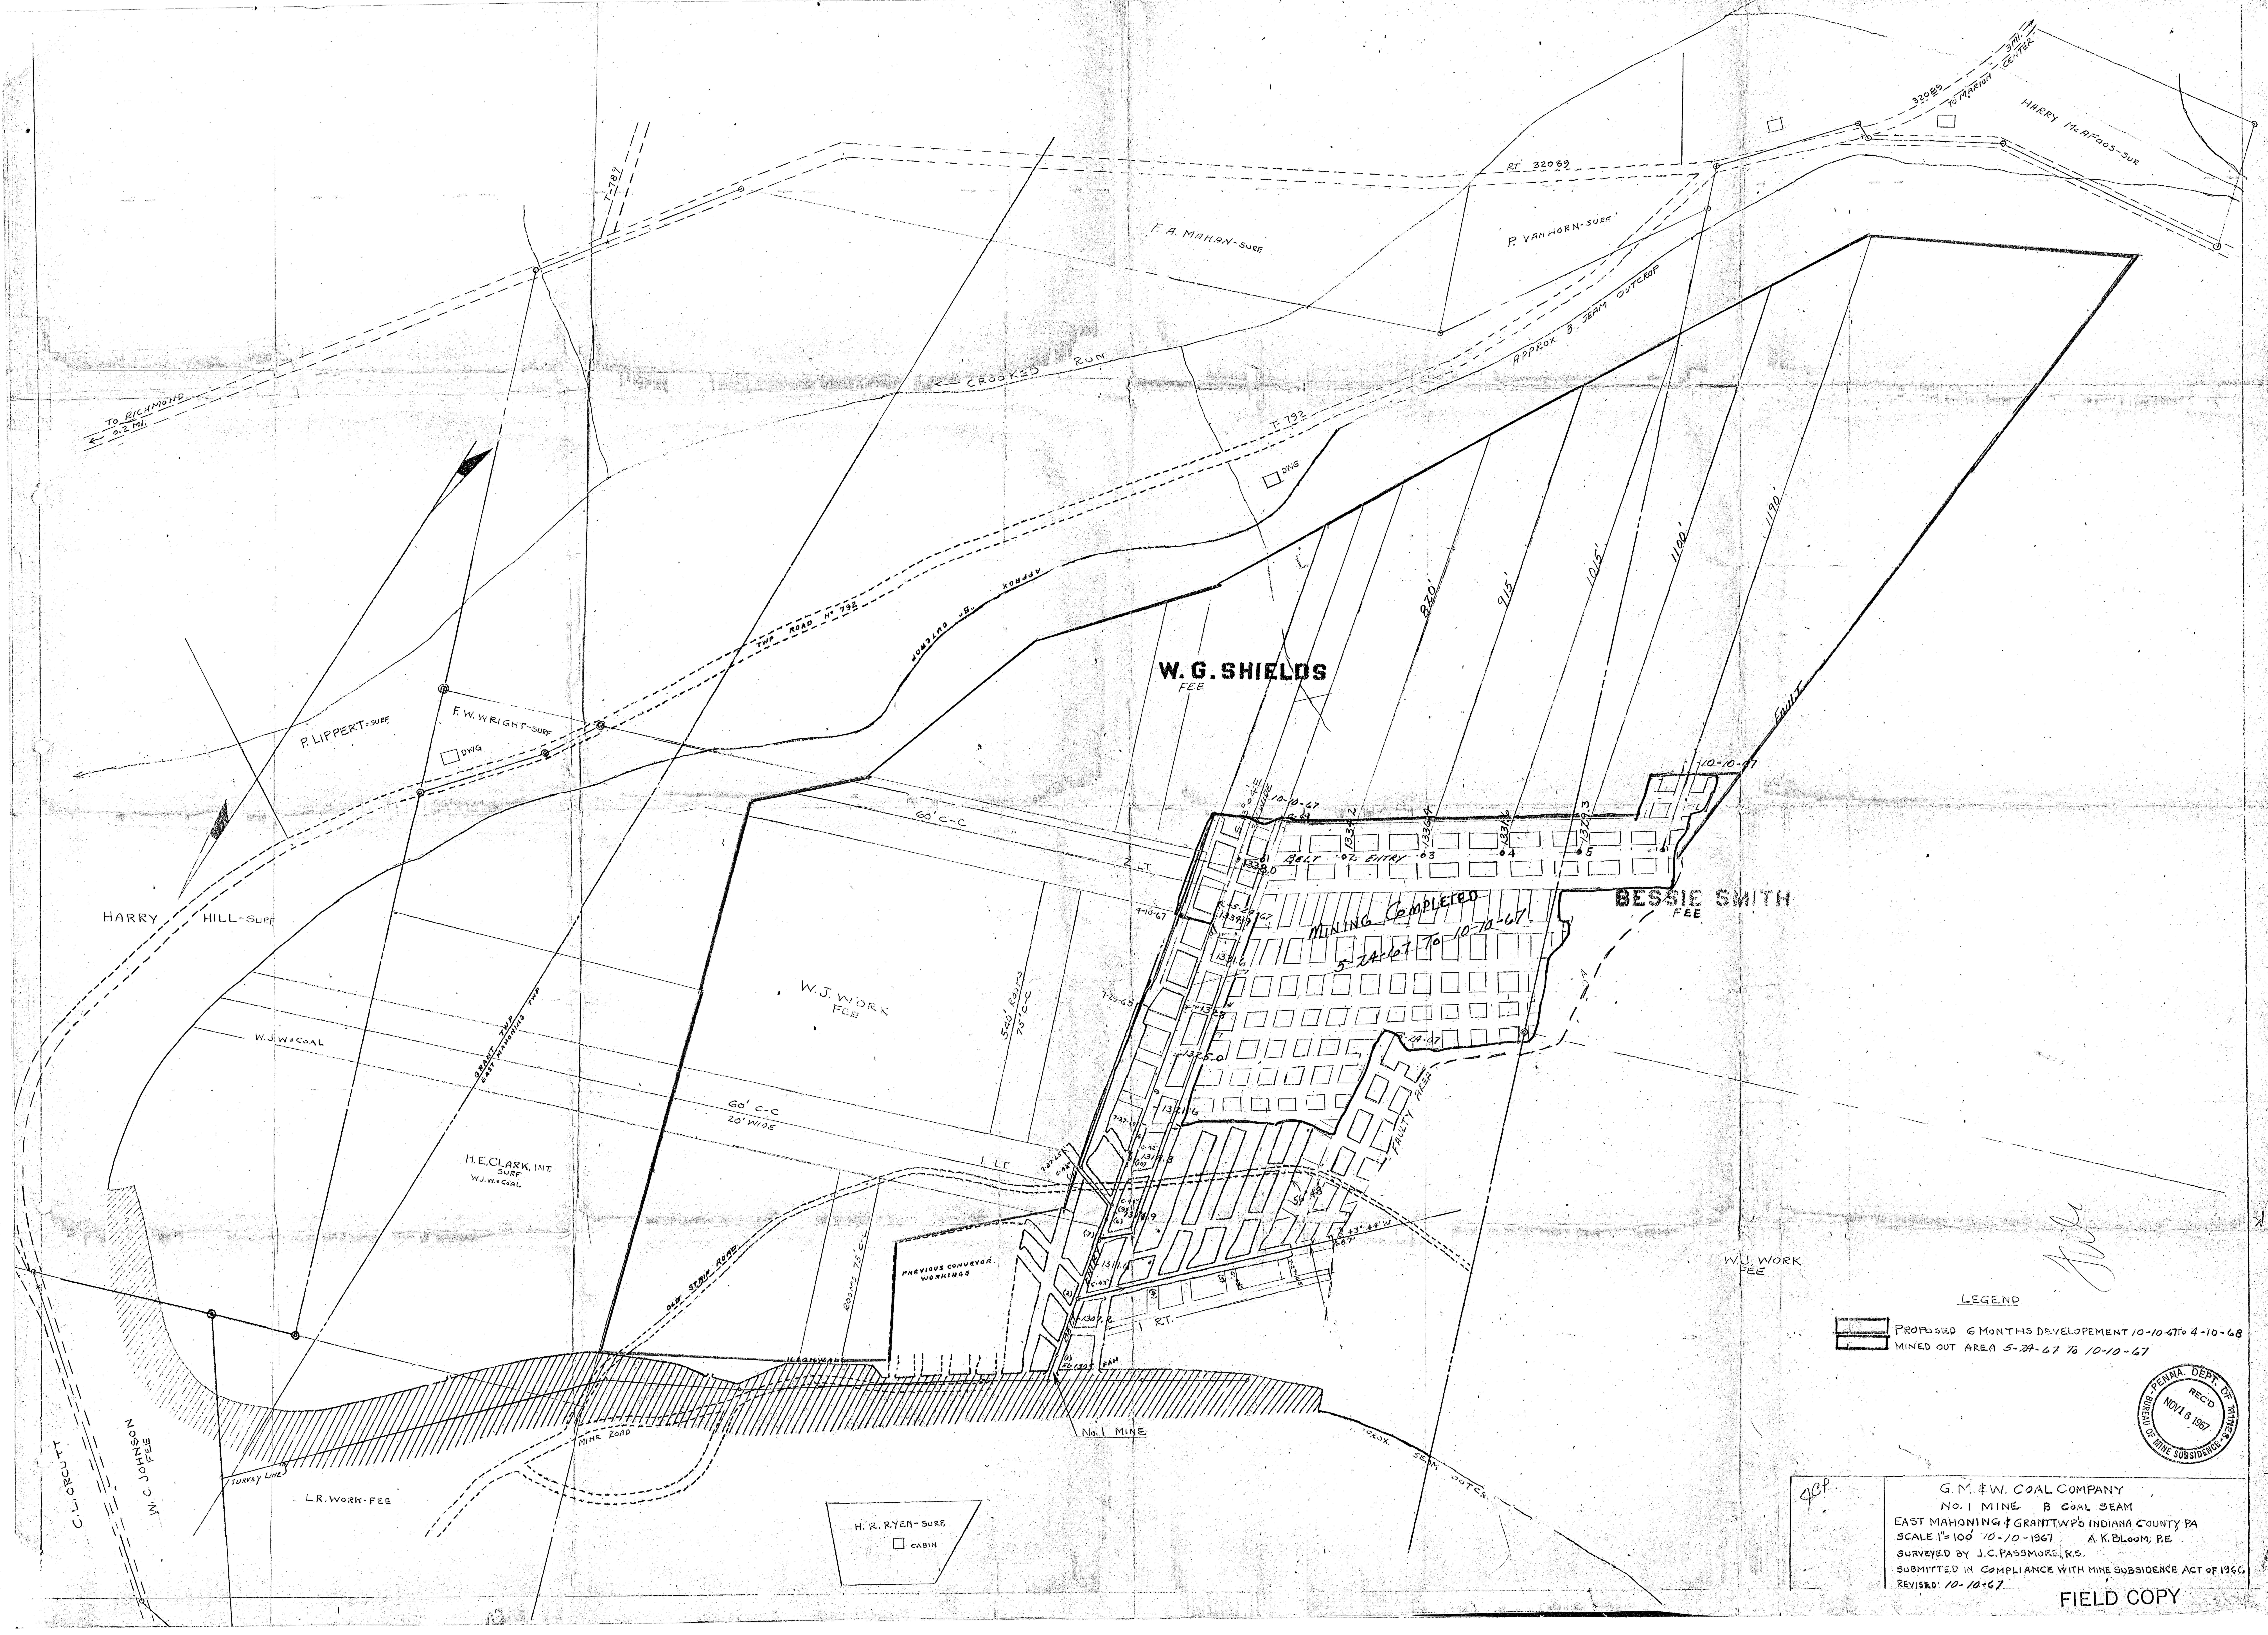

LEGEND  
[Symbol] PROPOSED 6 MONTHS DEVELOPMENT 10-10-67 TO 4-10-68  
[Symbol] MINED OUT AREA 5-24-67 TO 10-10-67

RECD  
NOV 18 1967  

G.M. & W. COAL COMPANY  
NO. 1 MINE B COAL SEAM  
EAST MAHONING & GRANT TWP'S INDIANA COUNTY PA  
SCALE 1"=100' 10-10-1967 A.K. BLOOM, P.E.  
SURVEYED BY J.C. PASSMORE, R.S.  
SUBMITTED IN COMPLIANCE WITH MINE SUBSIDENCE ACT OF 1966  
REVISED 10-10-67

FIELD COPY