


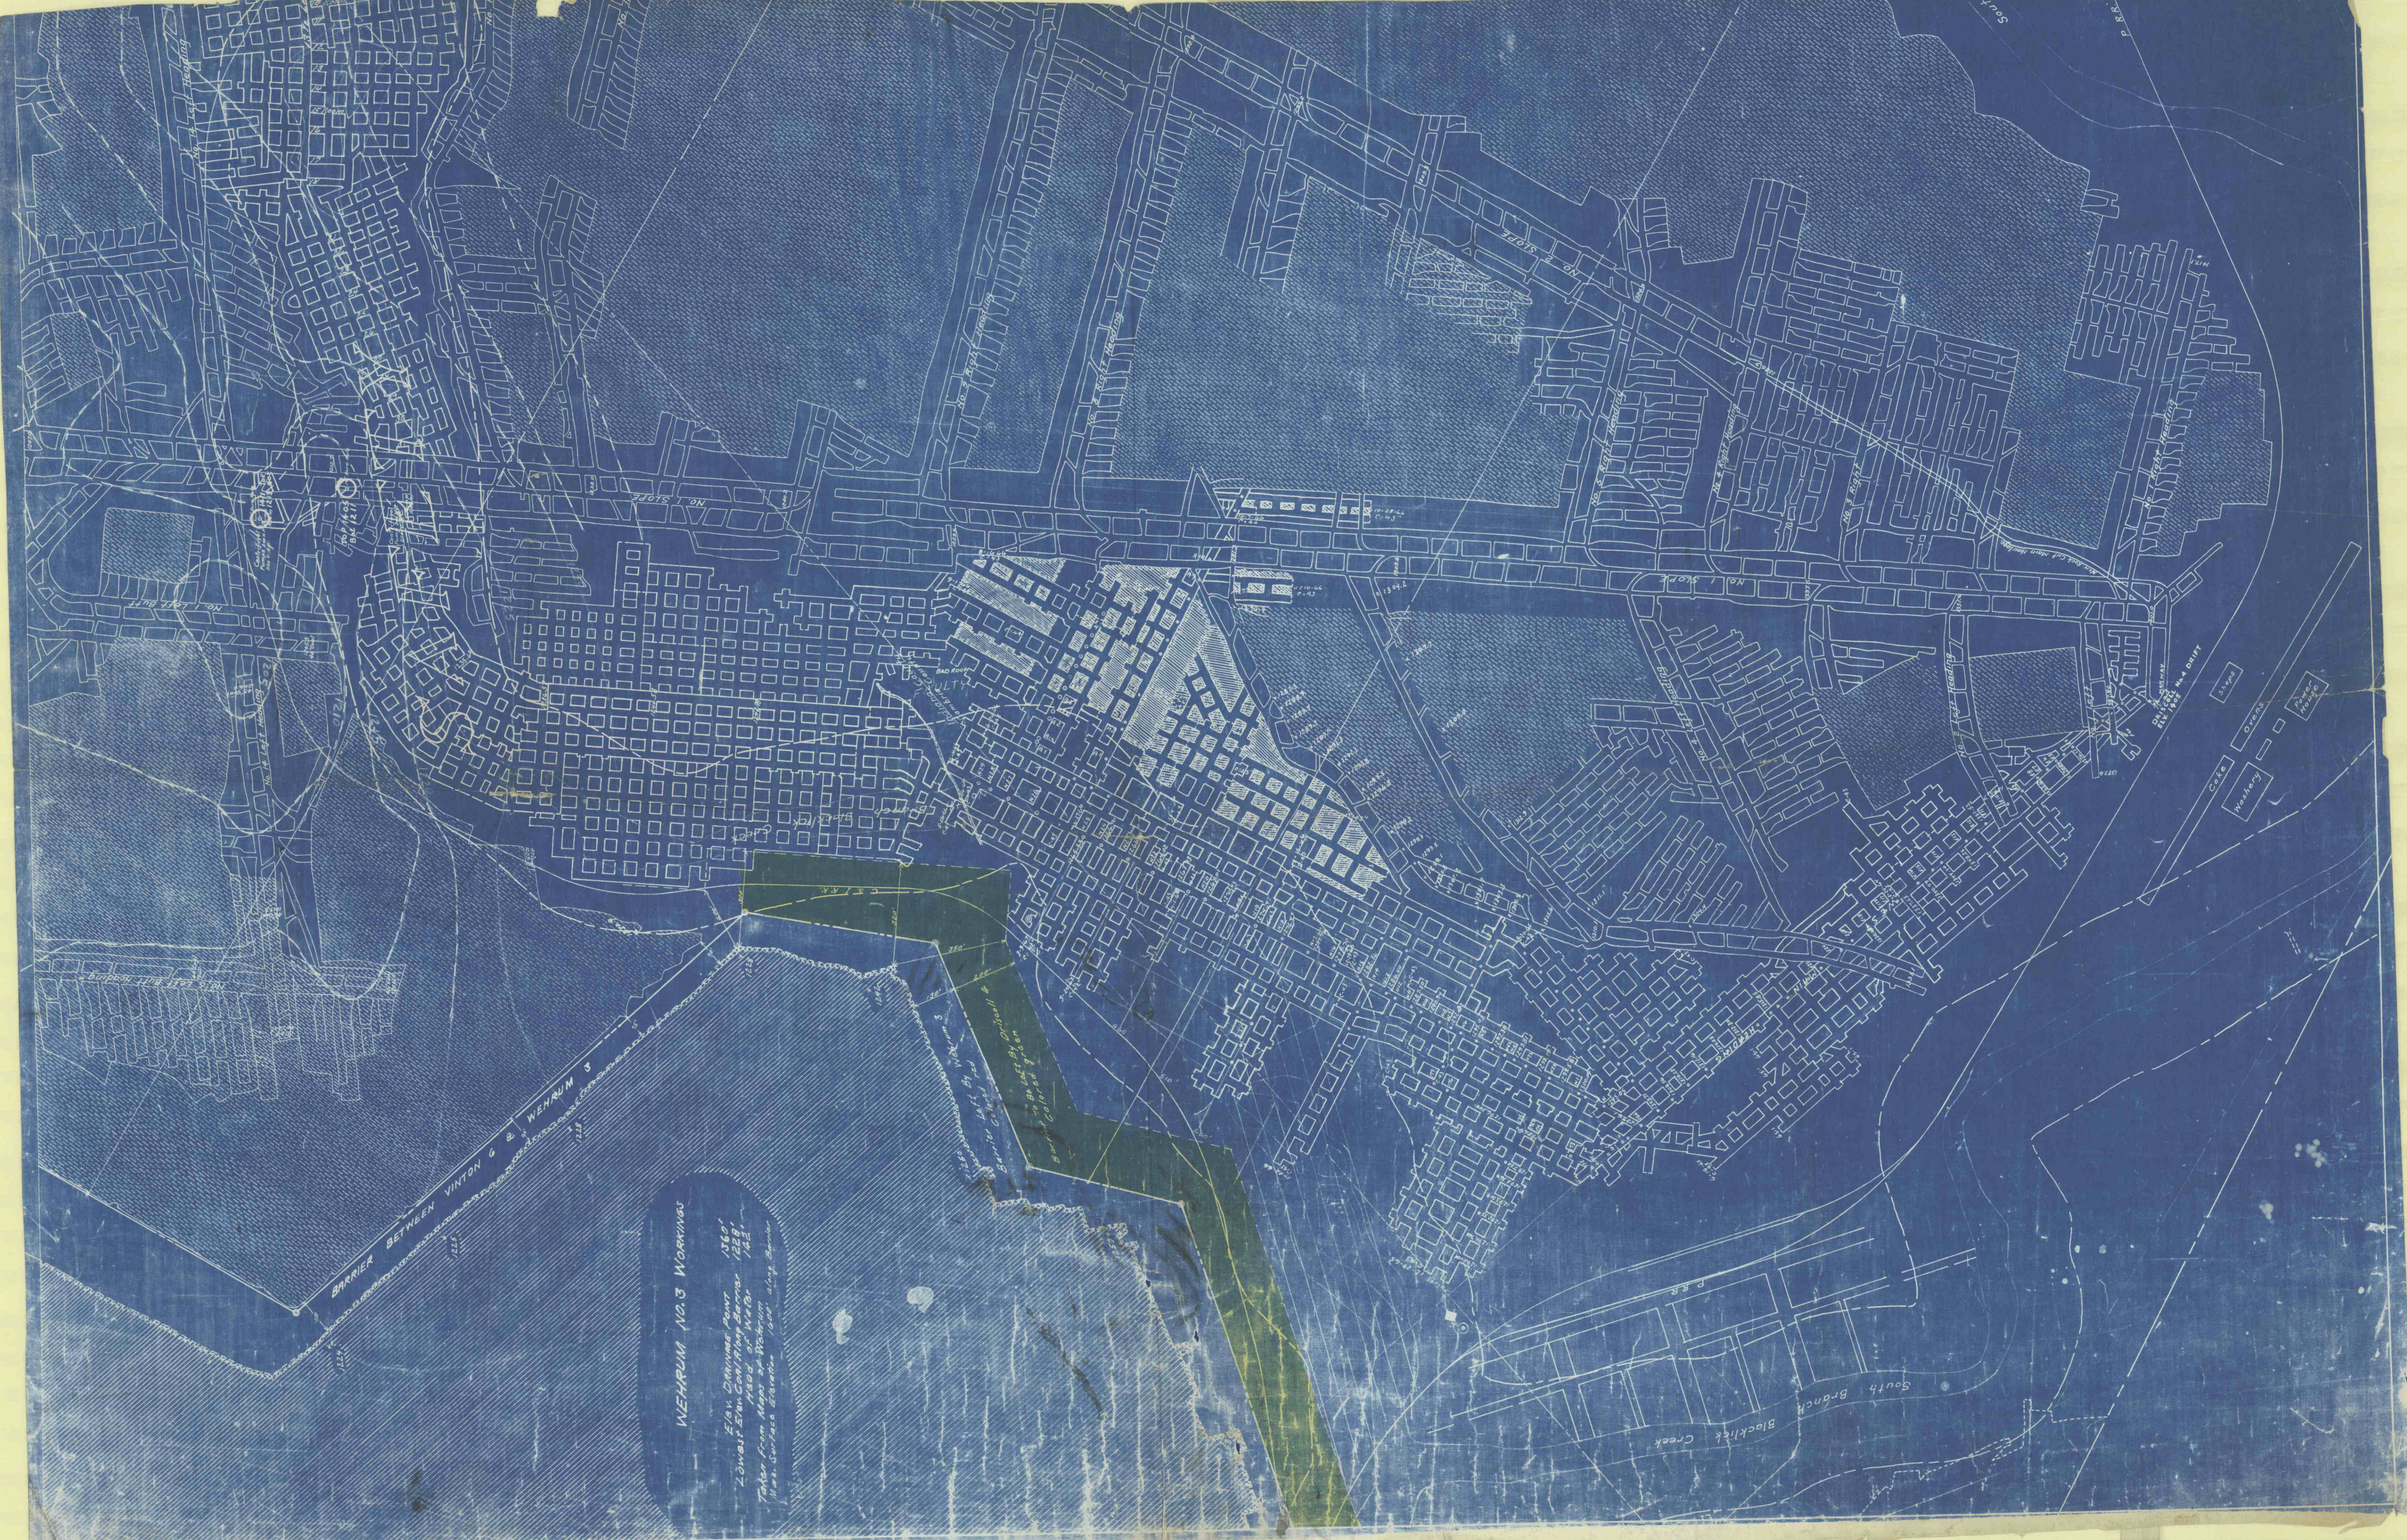

BARRIER BETWEEN VINTON C & WEHRUM 3

WEHRUM NO. 3 WORKINGS
Elev. Difference Point 136.9'
Lowest Elev. Coal Run Barrier 122.9'
Taken from Map of Wehrum
Mar. Surface Elevation 100' along Barrier

Barrier Colored green
to be used by Dr. Hall &
Barrier Colored green

South Branch
Blacklick Creek

Coke
Washery
Power House