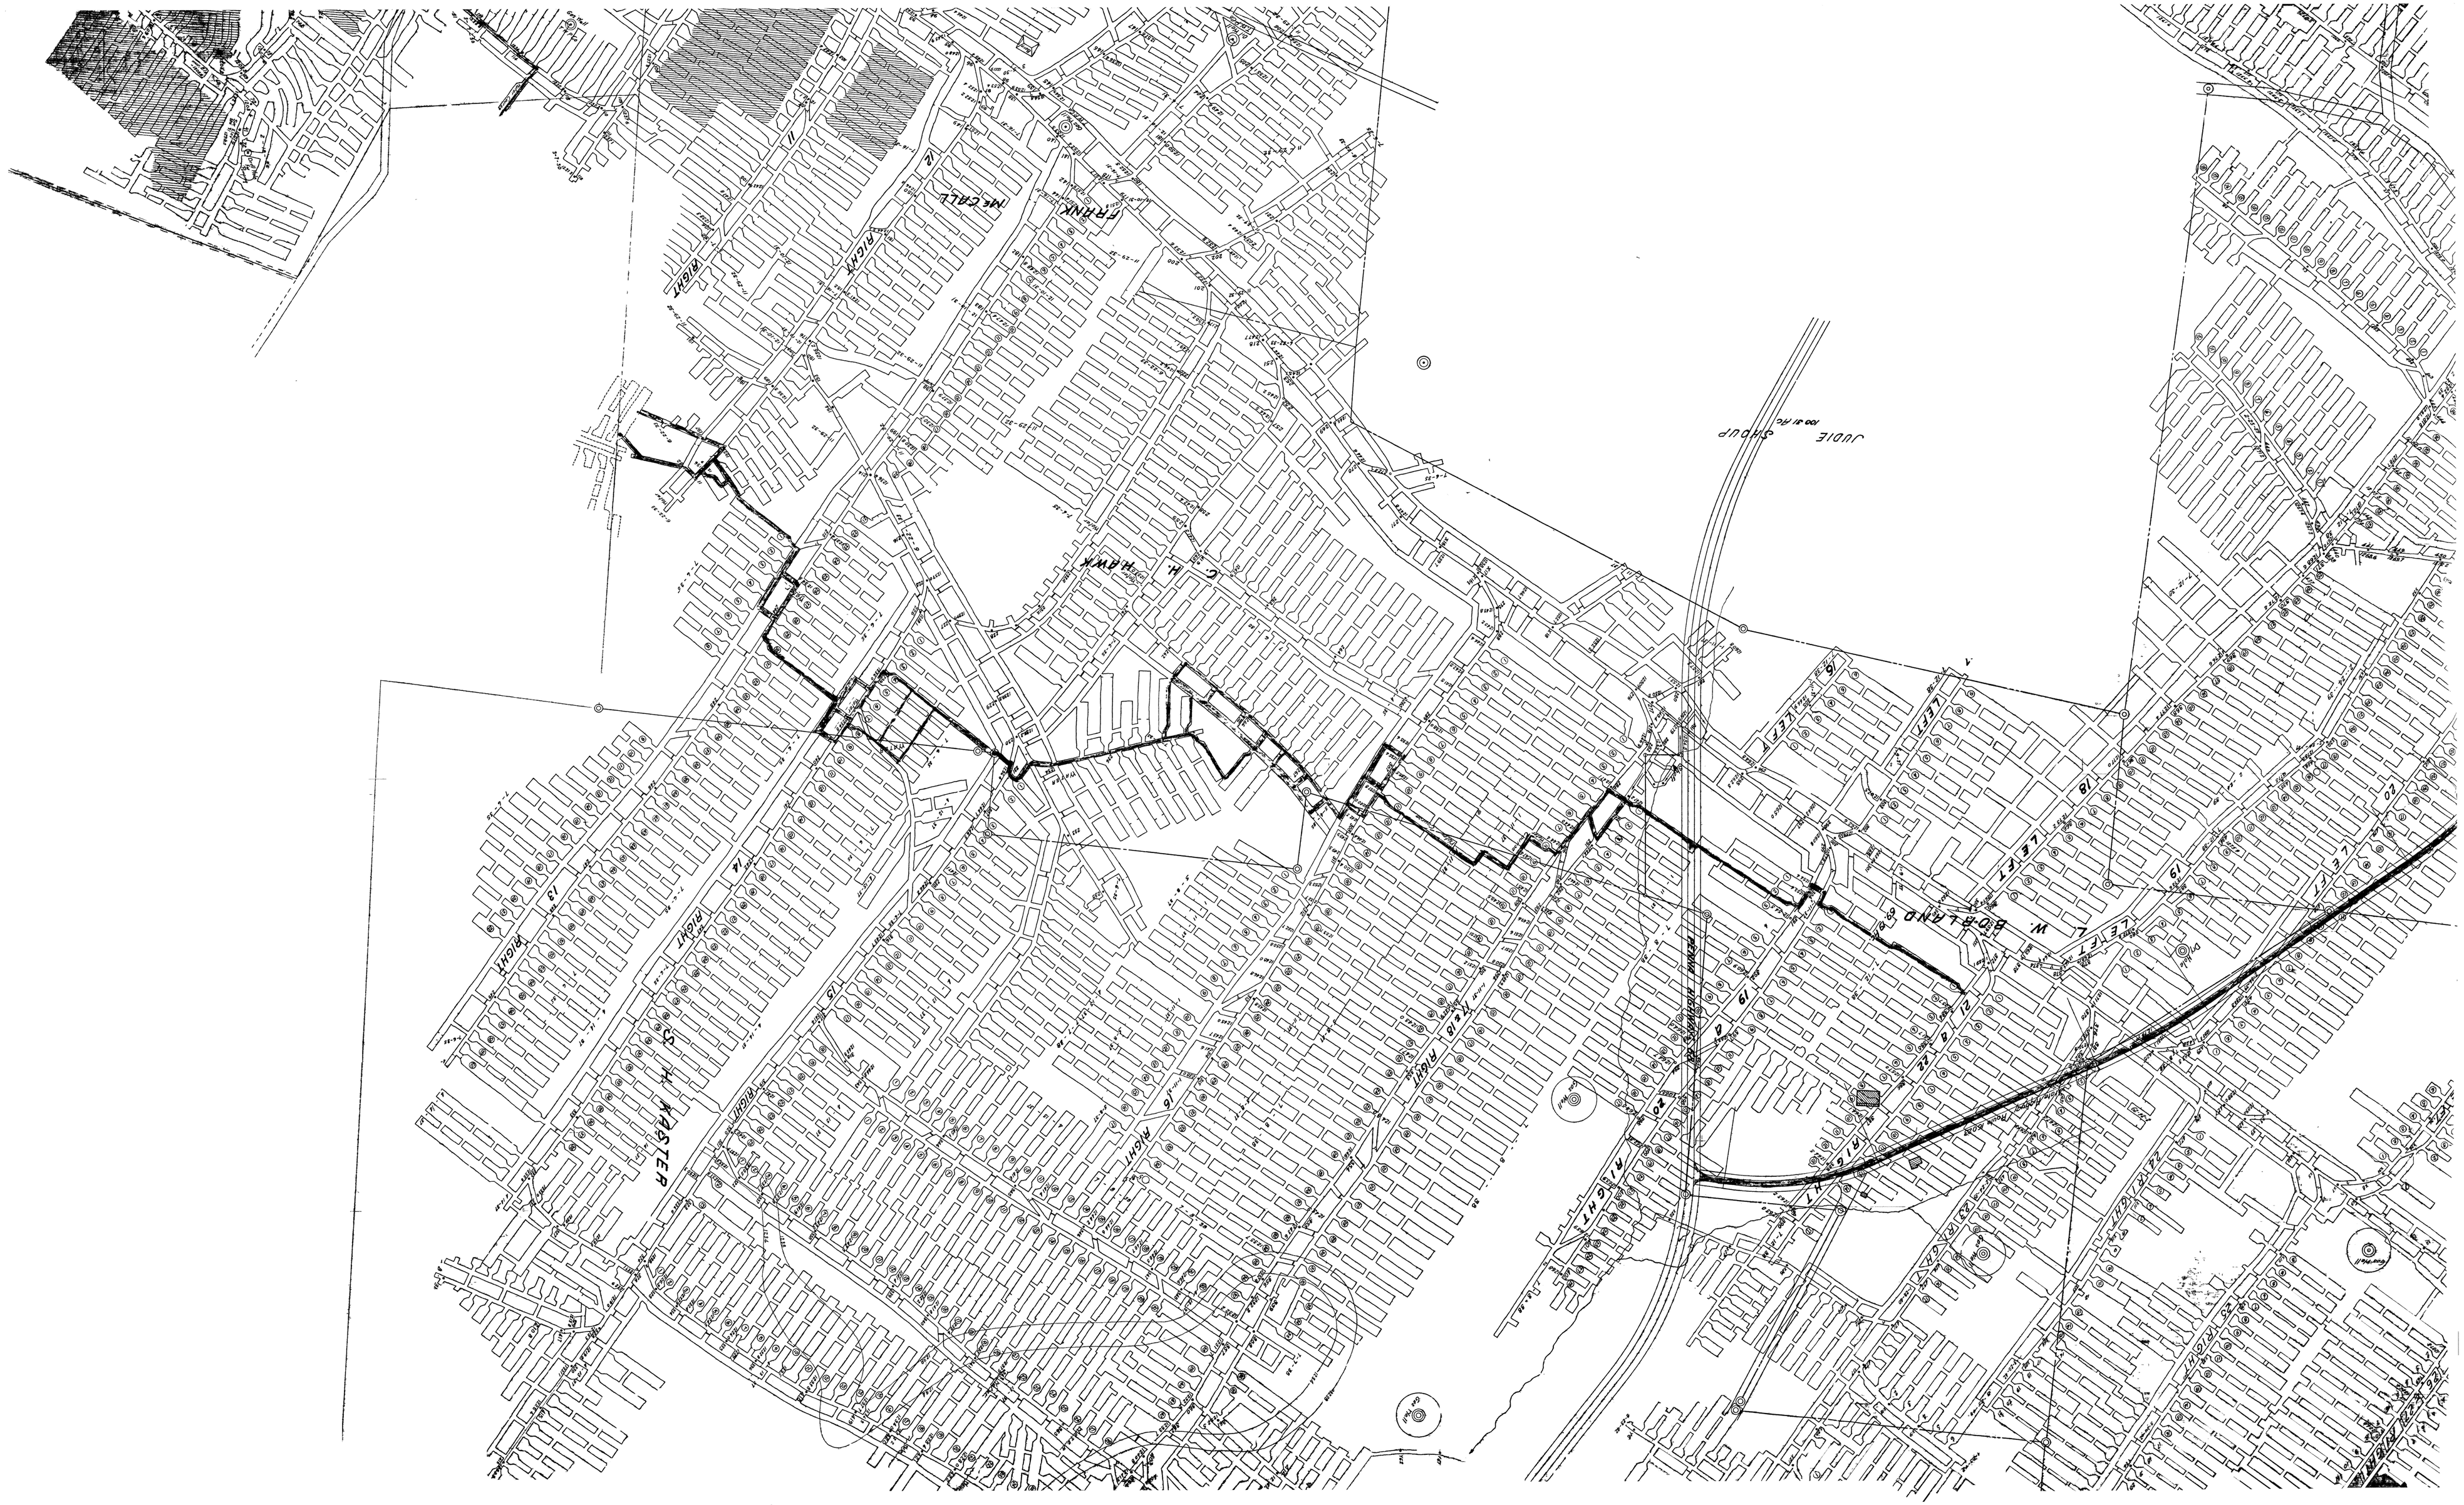

20 LEFT
19 LEFT
18 LEFT
L. W. BORLAND
69.19 Ac.
LEFT
16 LEFT
JUDIE SHOUP
100.31 Ac.
Dry Hole
21 & 22 RIGHT
19 & 20 RIGHT
PENNA HIGHWAY 88
Route 16023
26 & 27 RIGHT
25 RIGHT
24 RIGHT
23 RIGHT
Gas Well
Shaft
17 & 18 RIGHT
16 RIGHT
15 RIGHT
14 RIGHT
13 RIGHT
S. H. KASTER
C. H. HAWK
FRANK McCALL
12 RIGHT
11 RIGHT
Water
Water Course
Gas Well
Drill Hole for Pumping