


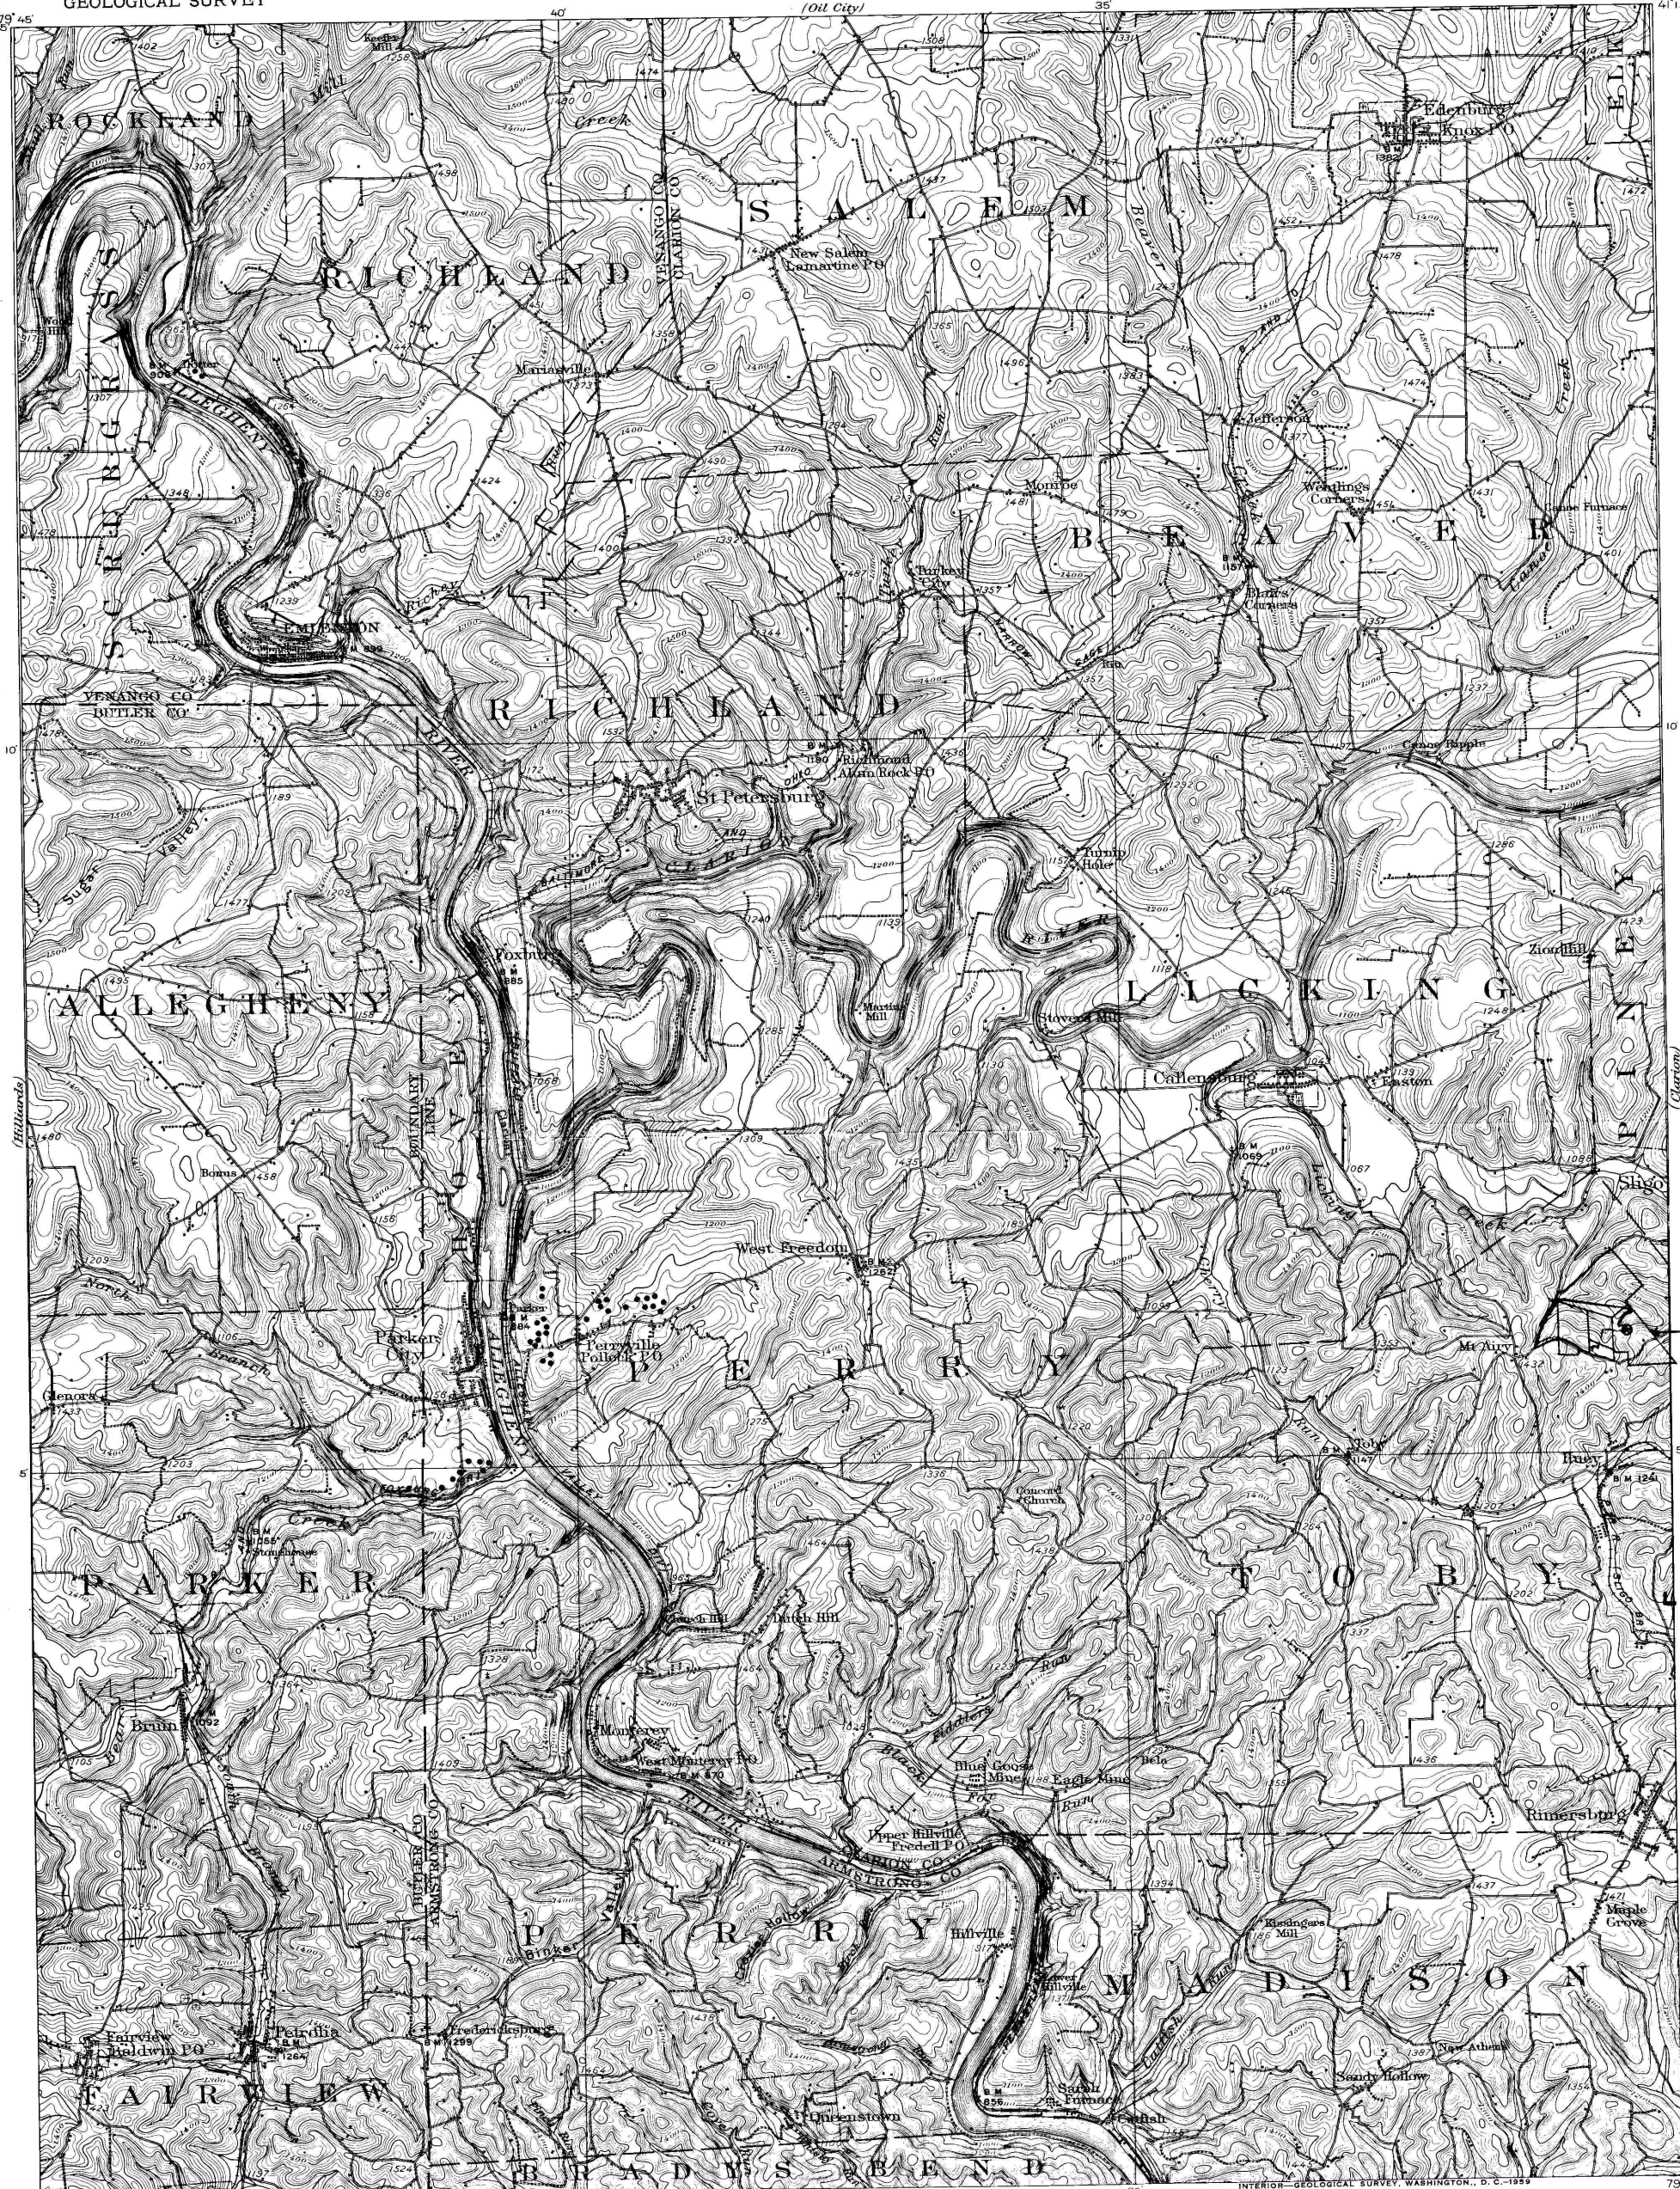


Allison Engineering Co.
October 1966

Allison No. 17 Min

Mary G. Hartman
Harold B. Hartman
Allison Engineering
Charles Shirey
Budd B. Stewart
Properties

Prepared by
L. S. TAYLOR ENGINEERING
Clarion, Pennsylvania

Frank Sutton, Geographer in charge.
Topography by R. D. Cummin, R. H. Reineck, and E. W. McCrary.
Control by E. L. McNair and C. G. Anderson.
Surveyed in 1905-1907.

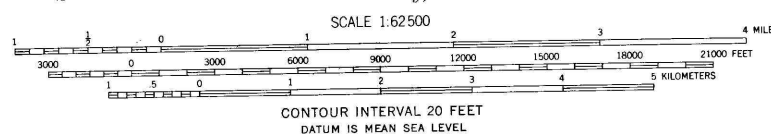

**TOBY TOWNSHIP
CLARION COUNTY
PERMIT NUMBER-147-1
"B"-OR LOWER KITTANNING SEAM**

FOR SALE BY U. S. GEOLOGICAL SURVEY, WASHINGTON 25, D. C.
A FOLDER DESCRIBING TOPOGRAPHIC MAPS AND SYMBOLS IS AVAILABLE ON REQUEST

FIELD COPY
L. S. TAYLOR ENGINEERING
Post Office Box 311
Clarion, Pennsylvania

PA
FOXBURG
N4100-W7930/15
1907