


DEPARTMENT
AUDITOR GENERAL
of the
State of Pennsylvania
This is the Property

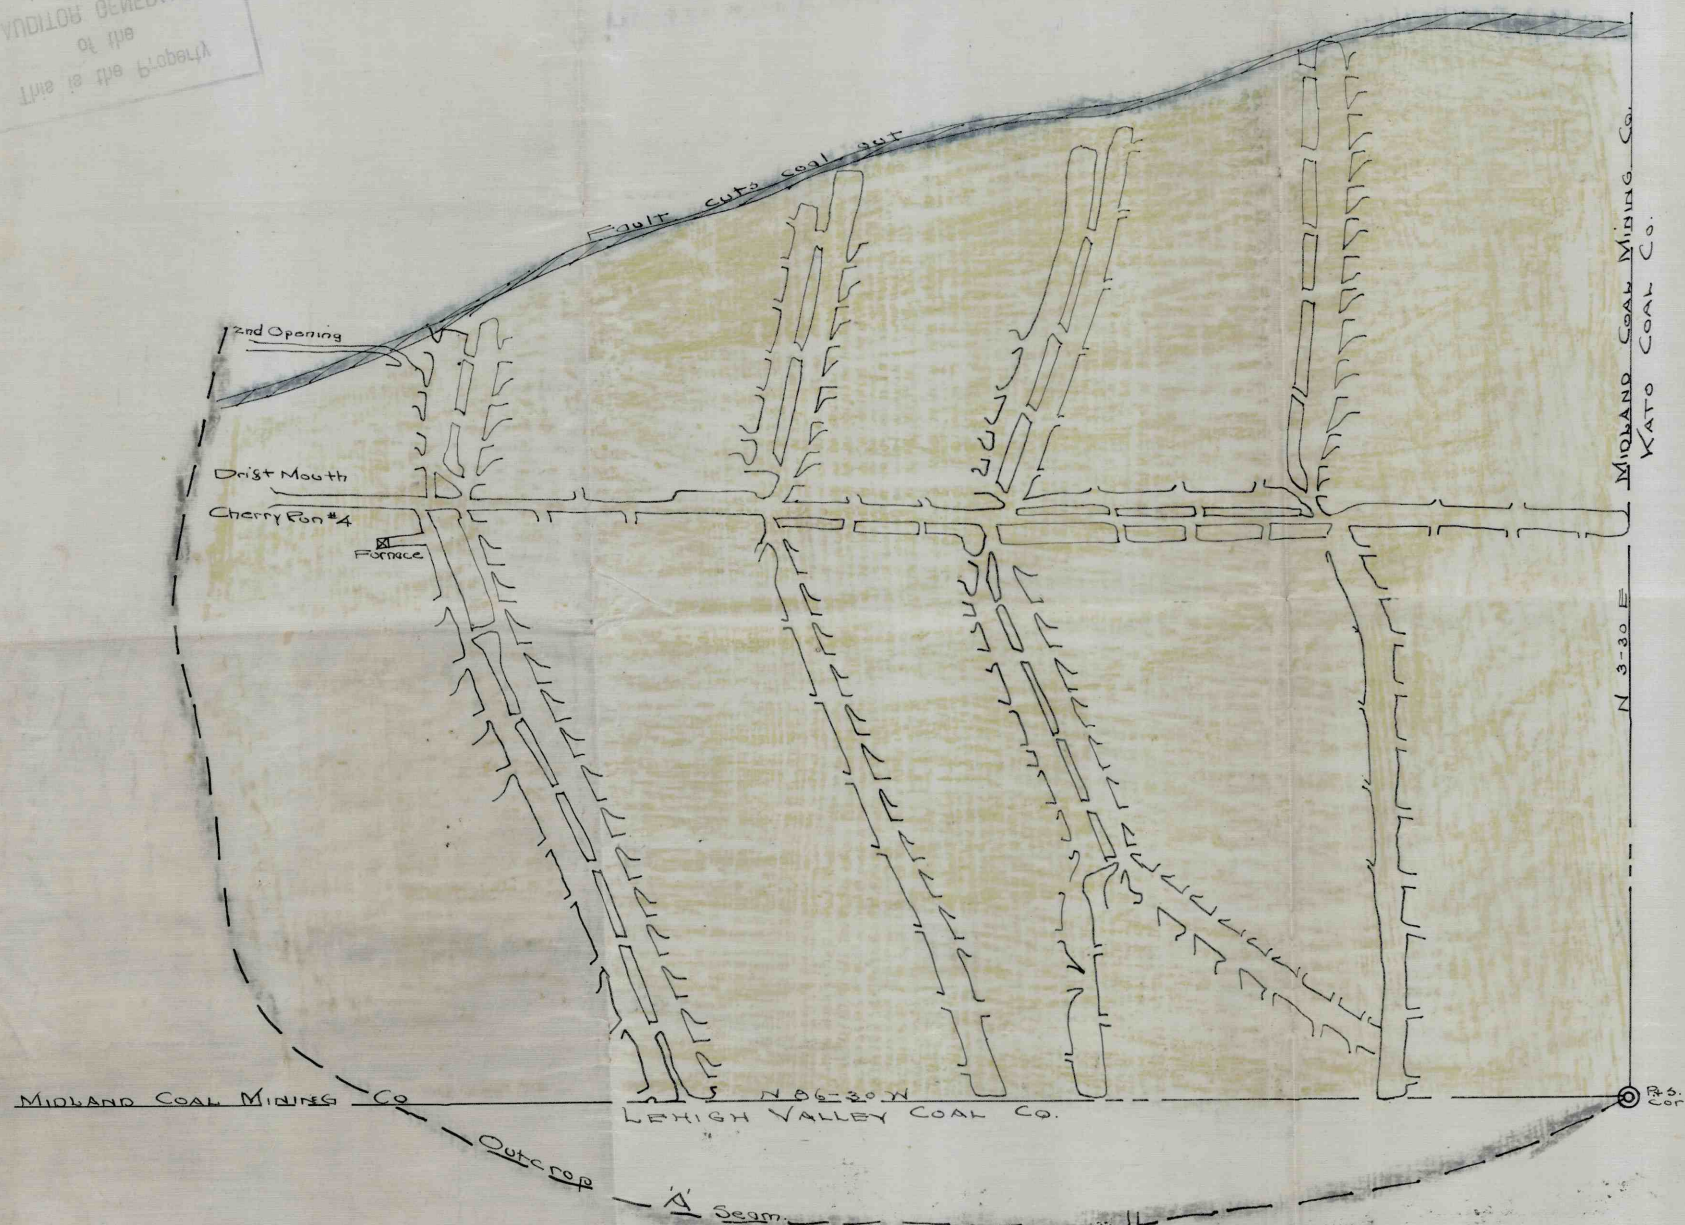

Map of CHERRY RUN NO. 4 MINE
Operated by BIG SANDY COAL CO.
Leased from Midland Coal Mining Co.
Located in Snow Shoe Twp. CENTRE Co., PA.
Scale 1 inch = 100 feet.
Legend
Outcrop shown in black
Fault shown in blue
Worked out area shown in yellow

#521
6-24-99
C.C.