


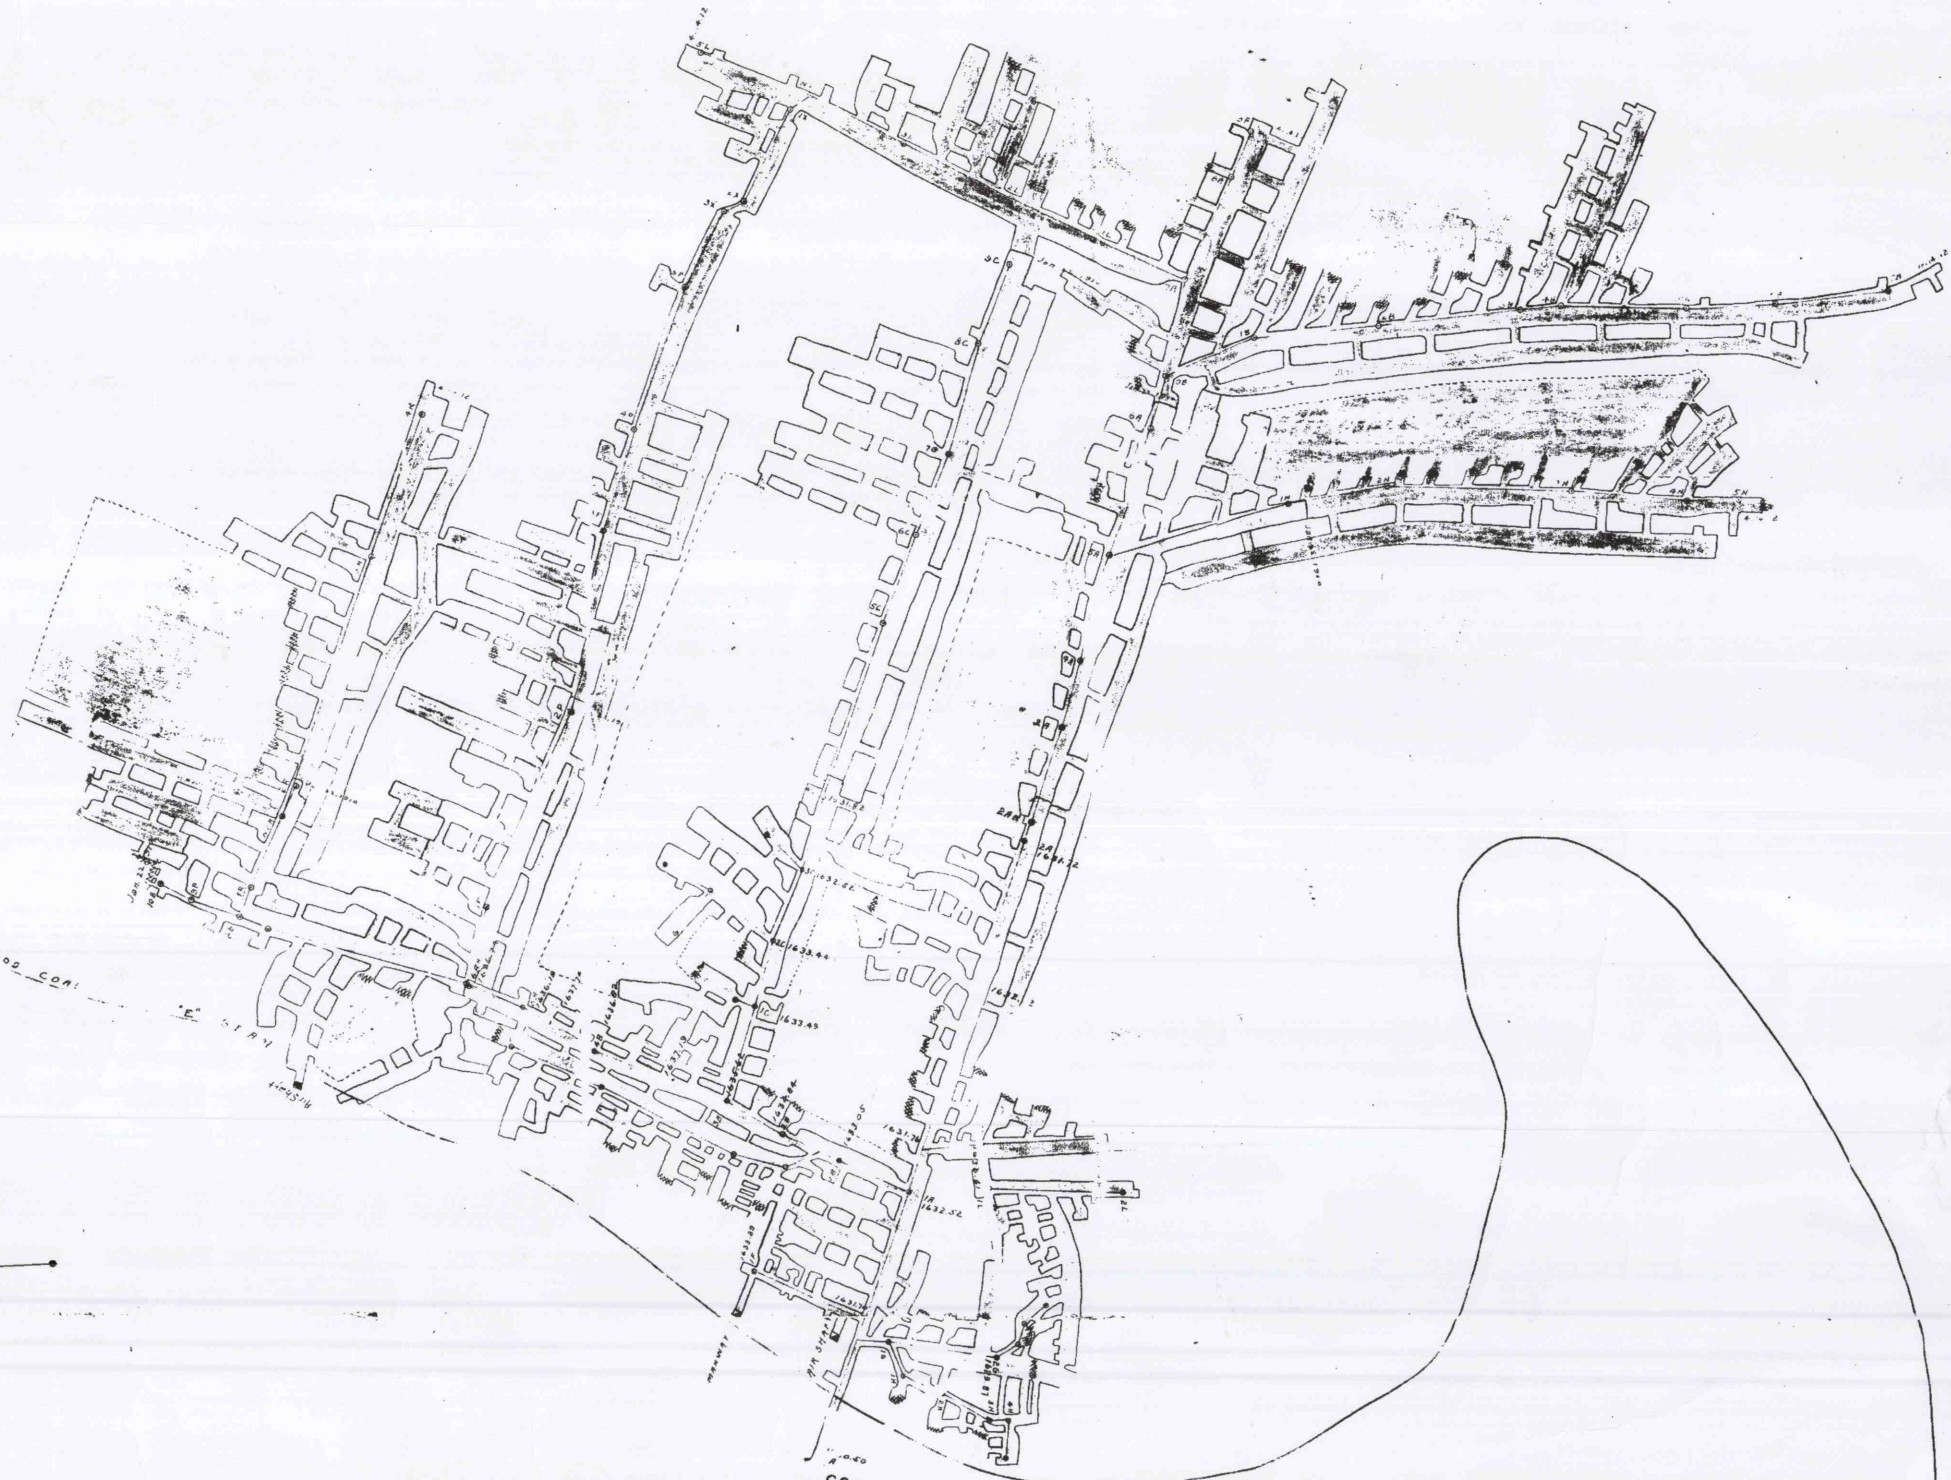

MAP OF
CROSS KEYS MINE,
West Moshannon Clearfield, Co. Pa.

Scale 1"=100'

1908

H.W. Loran,
Engineer.

TOWNSHIP ROAD

DRIFT ON MOSHANNON
TUNNEL TO TIPPLE
1673-73

to Northside