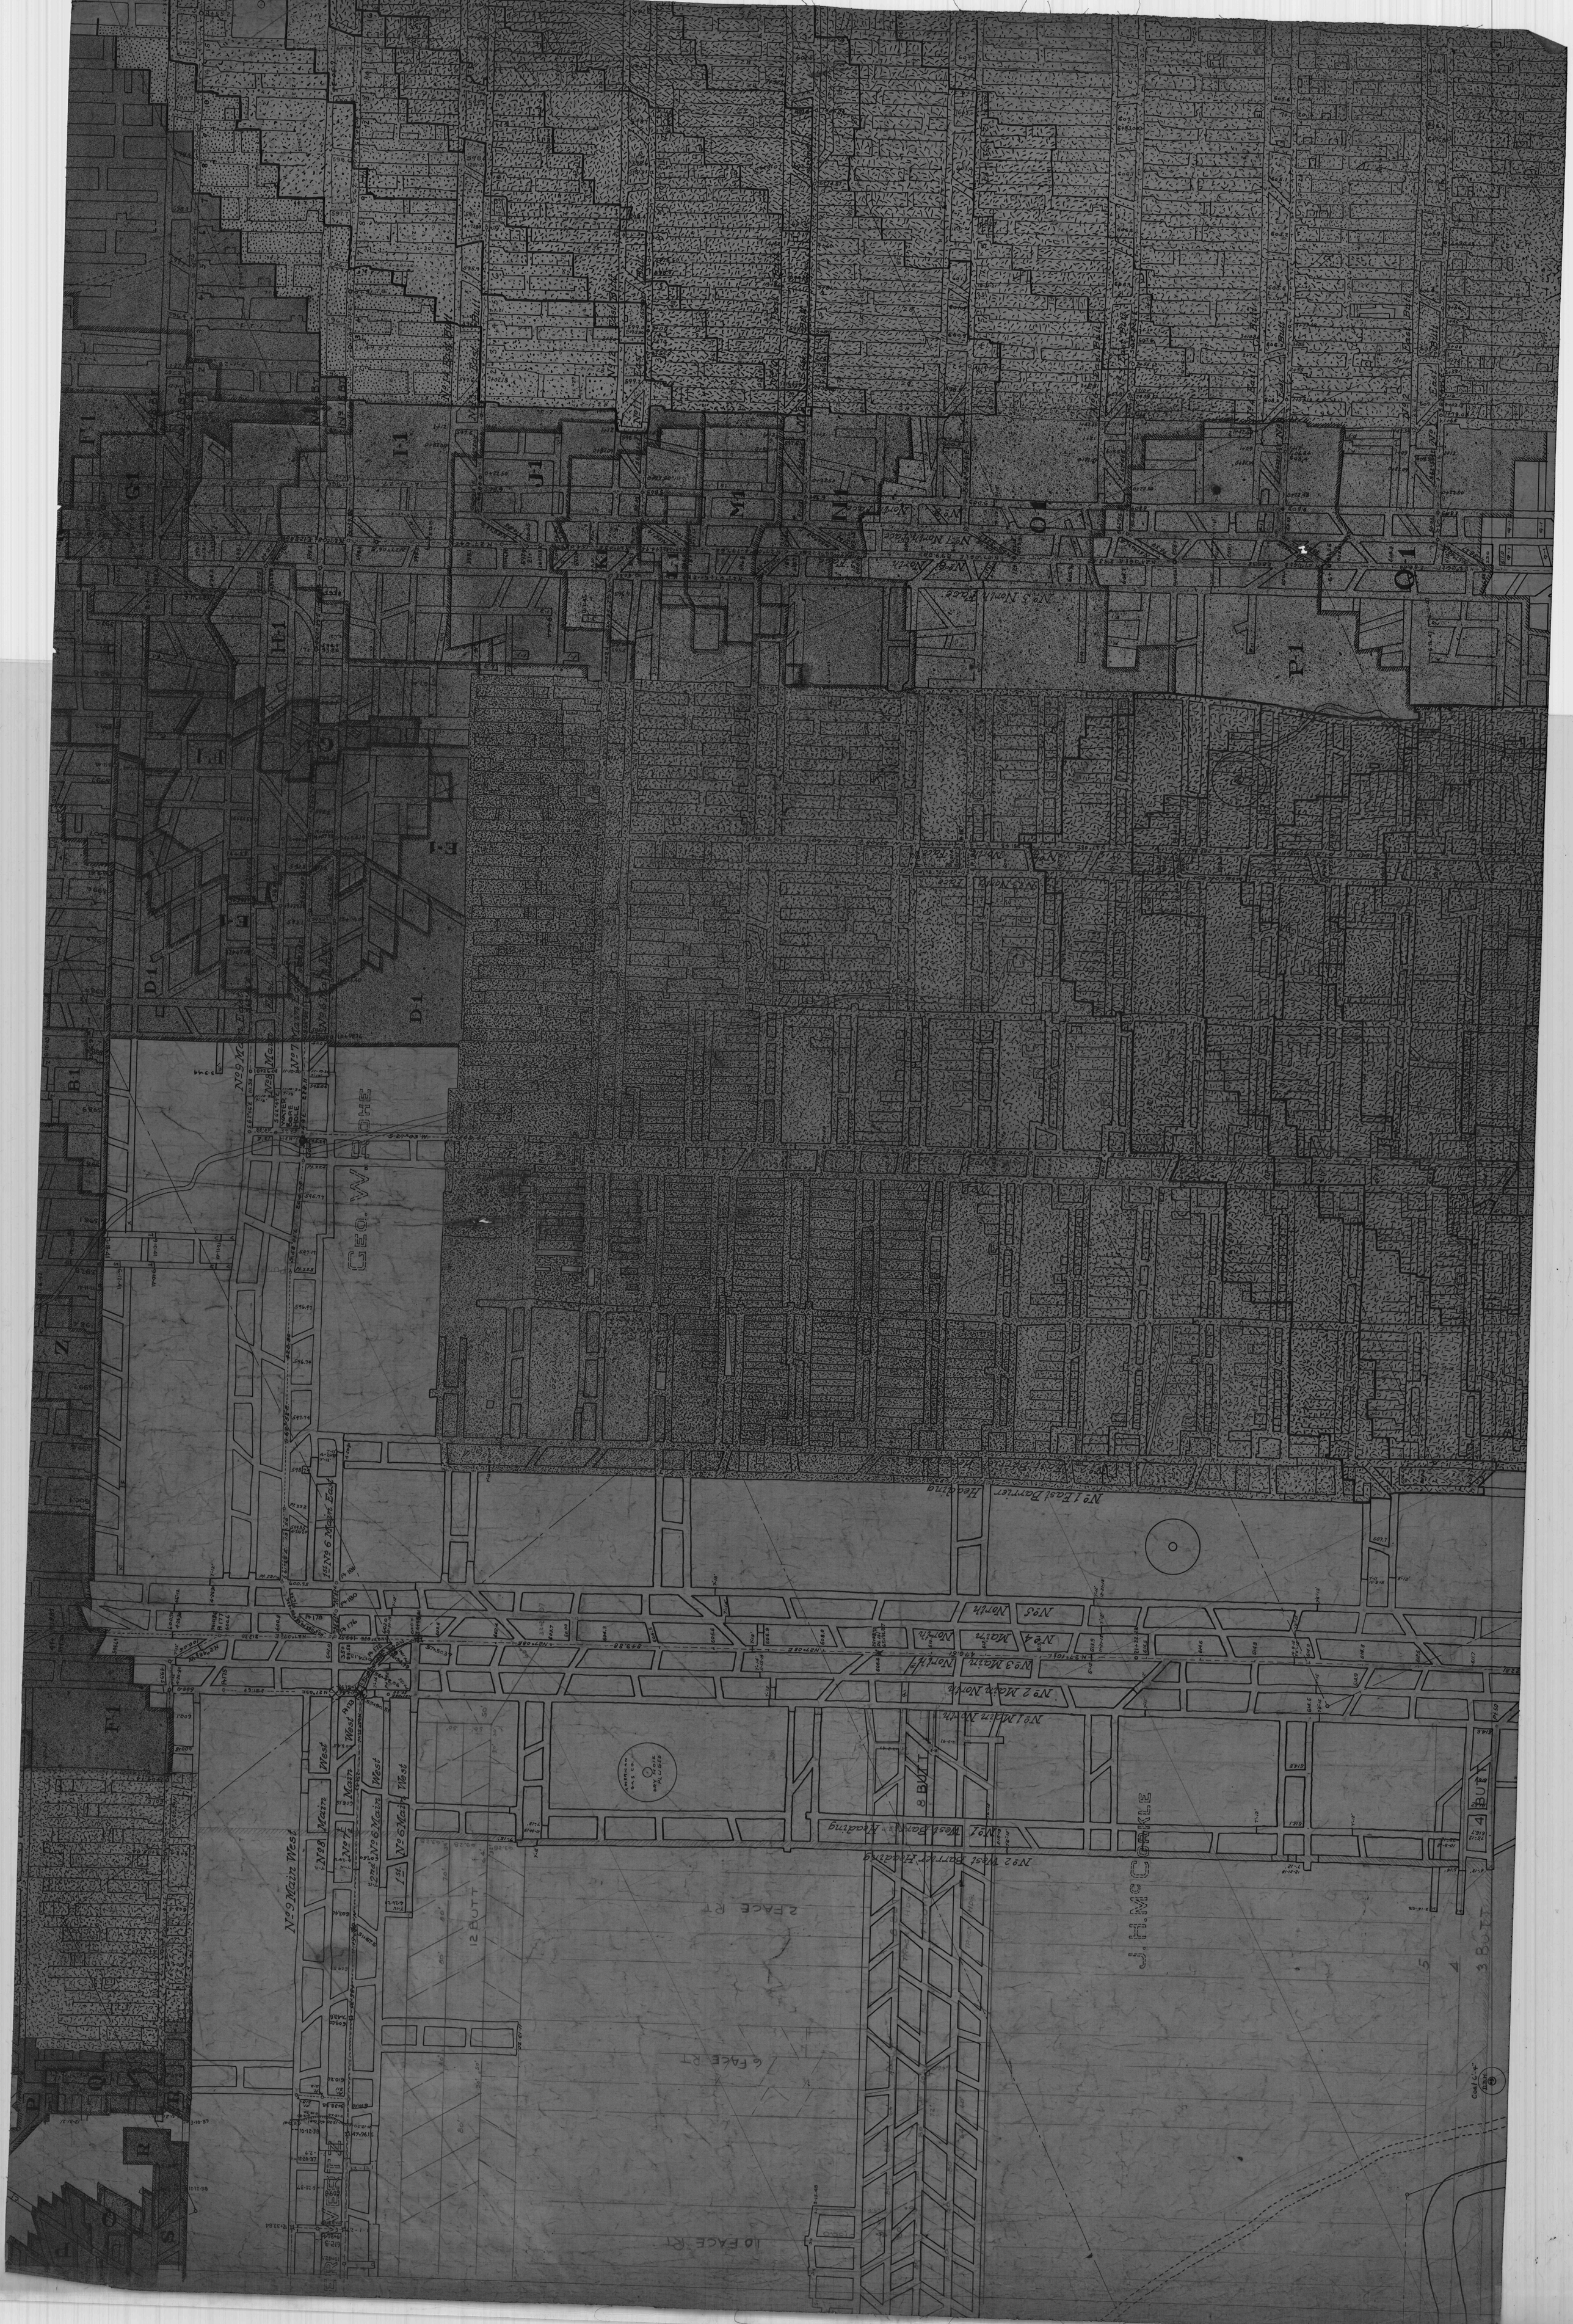

No 1 East Barrier Heading
No 2 Main North
No 3 North
No 4 Main North
No 5 North
No 1 Main North
No 2 West Barrier Heading
No 1 West Barrier Heading
No 9 Main West
No 8 Main West
No 7 Main West
No 6 Main West
1st
2nd
No 6 Main East
No 5 North
No 4 North
No 3 Main North
No 2 Main North
No 1 Main North
No 1 East Barrier Heading
No 2 Main North
No 3 Main North
No 4 Main North
No 5 North
No 6 Main East
No 7 Main East
No